

WAL WORTH COUNTY SURVEYING & MAPPING LAKE GENEVA, WISCONSIN 414-248-0505

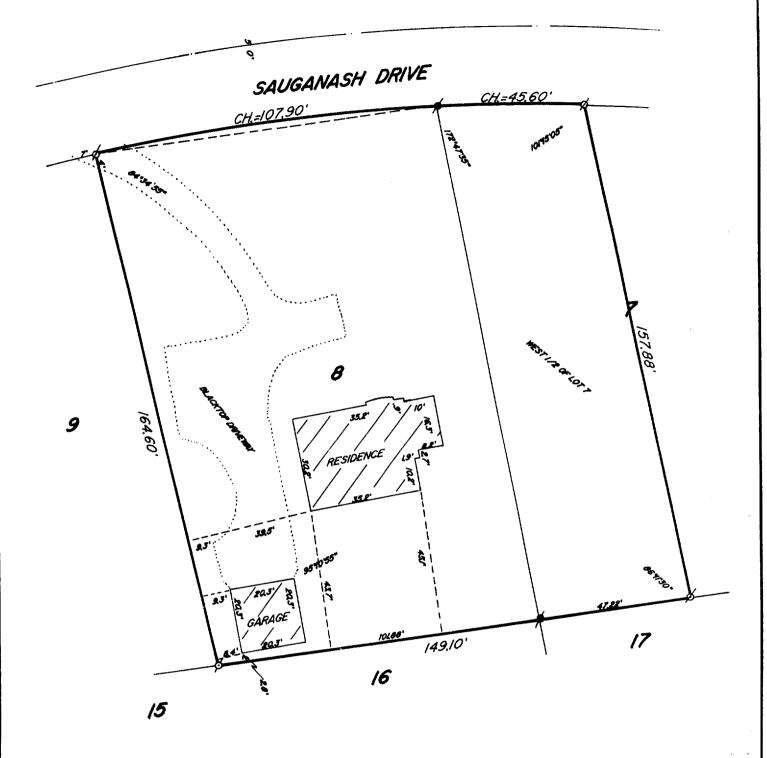

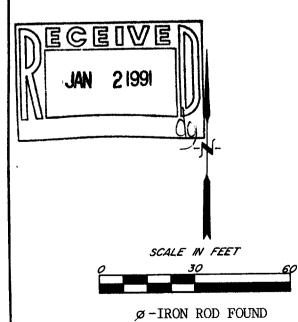

■-CONCRETE MONUMENT FOUND

()-RECORDED AS

PLAT OF SURVEY OF

LOT 8 AND THE WEST 1/2 OF LOT 7 IN COUNTRY CLUB ESTATES UNIT NO. 2, LOCATED IN THE VILLAGE OF FONTANA-ON-GENEVA LAKE, WALWORTH COUNTY, WISCONSIN.

ORDERED BY: COLDWELL BANKER

GENEVA LAKES AREA REALTORS

838 MAIN STREET

LAKE GENEVA, WISCONSIN

147

IMERIES' GERTIFY THAT I HAVE SURVETED THE ABOVE DESGREED PROFERTY AND THAT THE ABOVE MAP IS A TRUE REPRESENTATION THEREOF AND SHOWS THE SIZE AND LOCATION OF THE PROPERTY, ITS EXTERNOR BOUNDARYS. THE LOCATION OF ALL MISBLE STRUCTURES AND DIMENSIONS OF ALL PRINCIPAL BUILDINGS THEREON, BOUNDARY FENCE APPARENT EASEMENTS AND ROADWAYS AND VISIBLE ENCROACHMENTS, IF ANY, TO THE

THIS SURVEY IS MADE FOR THE USE OF THE PRESENT DIMERS OF THE PROPERTY AND ALSO THOSE WHO PURCHASE, MORTBAGE OR GUARANTEE THE TITLE THERETO WITHOUT AND ALTERISE.

ROBERT IN BALLAMO SURVEYOR S-1508

JUL. 13, 1889

NOTE: 1745 IS NOT A CONTINED COPY UNLESS SEALED.