


13-1-15

J. C. SHEELS

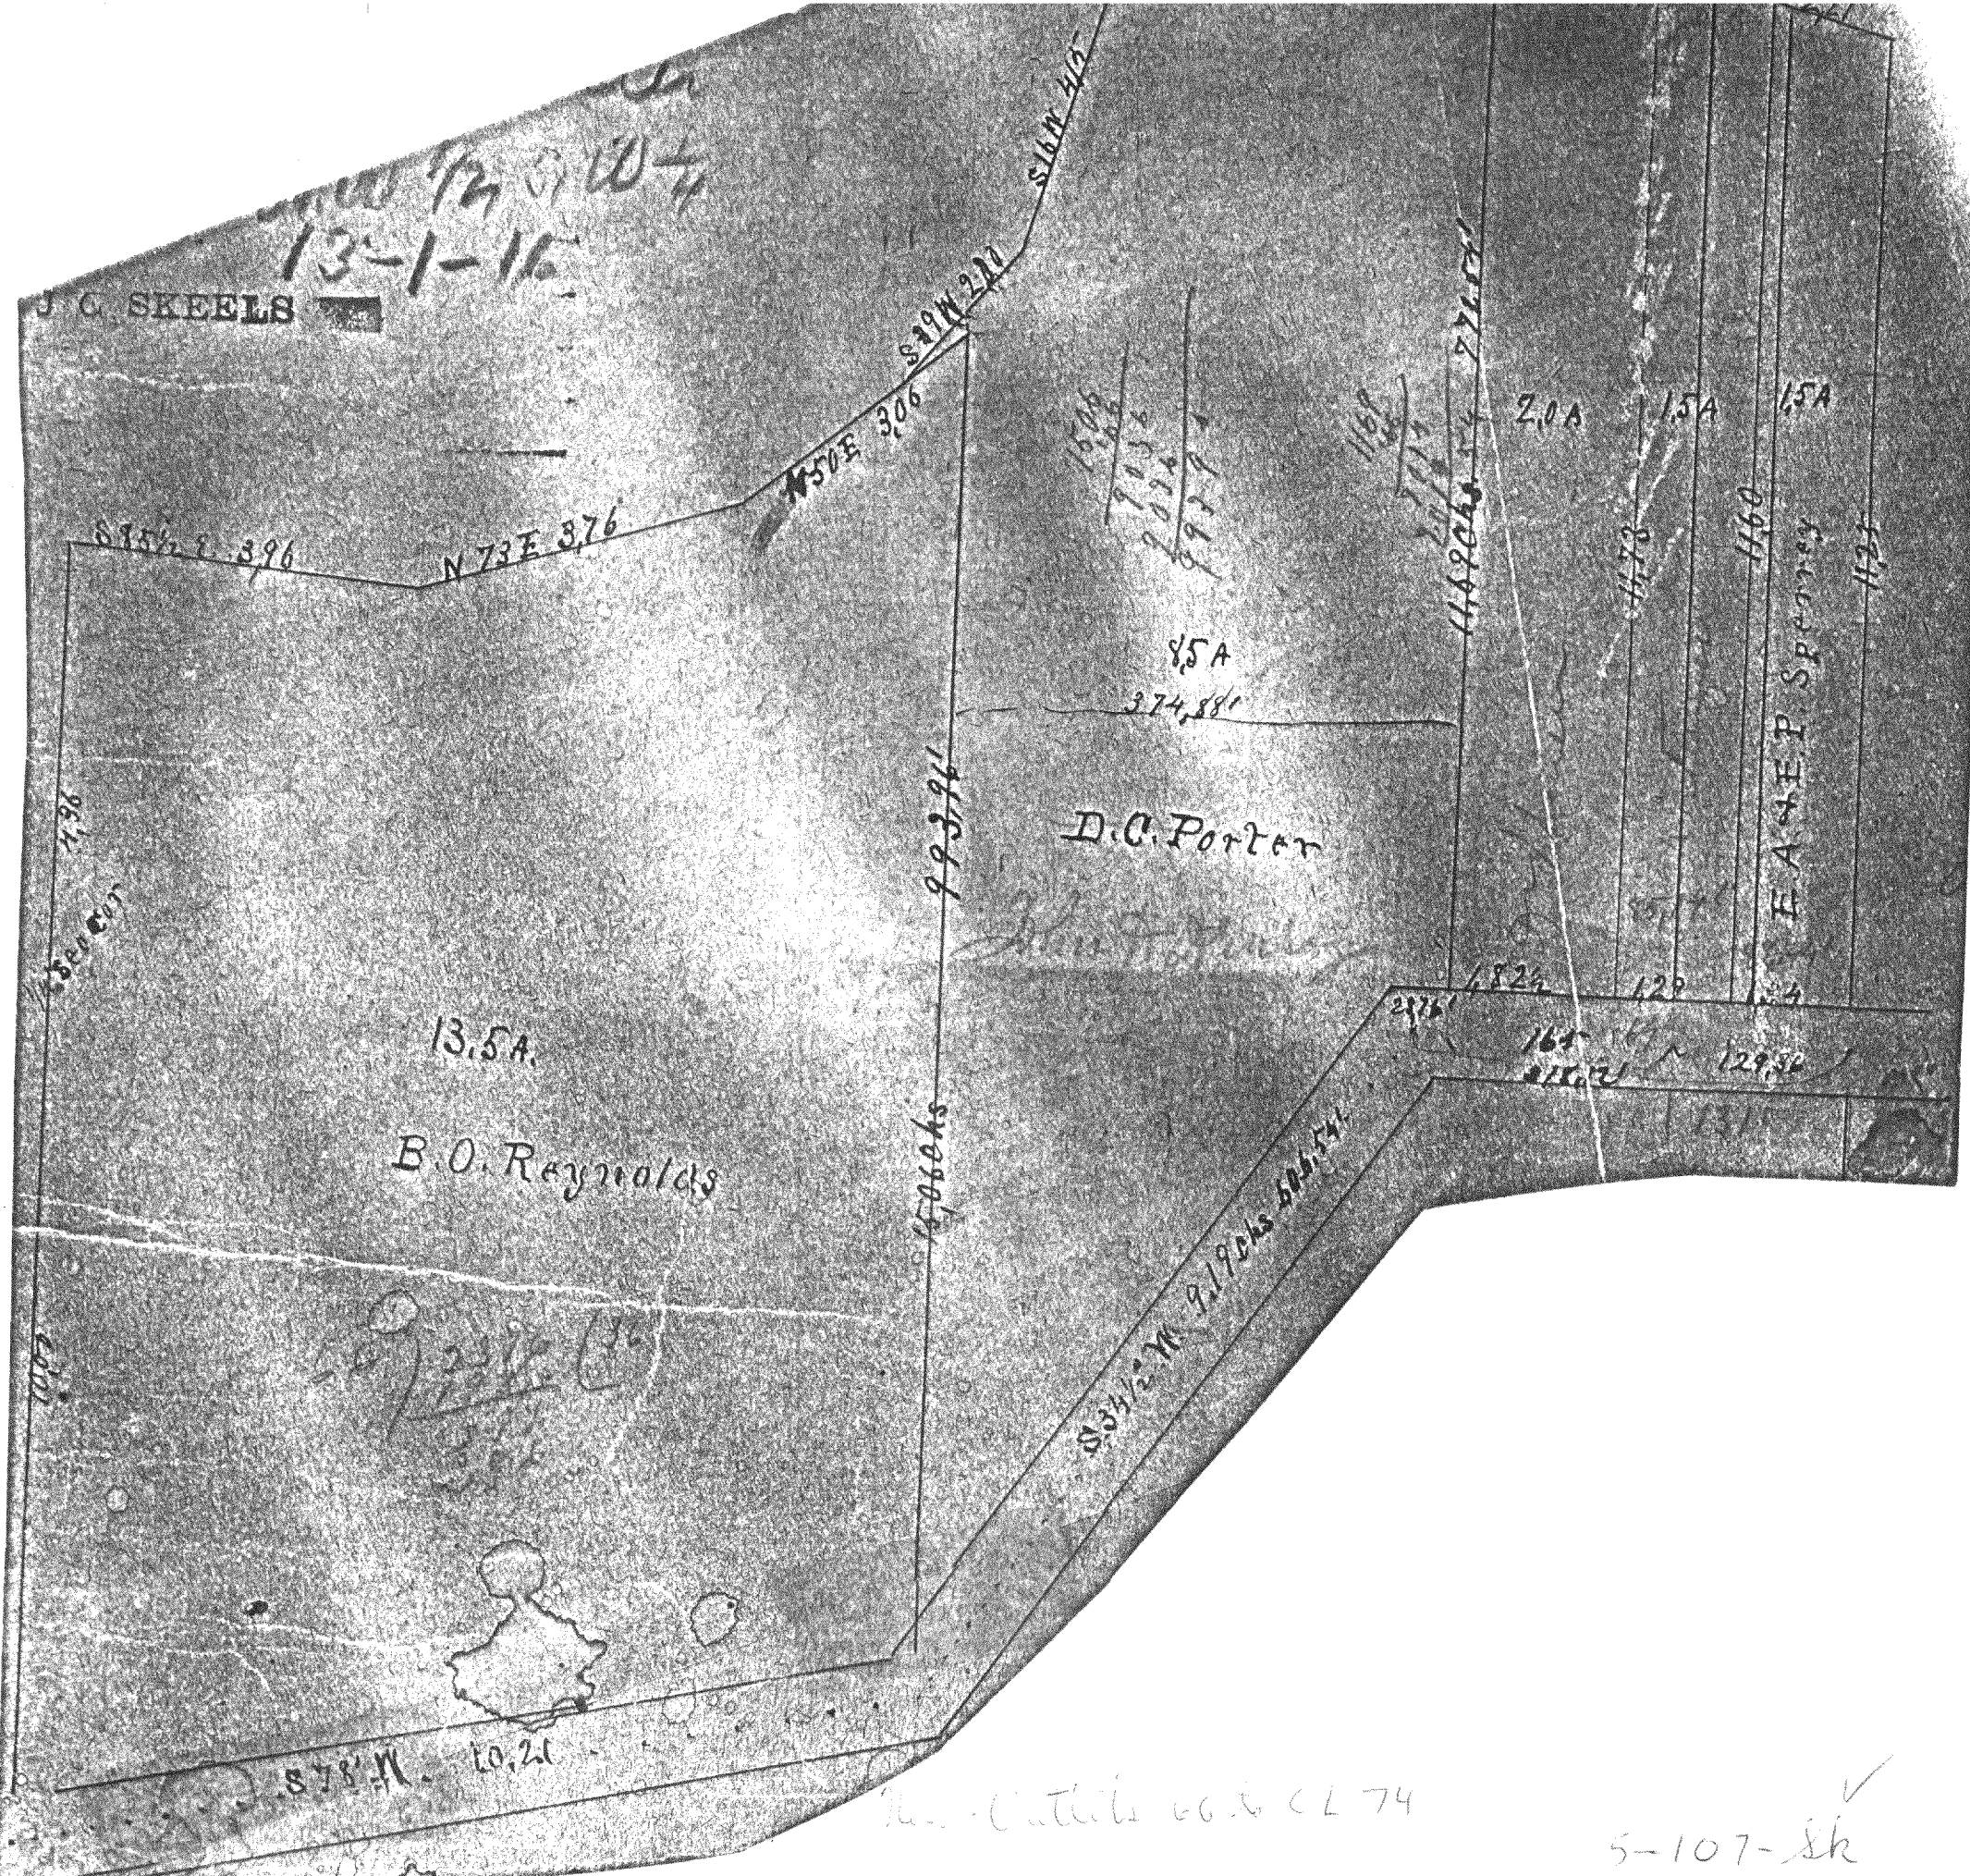

See Cattle Co. & CL 74

5-107-sh ✓