
ABELL SURVEYING & MAPPING DELAVAN, WISCONSIN 53115 414-728-6737

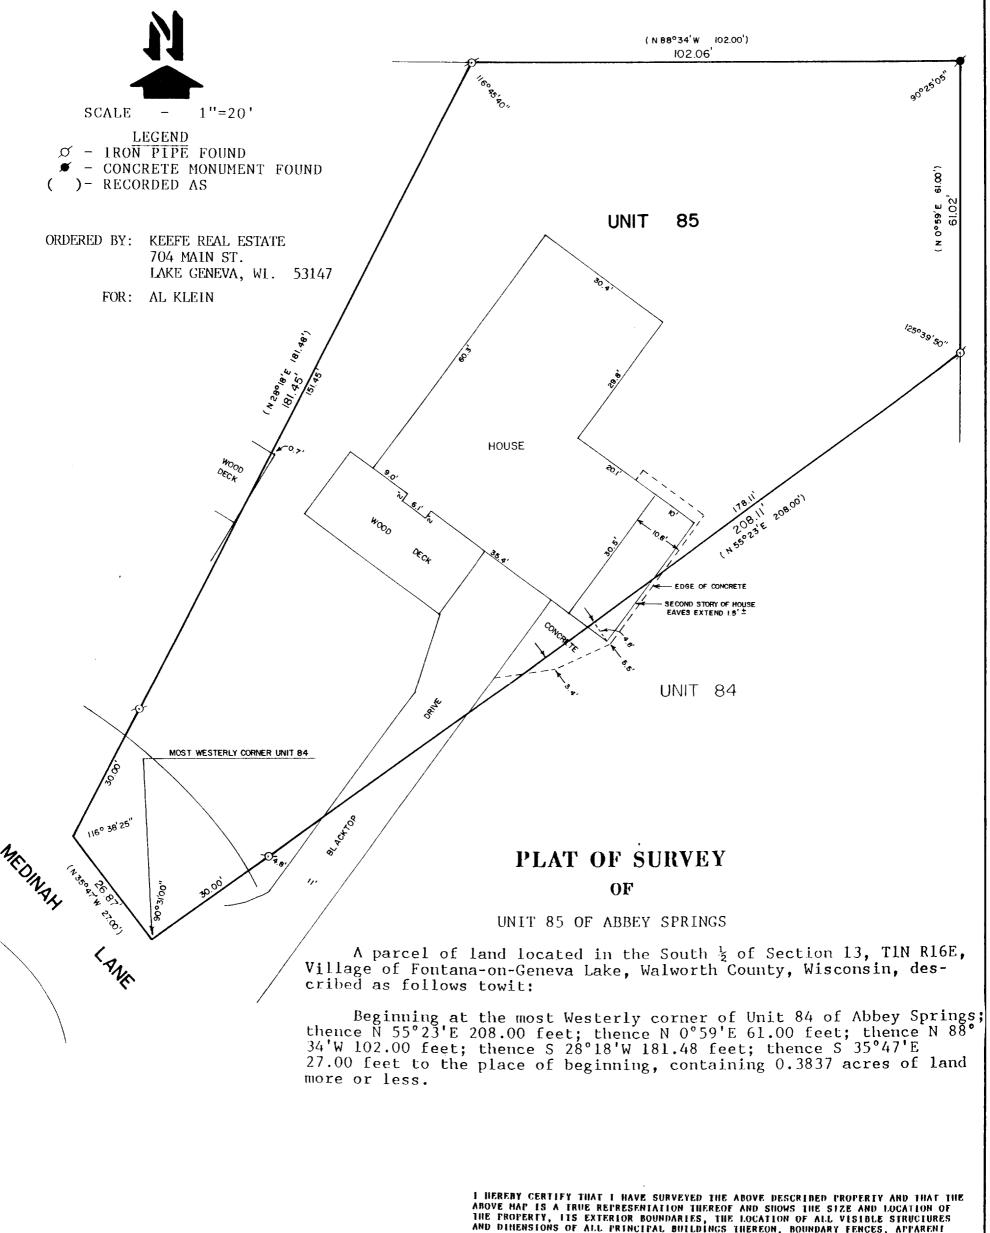

DEC | 8 1990

ABOVE HAP IS A TRUE REPRESENTATION THEREOF AND SHOWS THE SIZE AND LOCATION OF THE PROPERTY, ITS EXTERIOR BOUNDARIES, THE LOCATION OF ALL VISIBLE STRUCTURES AND DIMENSIONS OF ALL PRINCIPAL BUILDINGS THEREON, BOUNDARY FENCES, APPARENT EASEMENTS, ROADWAYS AND VISIBLE ENCROACHMENTS, IF ANY, TO THE BEST OF MY KNOWLEDGE AND BELIEF.

THIS SURVEY IS MADE FOR THE USE OF THE PRESENT OWNERS OF THE PROPERTY, AND ALSO THOSE WHO PURCHASE, MORICAGE, OR GUARANTEE THE TITLE THERETO WITHIN ONE (1) YEAR FROM DATE HEREOF.

WISCONSIN REGISTERED LAND SURVEYOR, S-1596

DATE <u>Sept. 24, 1990</u>

JOB NUMBER - 90185

NOTE: THIS IS NOT A CERTIFIED COPY UNLESS SEALED.

DD5-1083