
ABELL SURVEYING & MAPPING DELAVAN, WISCONSIN 53115 414-728-6737



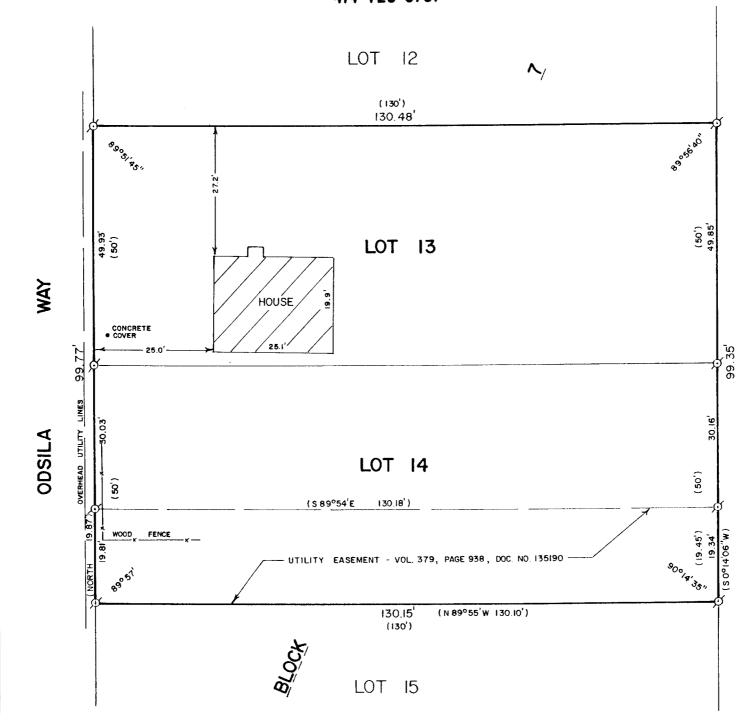

SCALE - 1"=20'

LEGEND

O - IRON PIPE FOUND

()- RECORDED AS

ORDERED BY: KEEFE I

KEEFE REAL ESTATE

704 MAIN ST.

LAKE GENEVA, WI. 53147

PLAT OF SURVEY OF

LOTS 13 AND 14, BLOCK 7, INDIAN HILLS 1st ADDITION, LOCATED IN THE VILLAGE OF FONTANA-ON-GENEVA LAKE, WALWORTH COUNTY, WISCONSIN.



I HEREBY CERTIFY THAT I HAVE SURVEYED THE ABOVE DESCRIBED PROPERTY AND THAT THE ABOVE MAP IS A TRUE REPRESENTATION THEREOF AND SHOWS THE SIZE AND LOCATION OF THE PROPERTY, ITS EXTERIOR BOUNDARIES, THE LOCATION OF ALL VISIBLE STRUCTURES AND DIMENSIONS OF ALL PRINCIPAL BUILDINGS THEREON, BOUNDARY FENCES, APPARENT EASEMENTS, ROADWAYS AND VISIBLE ENCROACHMENTS, IF ANY, TO THE BEST OF MY KNOWLEDGE AND BELIEF.

THIS SURVEY IS MADE FOR THE USE OF THE PRESENT OWNERS OF THE PROPERTY, AND ALSO THOSE WHO PURCHASE, MORIGAGE, OR GUARANTEE THE TITLE THERETO WITHIN ONE (1) YEAR FROM DATE HEREOF.

DAVID F. ABELL

WISCONSIN REGISTERED LAND SURVEYOR, S-1596

July 26, 1990 DATE JOB NUMBER - 90146

NOTE: THIS IS NOT A CERTIFIED COPY UNLESS SEALED.

DØ5-1085