

ABELL
SURVEYING & MAPPING
DELAVER, WISCONSIN 53115
414-726-6787




SCALE - 1"=20'

LEGEND

- Ø - IRON PIPE FOUND
- - IRON ROD SET
- △ - UTILITY POLE
- () - RECORDED AS
- x-x- CHAINLINK FENCE

ORDERED BY: THE RAULAND AGENCY
118 KENOSHA ST.
WALWORTH, WI. 53184

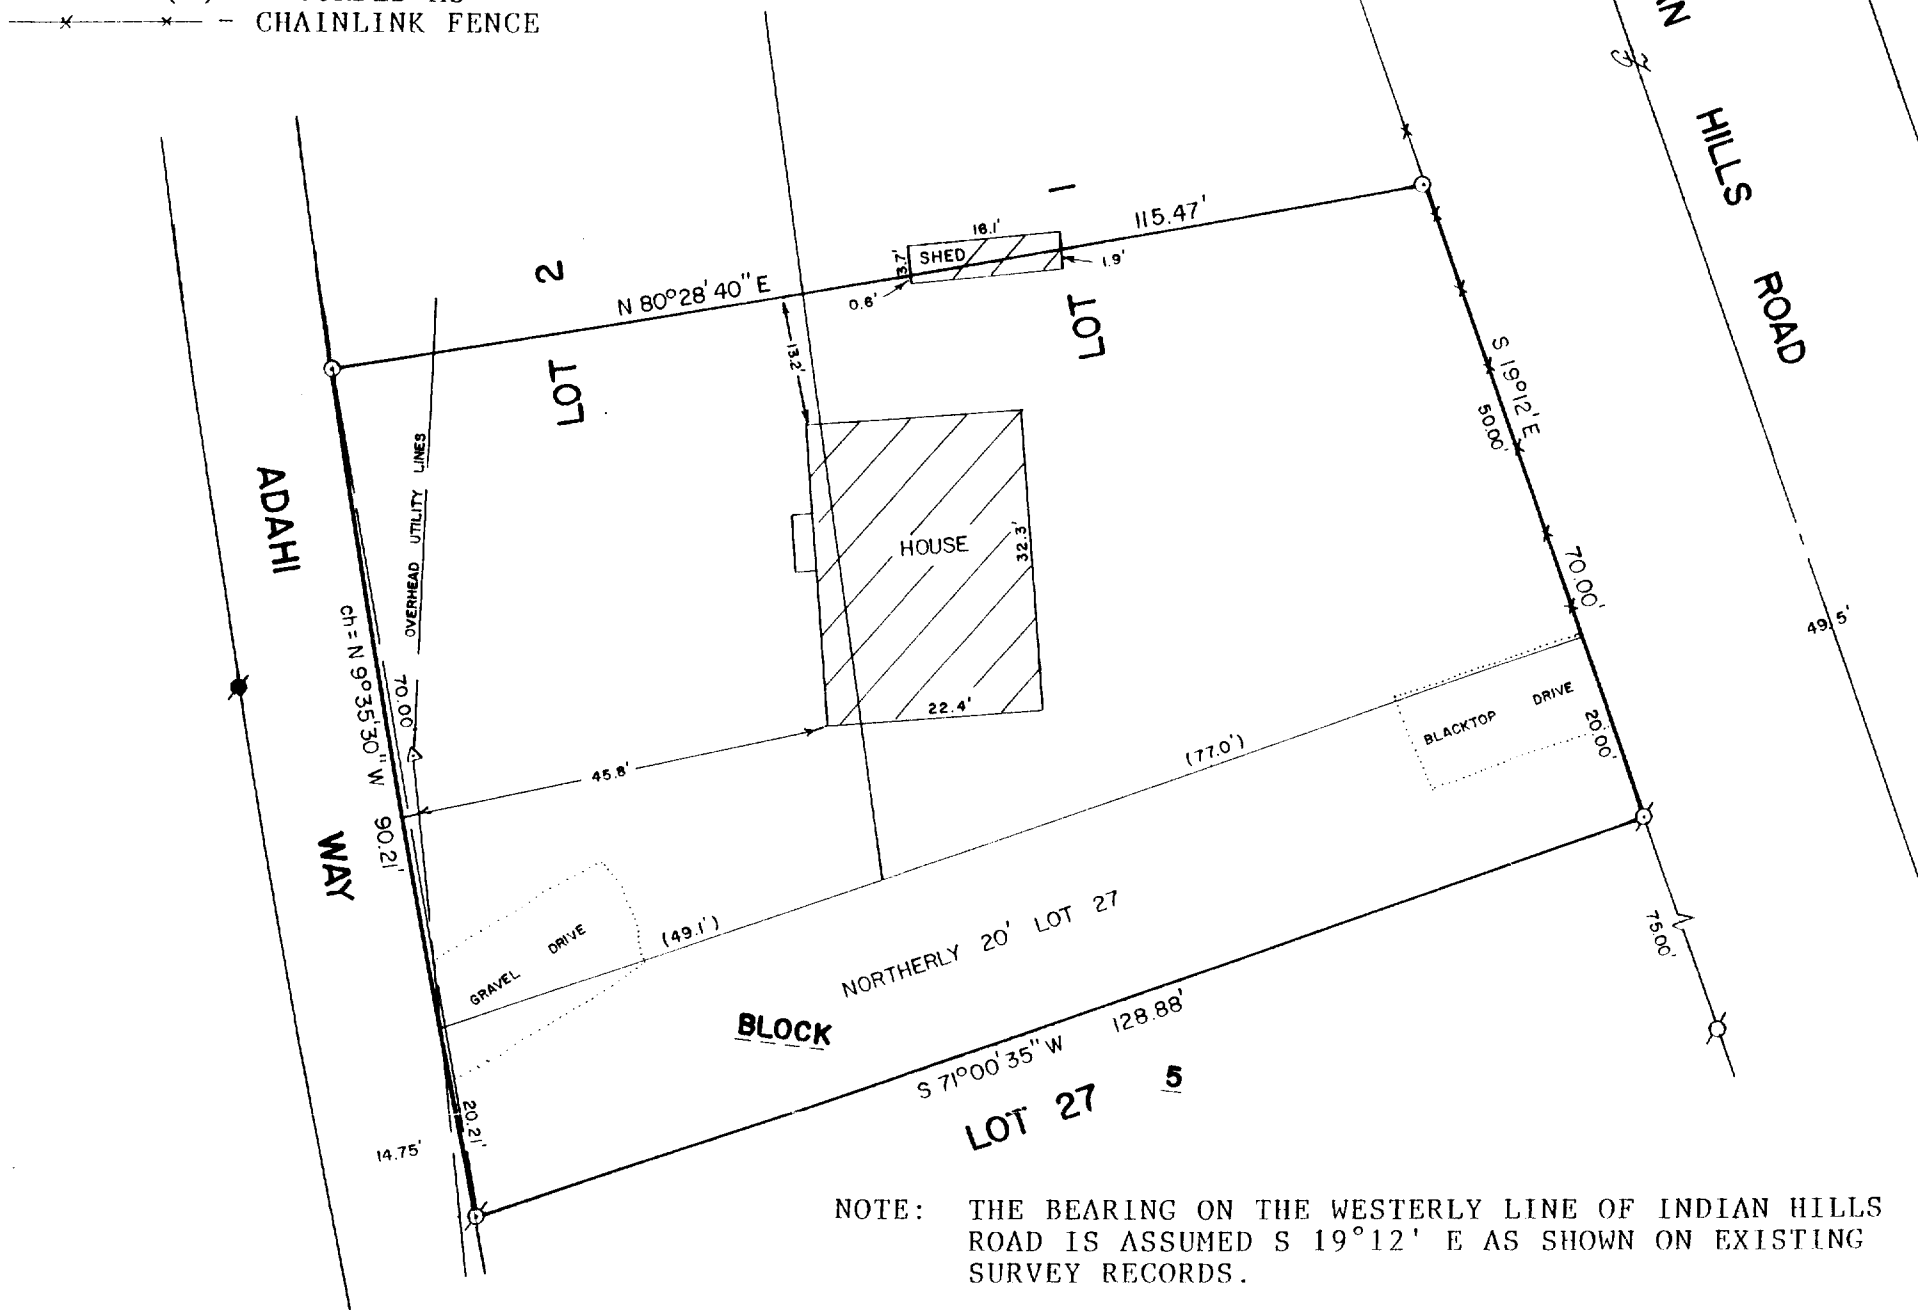

PLAT OF SURVEY OF


That part of Lots 1 and 2 lying Southerly of a line drawn from a point on the Easterly line of Lot 1, fifty feet Northerly of the SE corner of said Lot, to a point on the Westerly line of Lot 2, 70 feet Northerly of the SW corner of Lot 2, in Block 5 in Indian Hills, being a subdivision in Government lot 4 in Section 14, T1N, R16E, of the 4th P.M., reference being had to the Plat thereof recorded March 26, 1927 in Volume 8 of Plats, pages 109 and 110 in Walworth County, Wisconsin.

Also, the Northerly 20 feet of Lot 27 in Block 5 in Indian Hills, being a subdivision in Government Lot 4 in Section 14, T1N, R16E of the 4th P.M., according to the plat thereof recorded March 26, 1927 in Volume 8 of Plats pages 109 and 110, Walworth County, Wisconsin.

Tax Key No. 81H 00067

I HEREBY CERTIFY THAT I HAVE SURVEYED THE ABOVE DESCRIBED PROPERTY AND THAT THE ABOVE MAP IS A TRUE REPRESENTATION THEREOF AND SHOWS THE SIZE AND LOCATION OF THE PROPERTY, ITS EXTERIOR BOUNDARIES, THE LOCATION OF ALL VISIBLE STRUCTURES AND DIMENSIONS OF ALL PRINCIPAL BUILDINGS THEREON, BOUNDARY FENCES, APPARENT EASEMENTS, ROADWAYS AND VISIBLE ENCROACHMENTS, IF ANY, TO THE BEST OF MY KNOWLEDGE AND BELIEF.

THIS SURVEY IS MADE FOR THE USE OF THE PRESENT OWNERS OF THE PROPERTY, AND ALSO THOSE WHO PURCHASE, MORTGAGE, OR GUARANTEE THE TITLE THERETO WITHIN ONE (1) YEAR FROM DATE HEREOF.

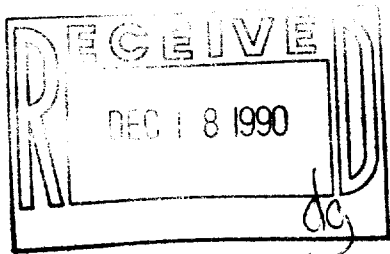

David F. Abell
DAVID F. ABELL

WISCONSIN REGISTERED LAND SURVEYOR, S-1596

July 18, 1990
DATE

JOB NUMBER - 90135

NOTE: THIS IS NOT A CERTIFIED COPY UNLESS SEALED.

005-1088

81H 00067
81H 00084