ABERNATHY and ASSOCIATES Kenneth B. Abernathy Jr.


Rt. 3, Box 273 Elkhorn, Wisconsin 53121 Phone: (414) 723-4260 (office) (414) 723-4813 (residence)


Wisconsin Registered Land Surveyor S-1594

PLAT OF SURVEY

LOTS 18 AND 19 OF BLOCK 4 OF INDIAN HILLS FIRST ADDITION, LOCATED IN THE VILLAGE OF FONTANA, WALWORTH COUNTY, WISCONSIN.

OWNERS: JOHN AND CHERYL MICK RT. 1 BOX 281C FONTANA, WI. 53125

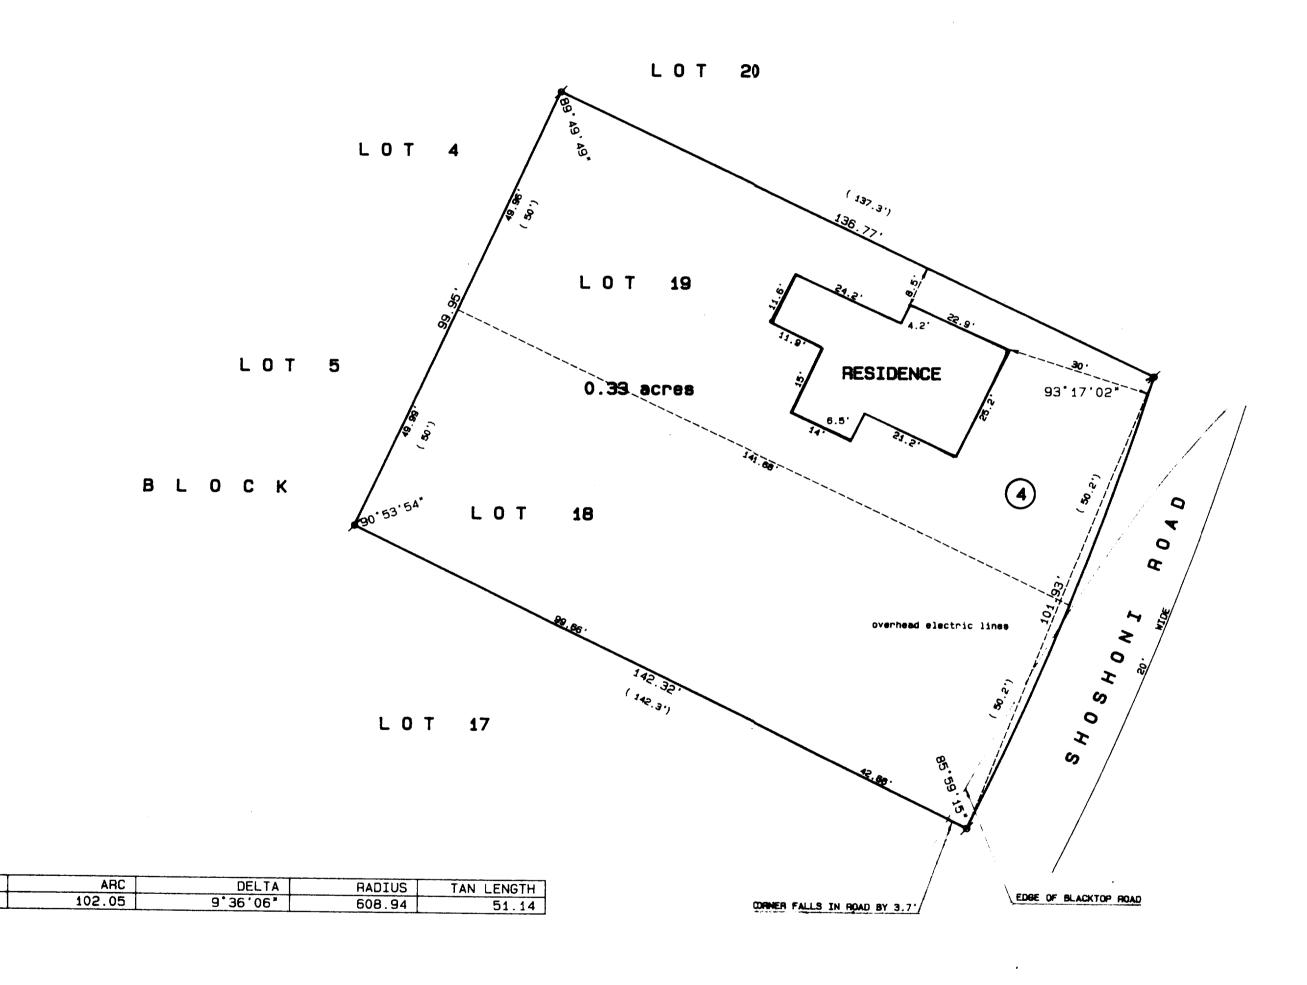

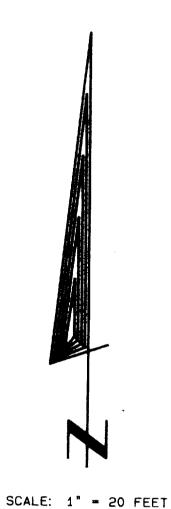

Legend

- FOUND IRON ROD FOUND BRASS CAPPED MONUMENT
- # FOUND CONCRETE MONUMENT
- + CHISEL CUT IN CONCRETE
- SET IRON ROD, 24" LONG, WEIGHING 1.5 LBS./LINEAL FT., 3/4" DIA.
- SET IRON ROD, 30" LONG, WEIGHING
- (xx) RECORDED AS DIMENSION

-x-x- EXISTING FENCE



SCALE: 1"= Zo FEET



"I hereby certify that I have surveyed the above described property and that the above map is a true representation thereof and shows the size and location of the property, its exterior boundaries, the location of all visible structures and dimensions of all principal buildings thereon, boundary fences, apparent easements, roadways and visible encroachments if any."

ments, if any."

"This survey is made for the use of the present owners of the property, and also those who purchase, mortgage, or guarantee the title thereto within one year from date

KENNETH B. ABERNATHY, JR.

WISCONSIN REGISTERED LAND SURVEYOR, Date: 7/16/91 Job No. 91.704