


37EV-80

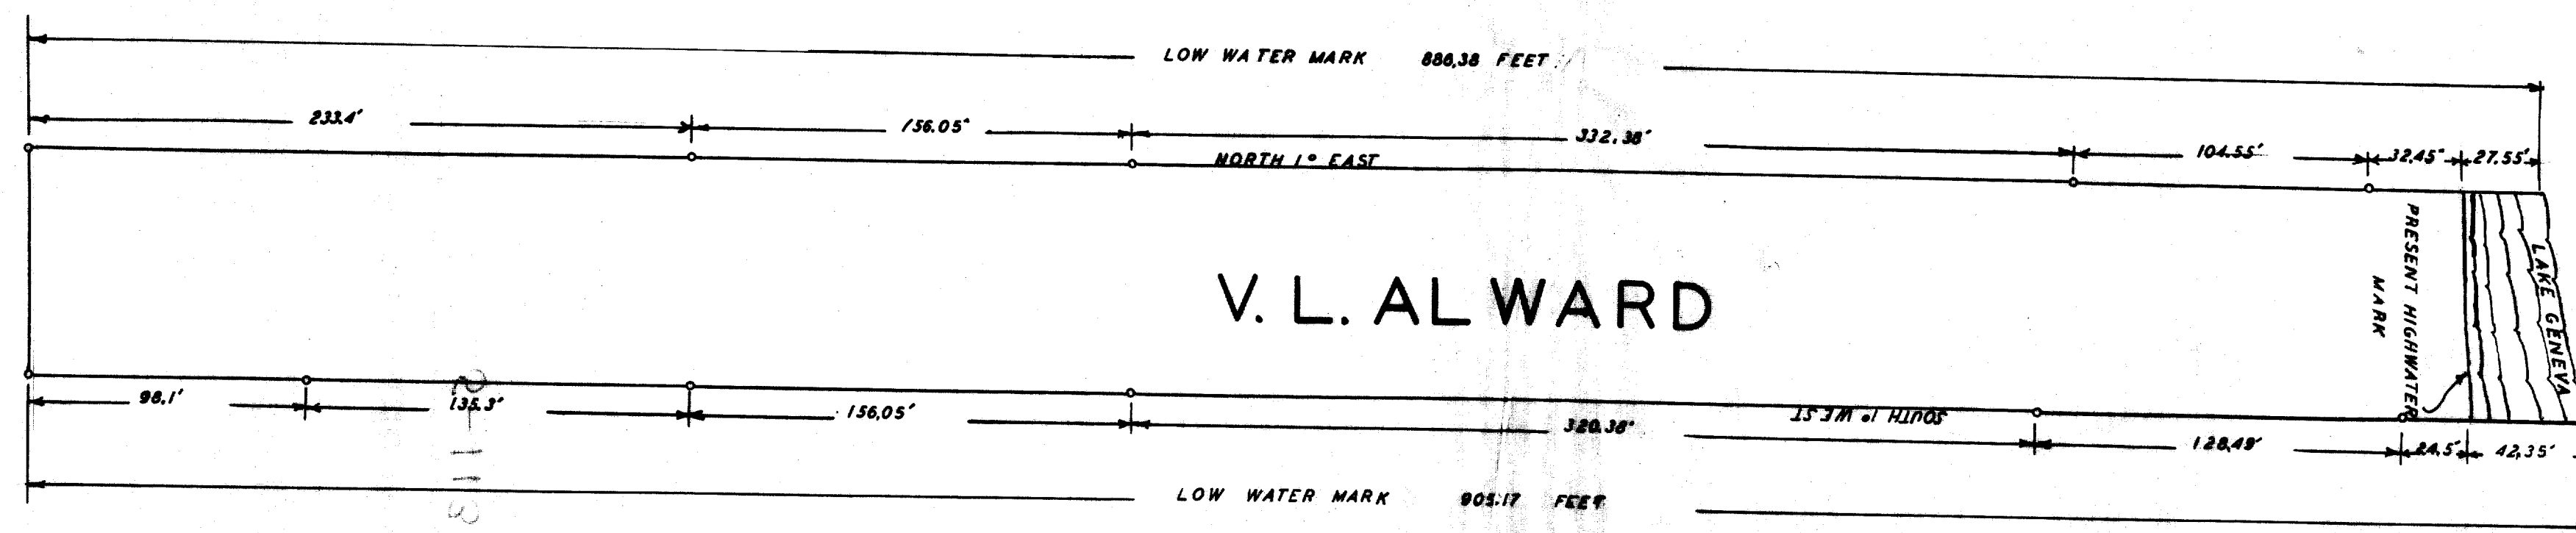


SCALE 1" = 50'
LEGEND:-
○ IRON-STAKE

I JOSEPH M. BIAGI DO HEREBY CERTIFY THAT I
HAVE SURVEYED THE PROPERTY DESCRIBED ABOVE ACCORDING
TO OFFICIAL RECORDS AND THE PLAT ABOVE DRAWN IS A
CORRECT REPRESENTATION OF SAID SURVEY.

JULY 9 1937
SIGNED *Joseph M. Biagi*
SEALED

SURVEY
OF
V. L. ALWARD
PROPERTY
ON THE SOUTH SHORE OF LAKE GENEVA,
SECTION 13, TOWNSHIP 1 NORTH, RANGE
SIXTEEN.
DATE JULY 9 1937
DRAWN BY H.C.G.

01.55
+ E 20' of 37EV-80
on 24.5' mark

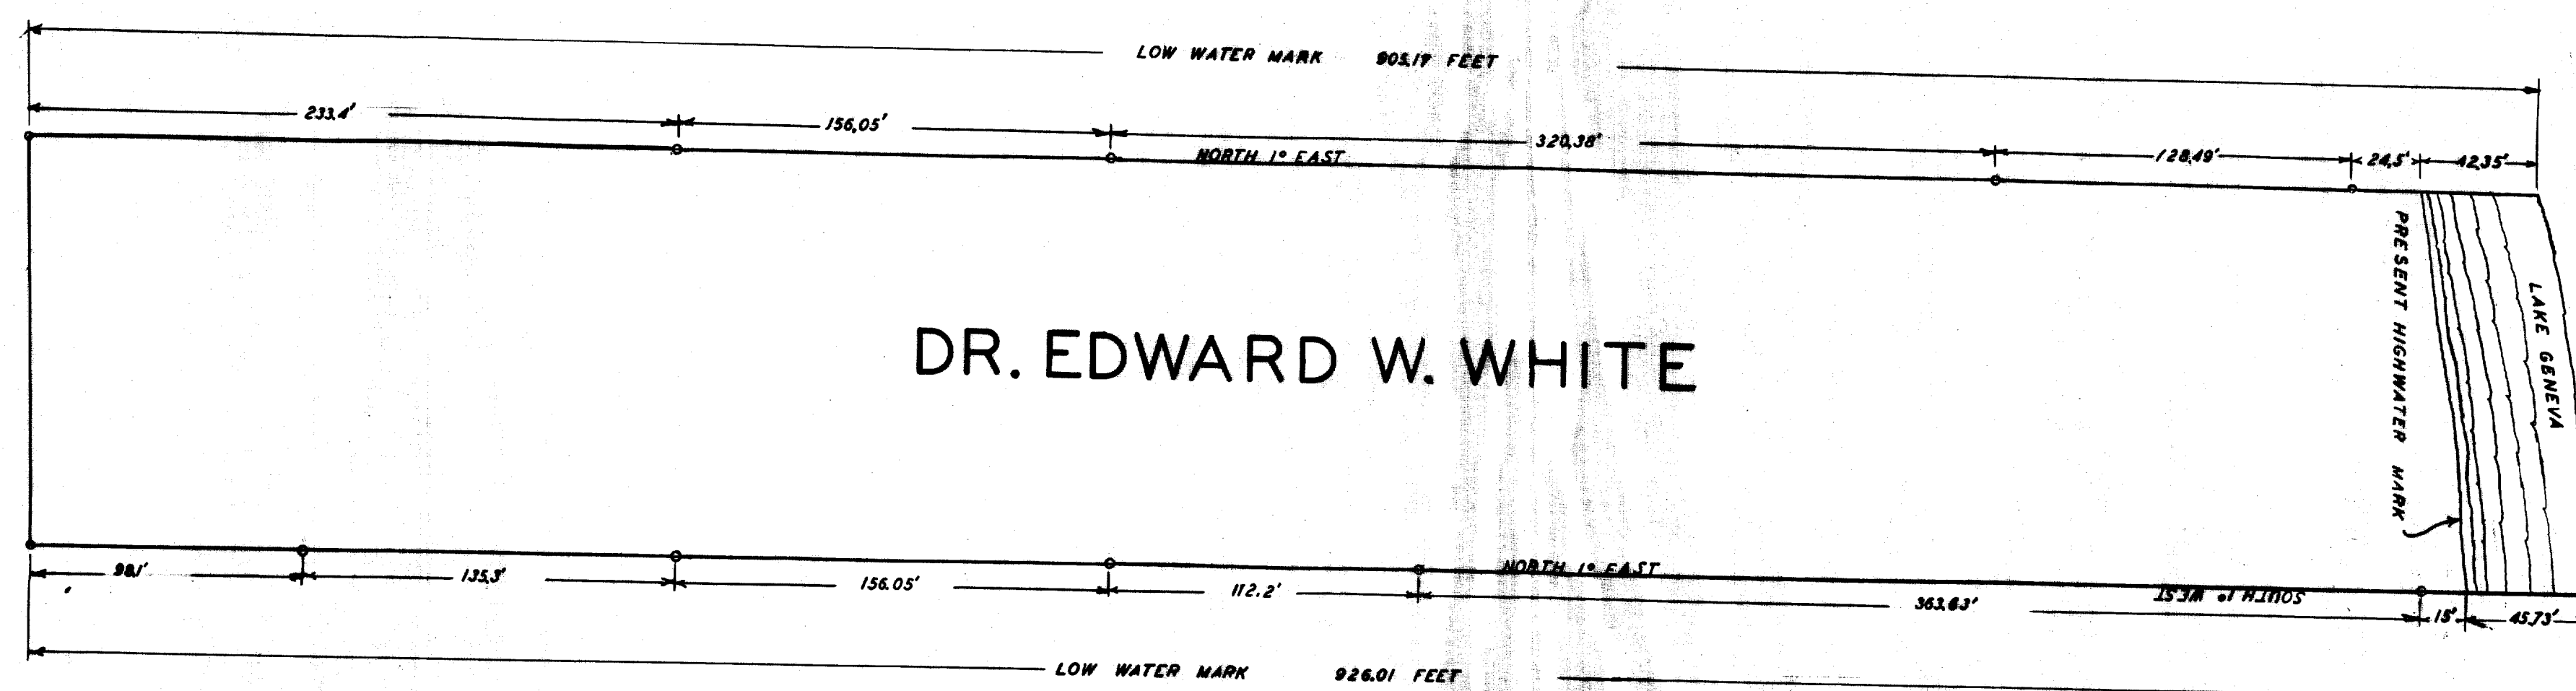

SCALE 1" = 50'
LEGEND:-
○ IRON-STAKE

I JOSEPH M. BIAGI DO HEREBY CERTIFY THAT I
HAVE SURVEYED THE PROPERTY DESCRIBED ABOVE ACCORDING
TO OFFICIAL RECORDS AND THE PLAT ABOVE DRAWN IS A
CORRECT REPRESENTATION OF SAID SURVEY.

JULY 9 1937
SIGNED *Joseph M. Biagi*
SEALED

SURVEY
OF
DR. EDWARD W. WHITE
PROPERTY
ON THE SOUTH SHORE OF LAKE GENEVA,
SECTION 13, TOWNSHIP 1 NORTH, RANGE
SIXTEEN.
DATE JULY 9 1937
DRAWN BY H.C.G.