
## PLAT OF SURVEY AND RESIDENCE LOCATION

UNIT 86 - CONDOMINIUM NO. 3 ABBEY SPRINGS CONDOMINIUMS

LOCATED IN THE S 1/2 OF SECTION 13, TOWN I NORTH, RANGE 16 EAST, WALWORTH COUNTY, WISCONSIN

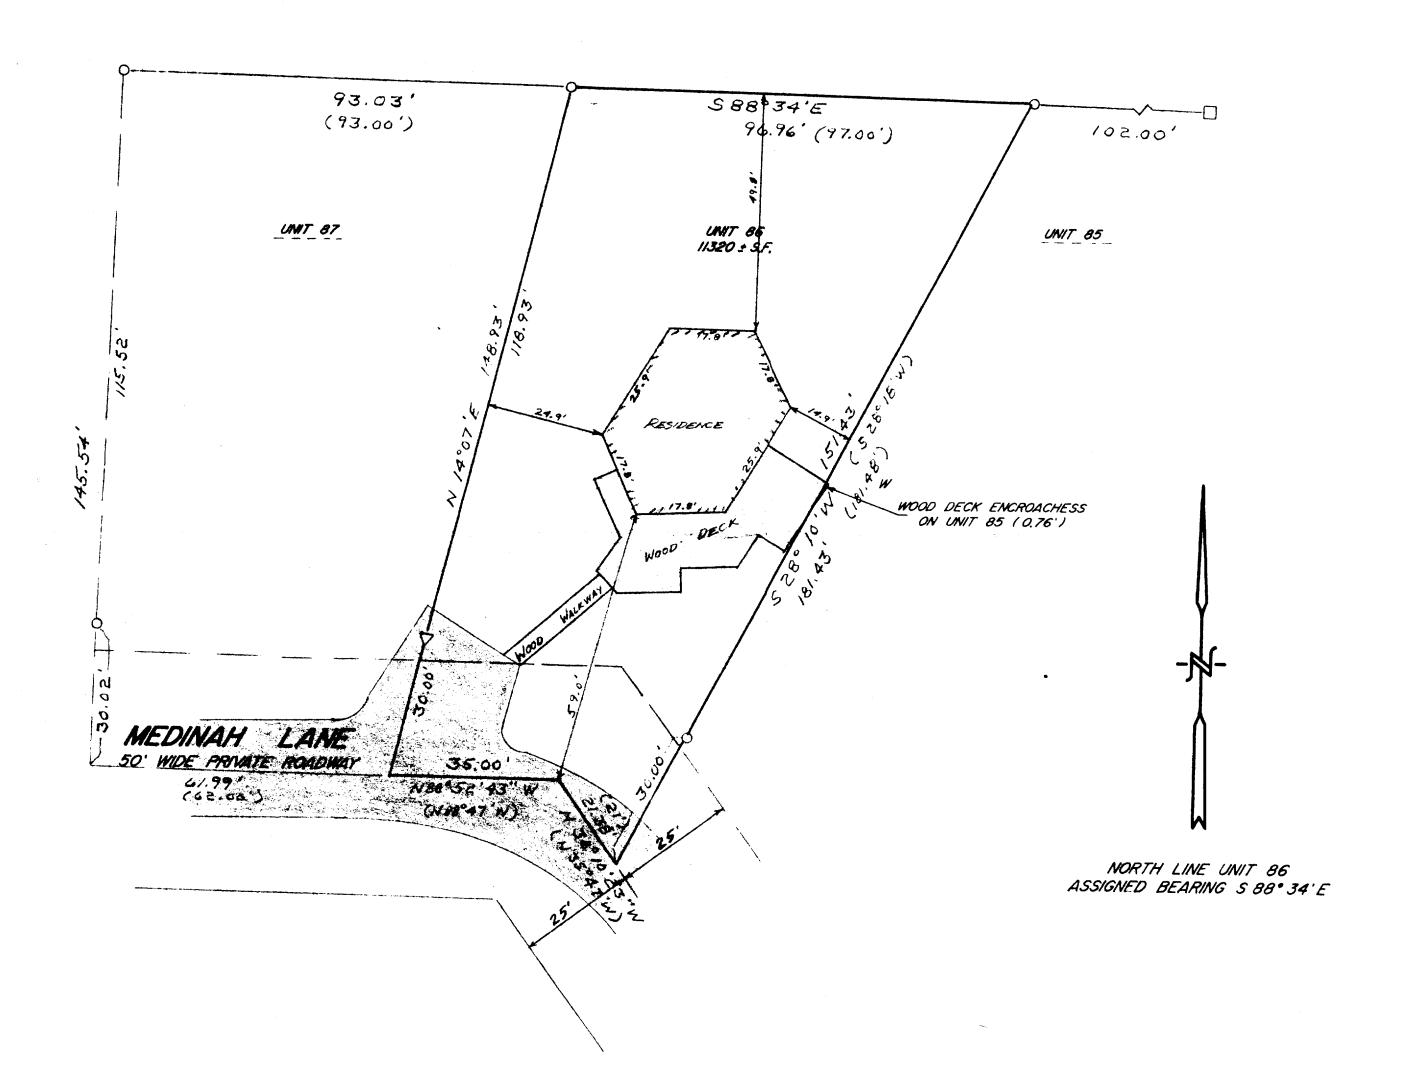

LEGEND

IRON PIPE STAKE FOUND CONCRETE MONUMENT FOUND PK NAIL SET IN PAVEMENT (XXX) RECORDED AS


BY: BILL CHRISOS

MAP SCALE IN FEET I" = 20"

NOTE: COPIES OF THIS MAP TO WHICH THE FOLLOWING CERTIFICATE WILL APPLY ARE BLUE LINE PRINTS SHOWING SURVEYOR'S ORIGINAL SEAL AND SIGNATURE IN BLACK INK. COPIES BY ANY OTHER MEANS MAY HAVE ALTERATIONS WHICH DO NOT REPRESENT THE SURVEYOR'S WORK PRODUCT.

I HEREBY CERTIFY THAT THIS PLAT OF SURVEY IS A TRUE AND ACCURATE REPRESENTATION OF THE BOUNDARY LINES OF THE SUBJECT PARCEL AND SHOWS THE SIZE AND LOCATION OF ALL BUILDINGS ON THE PARCEL SHOWN HEREON, TO THE BEST OF MY PROFESSIONAL KNOWLEDGE AND BELIEF. THIS SURVEY IS MADE FOR THE USE OF THE PRESENT OWNERS OF THE PROPERTY, AND ALSO THOSE WHO PURCHASE, MORTGAGE, OR GUARANTEE THE TITLE THERETO WITHIN ONE YEAR FROM THE DATE HEREOF.

150

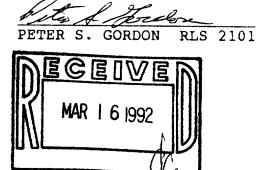





FARRIS, HANSEN & ASSOCIATES, Engineering, Architecture, Survey 7 Ridgway Court P.O. Box 437 ELKHORN, WISCONSIN 53121 Office: (414) 723-2098 Fax: (414) 723-5886

REVISIONS

PROJECT 3612

OØ5-1149

0

ORDERED