


# ABELL SURVEYING & MAPPING

DELAVER, WISCONSIN 53115


414-728-6737

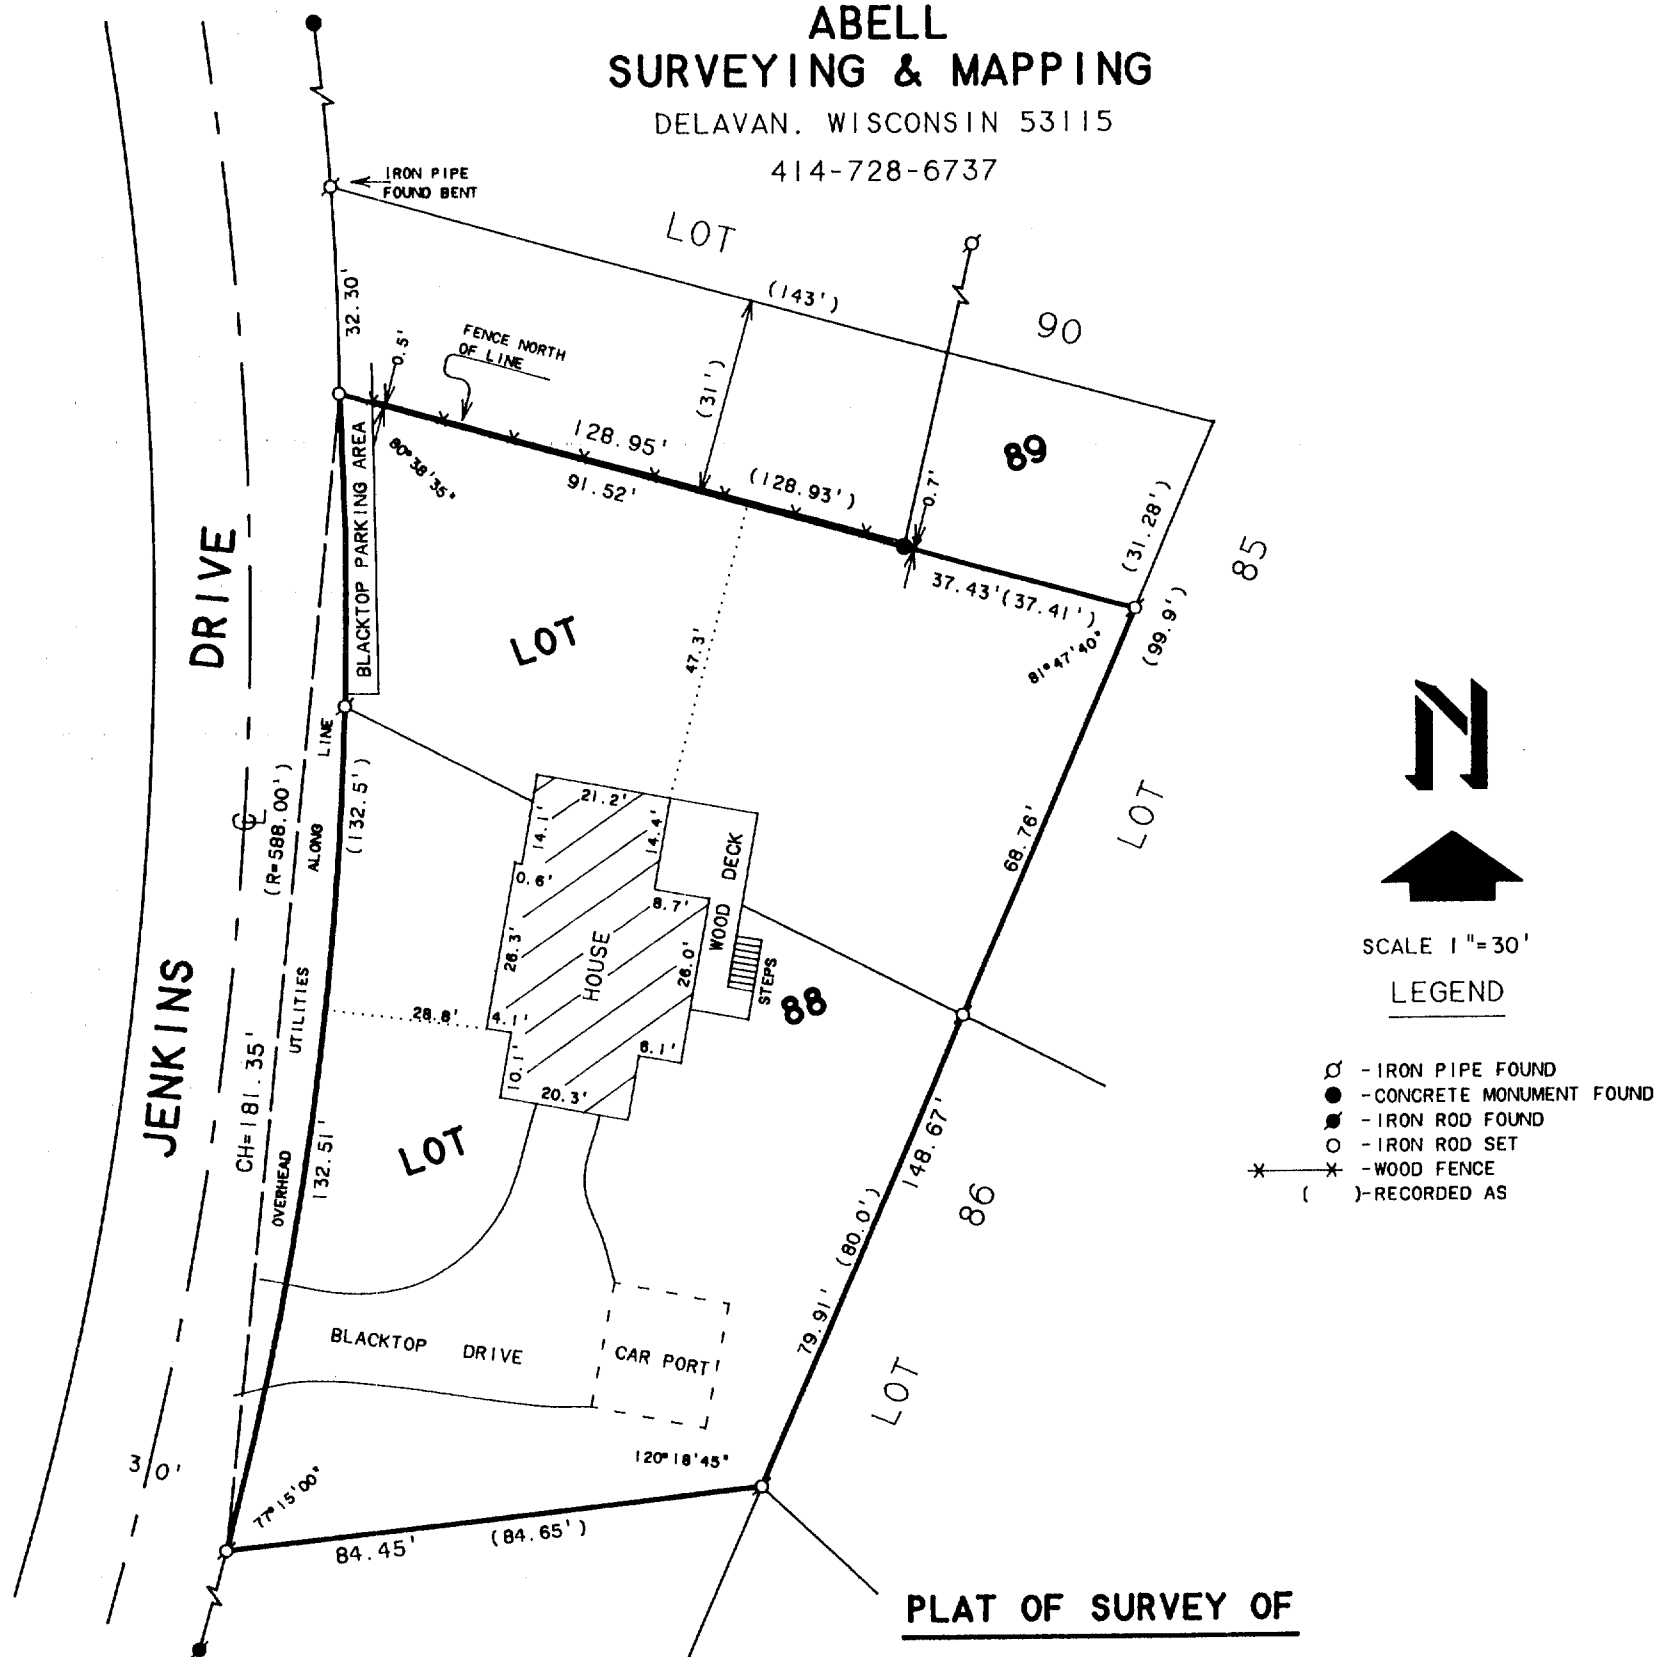

Lot eighty-eight (88), and Lot eighty-nine (89) (except therefrom a strip described as follows: Starting at the Northeast corner of said lot eighty-nine (89); thence westerly along the north line of lot eighty-nine (89) a distance of one hundred forty-three (143) feet to the northwest corner of lot eighty-nine (89); thence along west line of said lot a distance of thirty-two and three tenths (32.3) feet to an iron stake; thence on a line that is parallel with the north line of lot eighty-nine (89) and thirty-one (31) feet distance therefrom a distance of one hundred twenty-eight and ninety-three hundredths (128.93) feet to an iron stake set in the east line of lot eighty-nine (89); thence northerly along east line of lot eighty-nine (89) a distance of thirty-one and twenty-eight one hundredths (31.28) feet to point of beginning) of Country Club Estates Unit No. 2 reference being had to the plat thereof recorded on May 8, 1926 in Volume 8 of Plats on pages 67 and 68 in Walworth County, Wisconsin.

502-84

ORDERED BY: THE RAULAND AGENCY  
P.O. BOX 159  
WALWORTH, WI. 53184

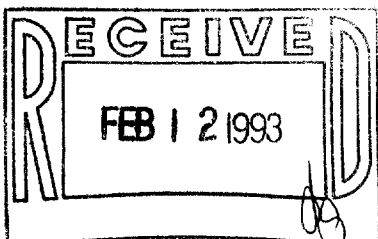

I HEREBY CERTIFY THAT I HAVE SURVEYED THE ABOVE DESCRIBED PROPERTY AND THAT THE ABOVE MAP IS A TRUE REPRESENTATION THEREOF AND SHOWS THE SIZE AND LOCATION OF THE PROPERTY, ITS EXTERIOR BOUNDARIES, THE LOCATION OF ALL VISIBLE STRUCTURES AND DIMENSIONS OF ALL PRINCIPAL BUILDINGS THEREON, BOUNDARY FENCES, APPARENT EASEMENTS, ROADWAYS AND VISIBLE ENCROACHMENTS, IF ANY, TO THE BEST OF MY KNOWLEDGE AND BELIEF.

THIS SURVEY IS MADE FOR THE USE OF THE PRESENT OWNERS OF THE PROPERTY, AND ALSO THOSE WHO PURCHASE, MORTGAGE, OR GUARANTEE THE TITLE THERETO WITHIN ONE (1) YEAR FROM DATE HEREON.

*David F. Abell*

DAVID F. ABELL  
WISCONSIN REGISTERED LAND SURVEYOR, S-1596

November 9, 1992

DATE: November 9, 1992 JOB NUMBER - 92249  
NOTE: THIS IS NOT A CERTIFIED COPY UNLESS SEALED.

005-1261