

ABELL SURVEYING & MAPPING

DELAVER, WISCONSIN 53115


414-728-6737



SCALE 1"=20'


LEGEND

- ⊙ - IRON PIPE FOUND
- ⊗ - MANHOLE COVER
- * - WOOD FENCE
- () - RECORDED AS

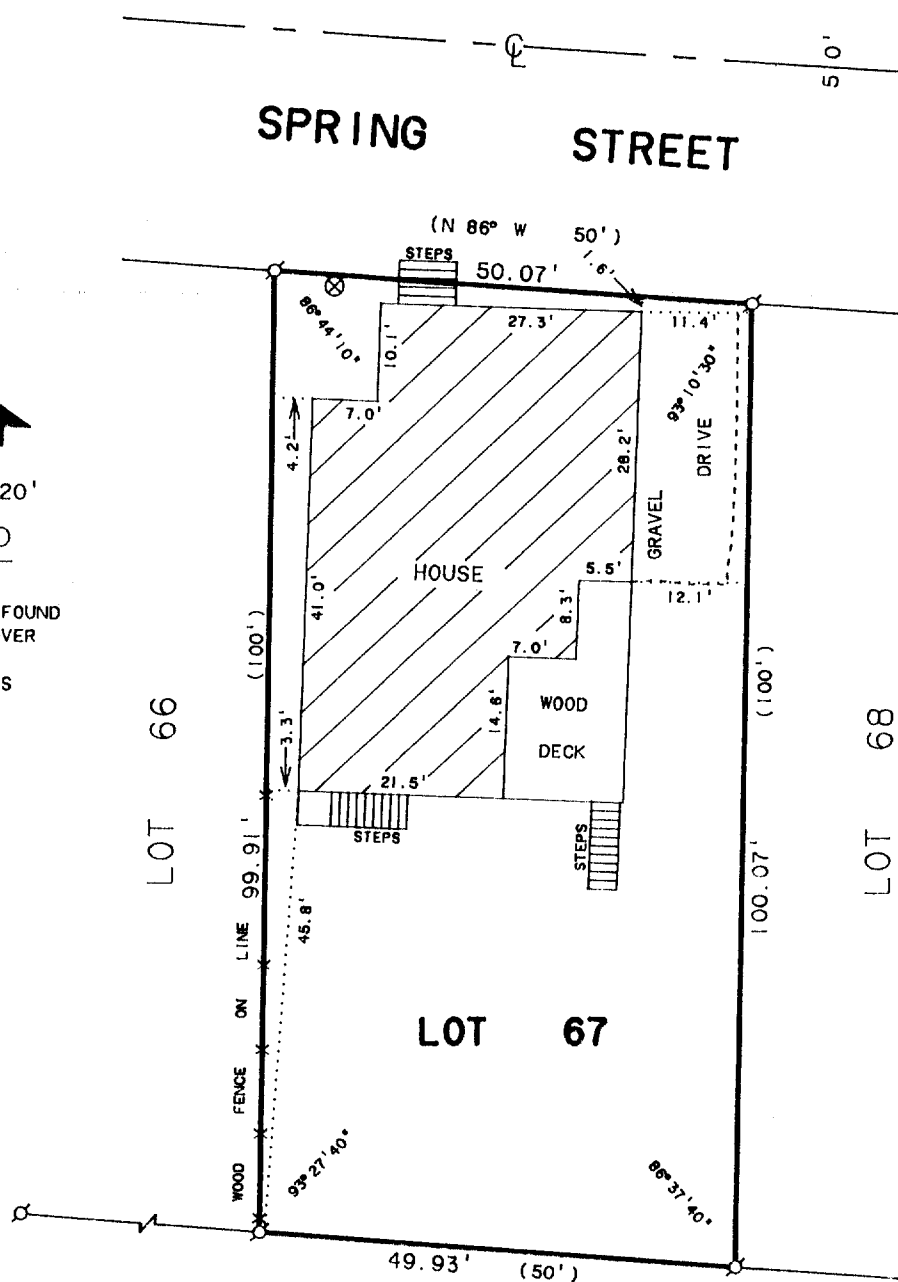

PLAT OF SURVEY OF

LOT 67, BUENA VISTA, LOCATED IN THE
VILLAGE OF FONTANA-ON-GENEVA LAKE,
WALWORTH COUNTY, WISCONSIN.

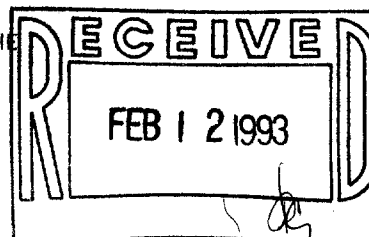

ORDERED BY: FREDERICK D. HOLCOMBE
916 SAUGANASH DRIVE
FONTANA, WI. 53125

OWNER: JOE HAUGHEY
6252 N. HARLEM
CHICAGO, IL. 60631

I, DAVID F. ABELL, DO HEREBY CERTIFY THAT I HAVE SURVEYED THE PROPERTY HEREON
DESCRIBED ACCORDING TO THE OFFICAL RECORDS AND THAT THE PLAT HEREON IS A
CORRECT REPRESENTATION OF THE PROPERTY LINES TO THE BEST OF MY KNOWLEDGE AND
BELIEF.

David F. Abell

DAVID F. ABELL
WISCONSIN REGISTERED LAND SURVEYOR, S-1596

SBV-46

August 22, 1992

REVISED DATE: 9/2/92

DATE JOB NUMBER - 92190
NOTE: THIS IS NOT A CERTIFIED COPY UNLESS SEALED.

ΦΦ5-1263