


DUNHAM SURVEYING, S.C.
SURVEYING & SUBDIVIDING
DELAVER, WISCONSIN 53115

F O N T A N A

A V E N U E

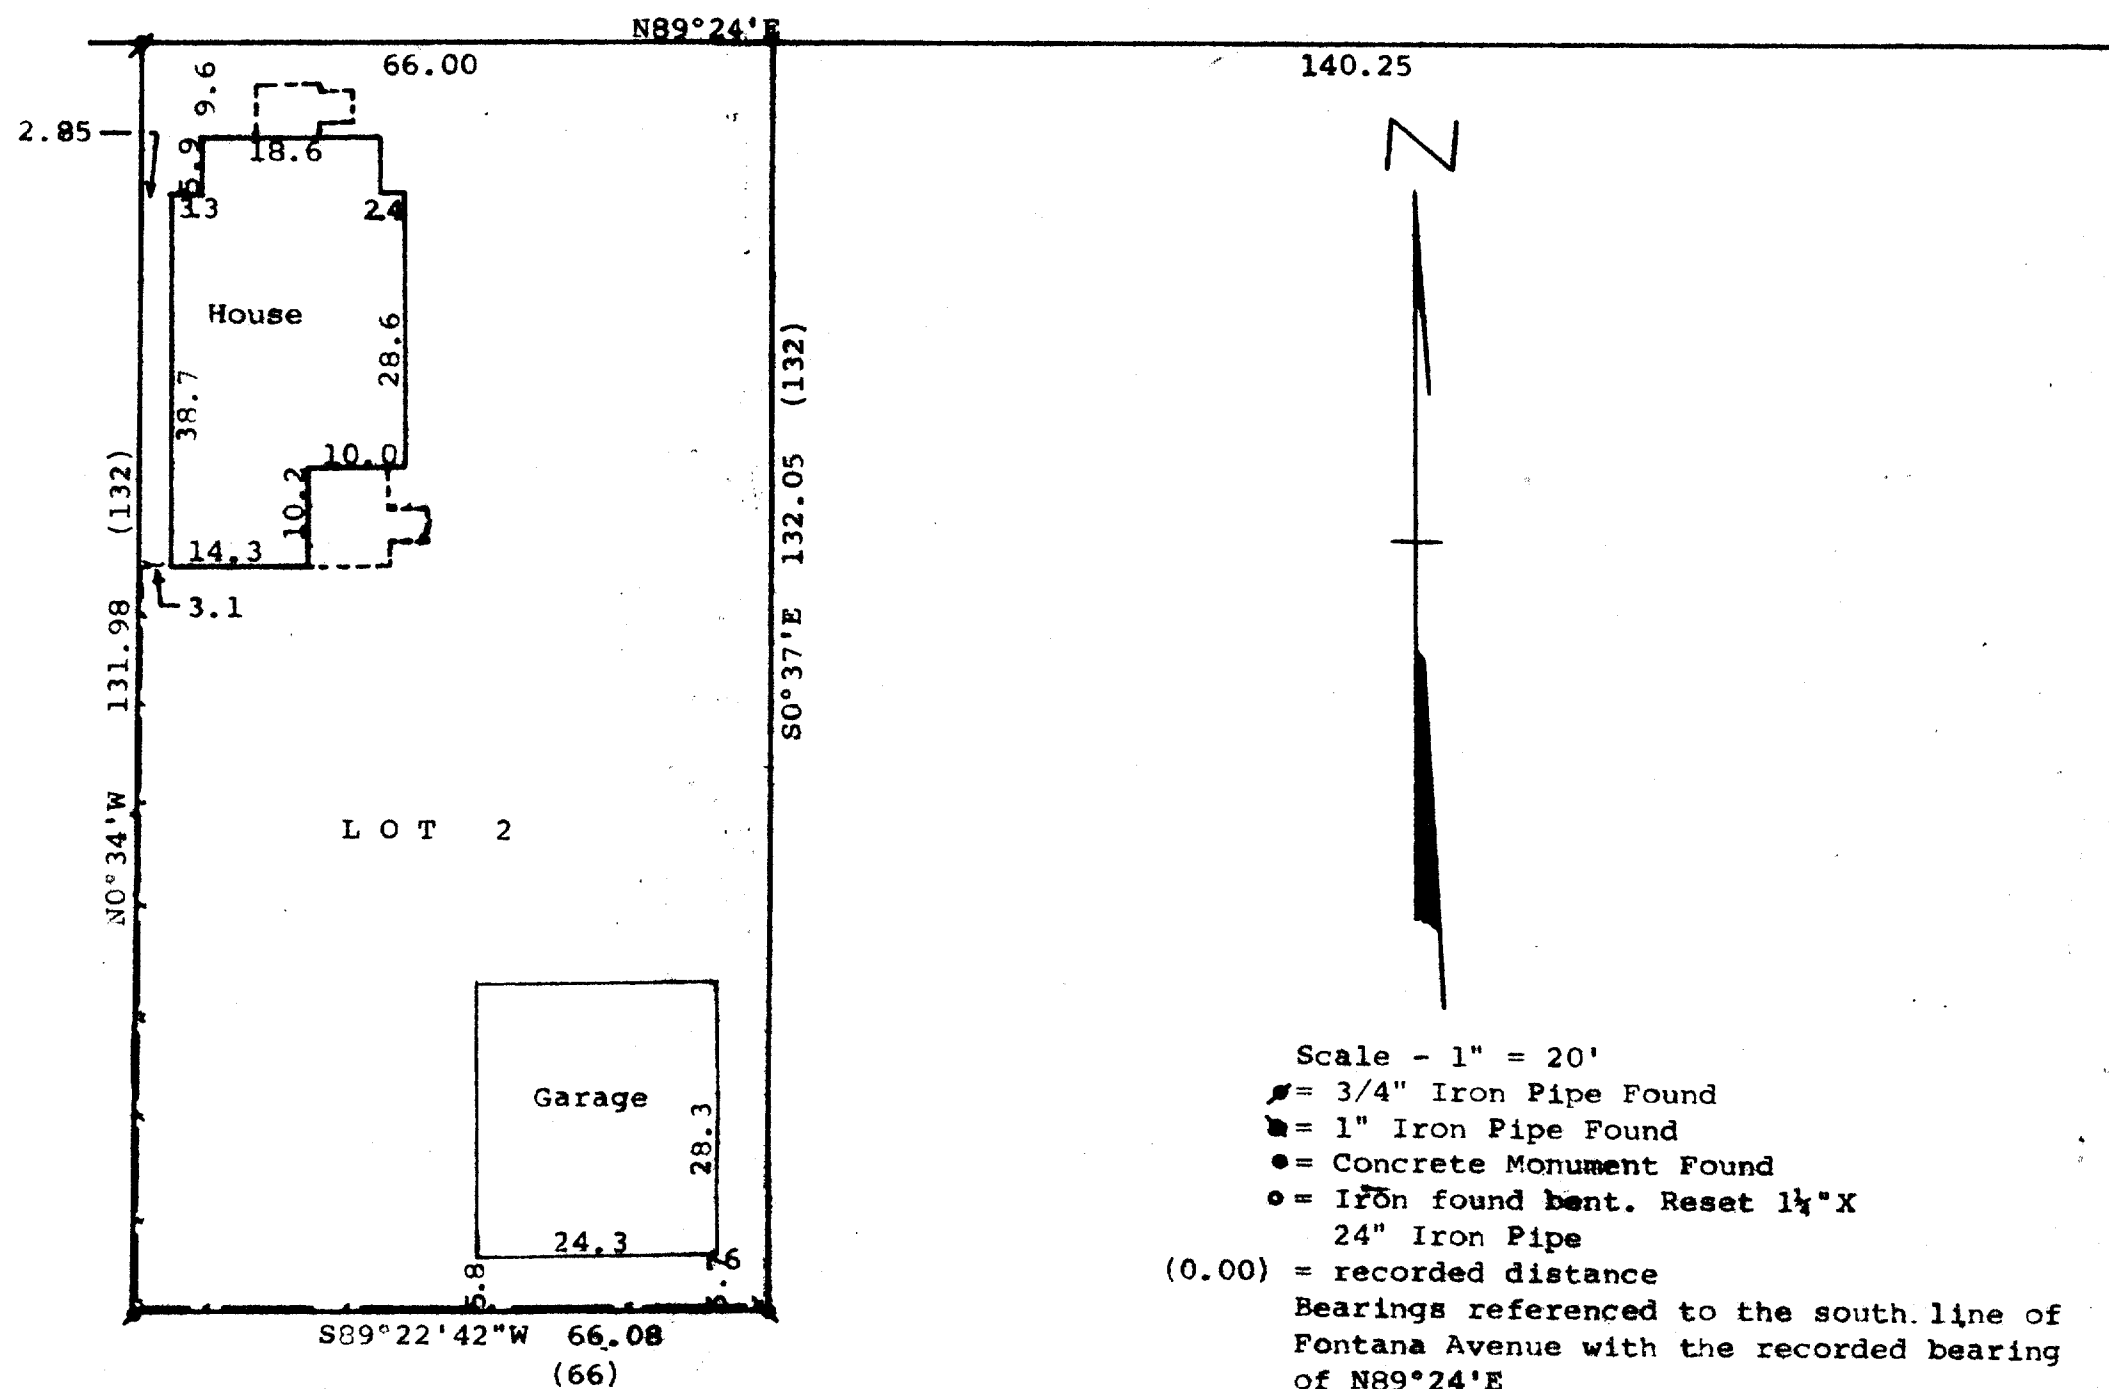

Scale - 1" = 20'
 = 3/4" Iron Pipe Found
 = 1" Iron Pipe Found
 = Concrete Monument Found
 = Iron found bent. Reset 1 1/4" X 24" Iron Pipe
 (0.00) = recorded distance
 Bearings referenced to the south line of Fontana Avenue with the recorded bearing of N89°24'E
 Survey ordered by: Churchill Real Estate
 322 Park
 Walworth, WI 53184 (1986)
 --- Fence Line



Survey Ordered By (1988):
 Dari-State Realty
 207 S. Main Street
 Walworth, WI 53184

Updating and recertification ordered by: Diane Hohisel
 127 Fontana Avenue
 Fontana, WI 53125

STATE OF WISCONSIN)SS
 COUNTY OF WALWORTH)

I, George T. Dunham, Surveyor, certify that I have surveyed the property described as follows,
 Lot 2, Block 5 of Assessor's Plat No. 1, C.L. Douglass Addition to the Village of Fontana, Walworth County, Wisconsin, and that the map shown hereon is a true representation thereof and shows the size and location of the property, its exterior boundaries, the location of all visible structures and dimensions of all principal buildings thereon, boundary fences, apparent easements, roadways and visible encroachments, if any, and that I have surveyed the property hereon described according to the official records, to the best of my knowledge and belief.
 August 28, 1986.
 Recertified and Dated this 18th day of July, 1988.
 Updated and recertified to this 26th day of May, 1993.

George T. Dunham
 George T. Dunham, Surveyor

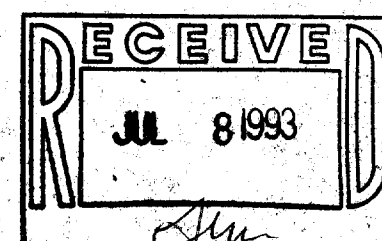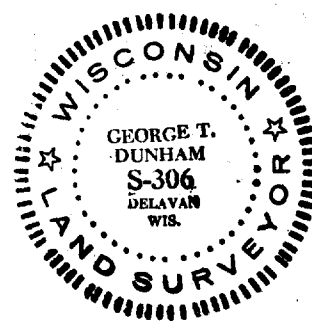

STFV-229

005-1307