


**ABELL**  
**SURVEYING & MAPPING**  
 DELAVAN, WISCONSIN 53115  
 414-728-6737

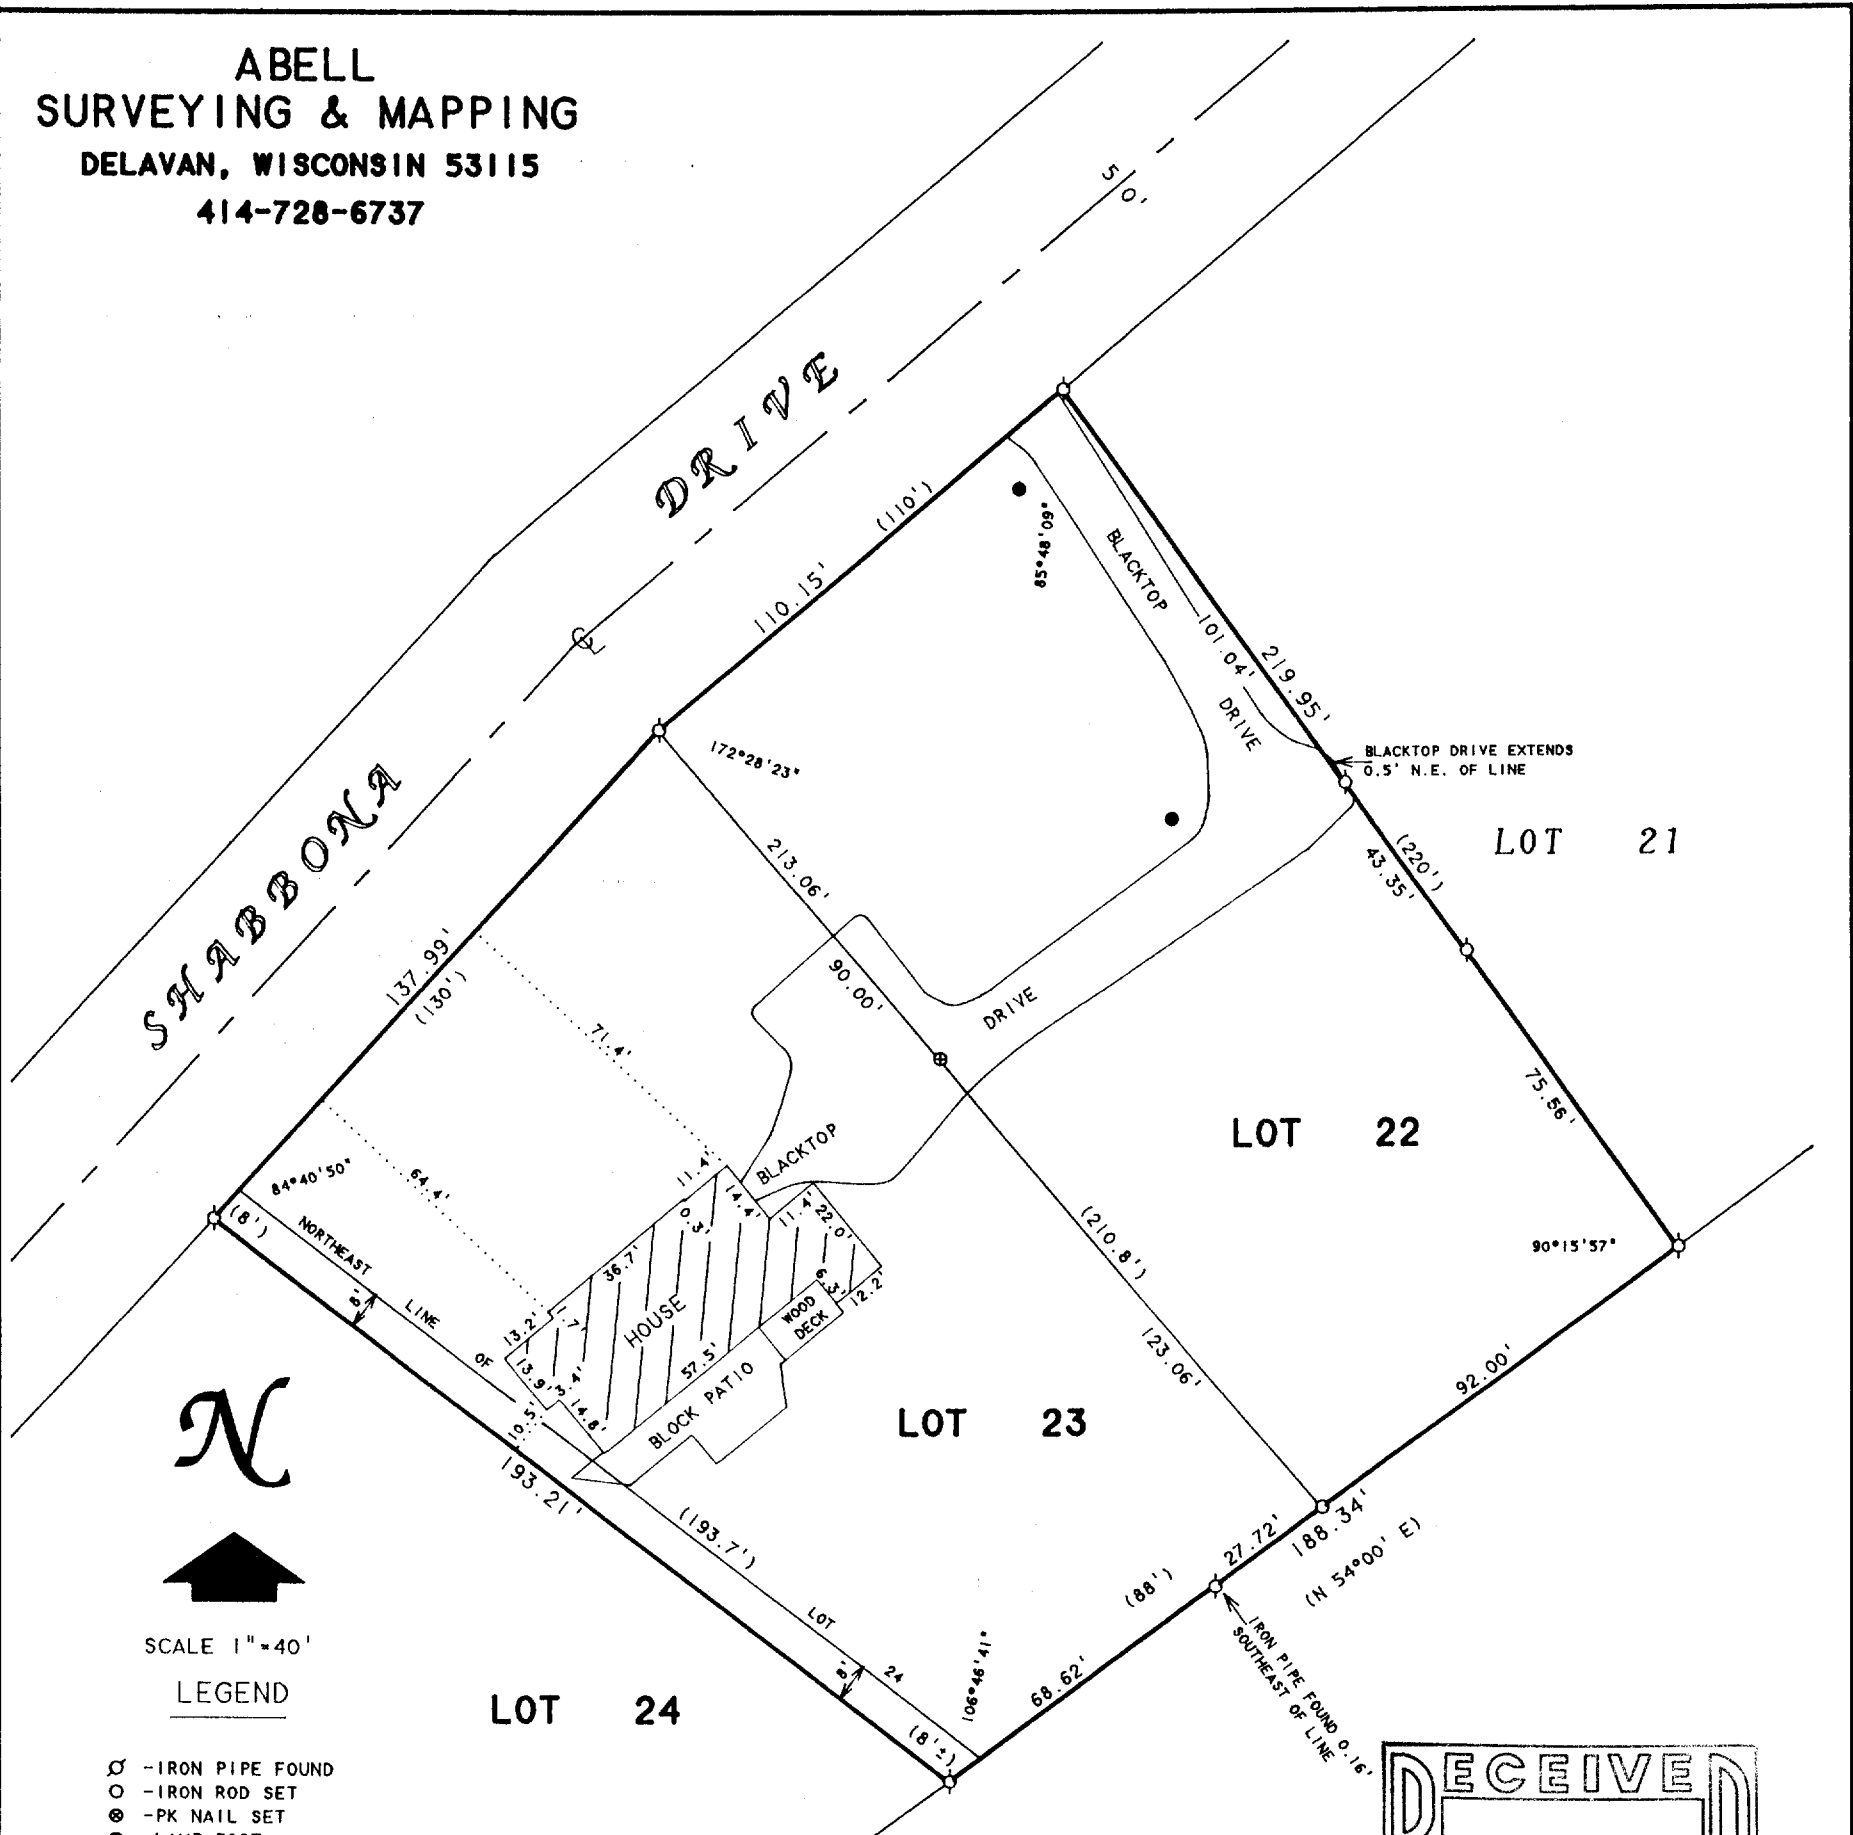

**LEGEND**

- - IRON PIPE FOUND
- - IRON ROD SET
- ⊙ - PK NAIL SET
- - LAMP POST
- ( ) - RECORDED AS

**RECEIVED**  
 OCT 29 1993  
*dg*

**PLAT OF SURVEY OF**

Lot 22, Lot 23 and that part of Lot 24 described as follows: Beginning at the Southeast corner of said lot; running thence Northwesterly along the line between Lots 23 and 24 a distance of 193.7 feet to the Northeast corner of said Lot 24; thence Southwesterly 8 feet along front lot line; thence Southeasterly parallel to and 8 feet distant from the aforescribed line between Lots 23 and 24 to the South boundary line of Unit No. 1; thence Northeasterly about 8 feet to the place of beginning, all in Unit No. 1 Country Club Estates, according to the recorded plat thereof.

I HEREBY CERTIFY THAT I HAVE SURVEYED THE ABOVE DESCRIBED PROPERTY AND THAT THE ABOVE MAP IS A TRUE REPRESENTATION THEREOF AND SHOWS THE SIZE AND LOCATION OF THE PROPERTY, ITS EXTERIOR BOUNDARIES, THE LOCATION OF ALL VISIBLE STRUCTURES AND DIMENSIONS OF ALL PRINCIPAL BUILDINGS THEREON, BOUNDARY FENCES, APPARENT EASEMENTS, ROADWAYS AND VISIBLE ENCROACHMENTS, IF ANY, TO THE BEST OF MY KNOWLEDGE AND BELIEF.

ORDERED BY: ALLEN, HARRISON, WILLIAMS,  
 McDONELL & SWATEK  
 527 CENTER STREET  
 P.O. BOX 760  
 LAKE GENEVA, WI 53147

THIS SURVEY IS MADE FOR THE USE OF THE PRESENT OWNERS OF THE PROPERTY, AND ALSO THOSE WHO PURCHASE, MORTGAGE, OR GUARANTEE THE TITLE THERETO WITHIN ONE (1) YEAR FROM DATE HEREON.

*David F. Abell*  
 DAVID F. ABELL  
 WISCONSIN REGISTERED LAND SURVEYOR, S-1596

July 31, 1993  
 DATE: \_\_\_\_\_ JOB NUMBER - 93162  
 NOTE: THIS IS NOT A CERTIFIED COPY UNLESS SEALED.

SC01-22

005-1324