


# Plat of Survey

of

Lots 27 and 28, Block 5, C.L. Douglas Subdivision, part of Assessor's Plat No. 1 of the Village of Fontana-on-Geneva Lake, Walworth County, Wisconsin.

Surveyed for: Lakeland Realty  
 P.O. Box 323  
 Fontana, Wisconsin. 53125

Bearings are assumed.

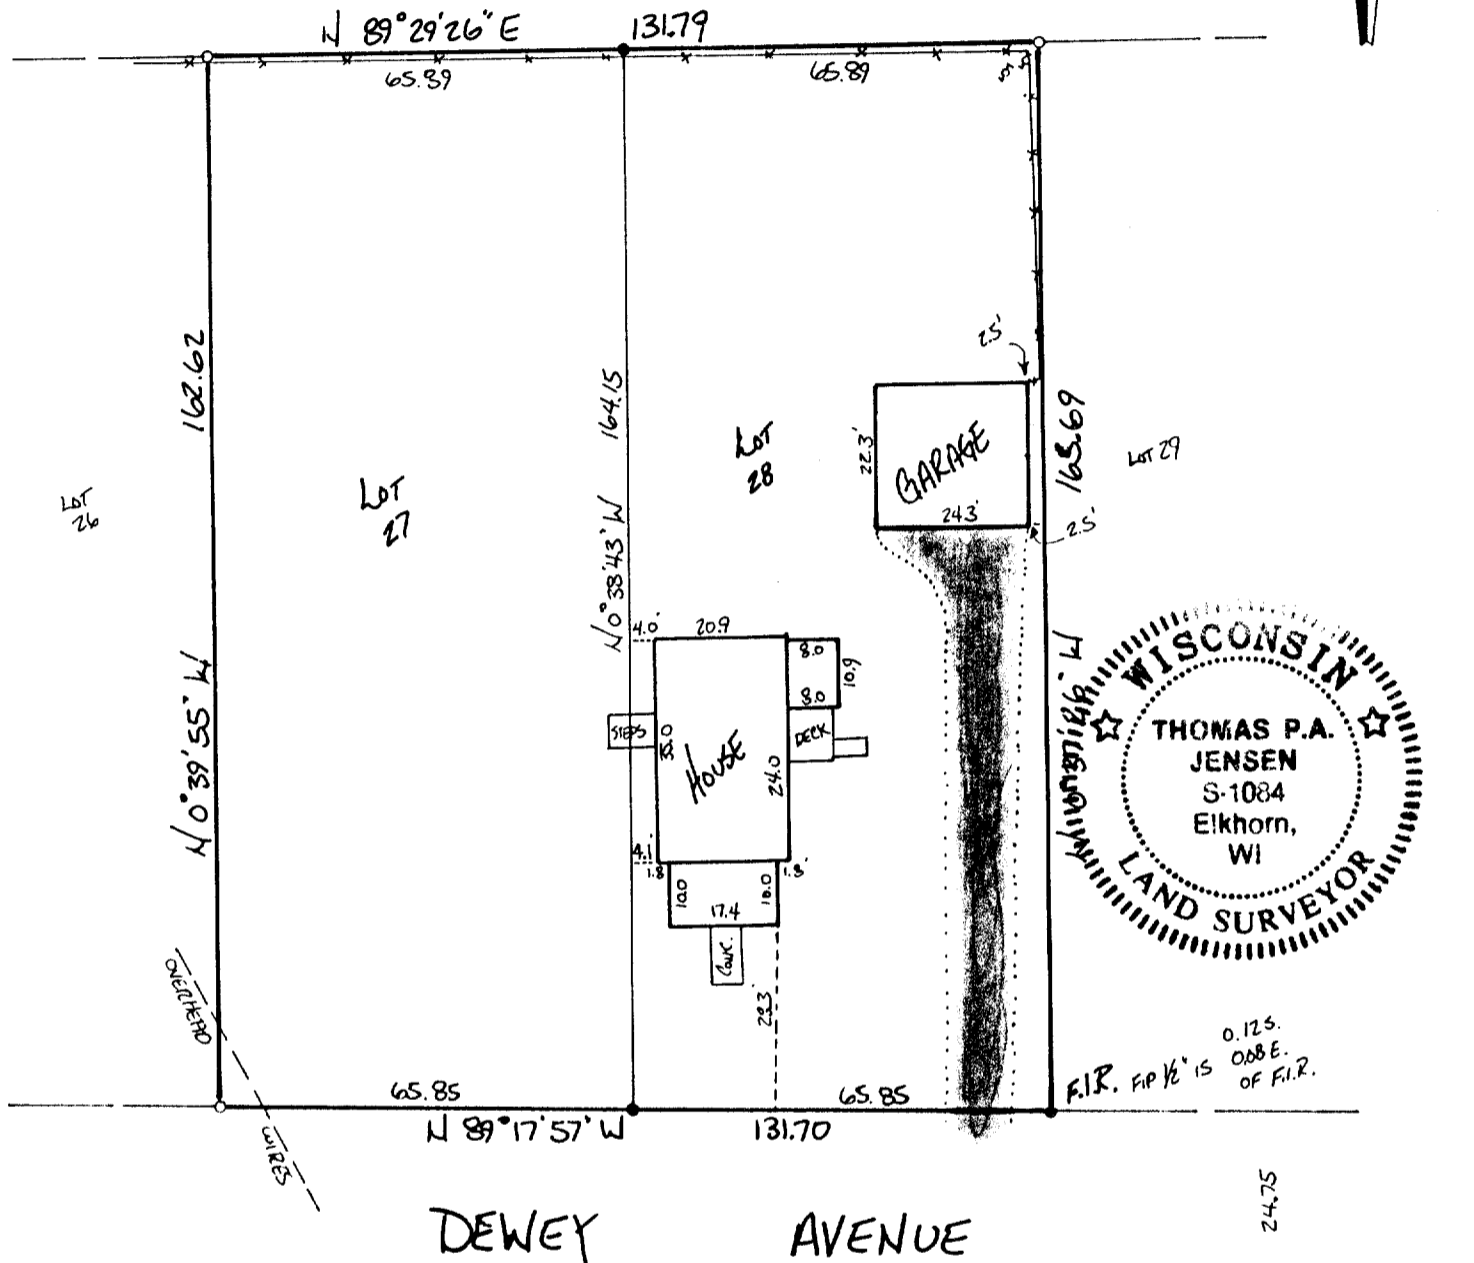


Copyright © 1993 by Jensen Surveying & Mapping S.C.

All rights reserved. No part of this survey plat may be reproduced or transmitted in any form by any means - graphic, electronic, or mechanical, including photocopying, tracing, or information storage and retrieval systems - without permission in writing from Thomas P.A. Jensen.

I, Thomas P.A. Jensen, Wisconsin Registered Land Surveyor, do hereby certify that this survey was performed by me, or under my direction, in full compliance with the owner's/agent's instructions and Chapter A-E 7 of the Wisconsin Administrative Code 'Minimum Standards For Property Surveys', and that this map is an accurate representation thereof to the best of my knowledge and belief.

Note: This survey plat is not certified unless signed and sealed in red ink.

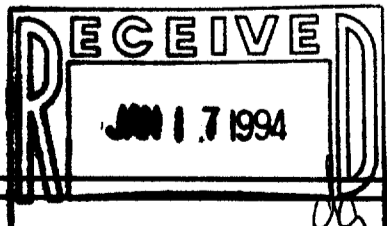

*Thomas P.A. Jensen*  
 Thomas P.A. Jensen R.L.S. 1084

**Jensen Surveying & Mapping S.C.**

Mapping date: August 9, 1993.


45 South Wisconsin Street P.O. Box 322  
 Elkhorn, Wisconsin. 53121.  
 (414) 723-3434

Revisions: 8-17-93

Legend

- Found concrete monument
- Found iron pipe
- ( ) Recorded as dimension
- Fence
- Blacktop surface

Scale: 1" = 30'

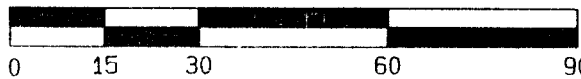

Sheet 1 of 1 Sheets

Job reference number:

1993.087

• SET IRON ROD STFV-251

5-1345