


# KOLB LAND CONSULTING, INC.

LAND SURVEYING • SUBDIVIDING • LAND PLANNING

929 WILLIAMS STREET LAKE GENEVA, WISCONSIN 53147 414 248 3697

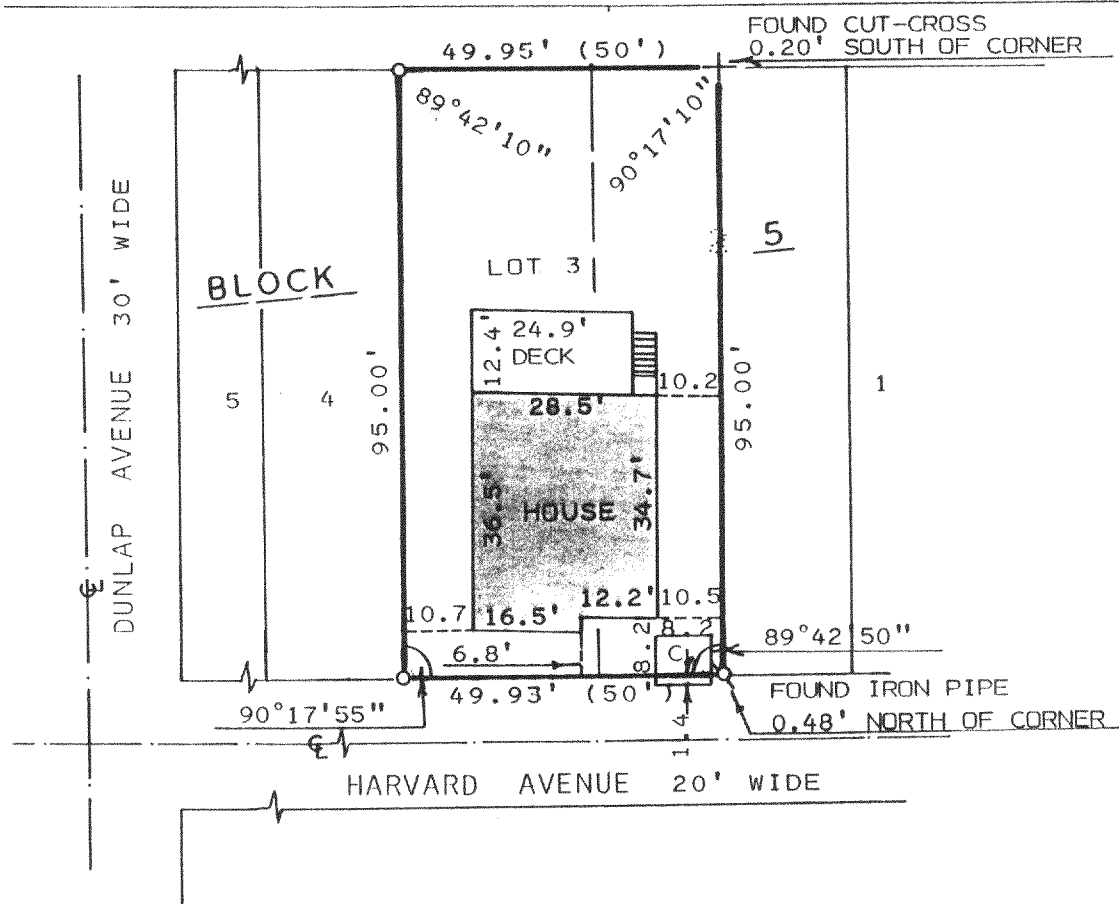

ORDERED BY: MARLENE NICHOLSON  
444 HARVARD AVE.  
FONTANA, WI. 53125

## PLAT OF SURVEY OF

LOT 3 AND THE WEST 1/2 OF LOT 2, BLOCK  
5 OF GLENWOOD SPRINGS SUBDIVISION,  
LOCATED IN THE VILLAGE OF FONTANA-ON-  
GENEVA LAKE, WALWORTH COUNTY, WISCONSIN.




SCALE: 1" = 30'

### LEGEND

- Ø - IRON PIPE FOUND
- O - IRON PIPE SET
- + - CUT-CROSS FOUND
- ( ) - AS RECORDED
- C. - CONCRETE

I, HAROLD H. KOLB, DO HEREBY CERTIFY  
THAT I HAVE SURVEYED THE PROPERTY  
HEREON DESCRIBED ACCORDING TO THE  
OFFICIAL RECORDS AND THAT THE PLAT  
HEREON IS A CORRECT REPRESENTATION  
OF THE LOT LINES AND THE PRINCIPAL  
LINES OF THE BUILDINGS, TO THE BEST  
OF MY KNOWLEDGE AND BELIEF.  
SURVEY NOT VALID UNLESS SURVEYOR'S SIGNATURE  
IS IN RED.

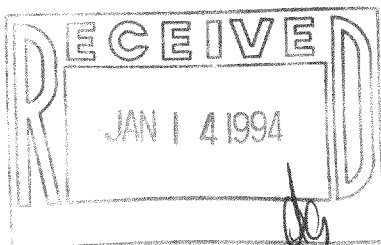

HAROLD H. KOLB

WISCONSIN REGISTERED LAND SURVEYOR, S-187

DATE JULY 29, 1993

REVISED

REVISED

SGS-17

5-1346