


**ABELL
SURVEYING & MAPPING
DELAVER, WISCONSIN 53115
414-728-6737**

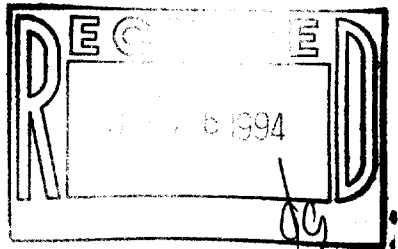

LOT 19

BLOCK

89°12'54"

143.50'

LOT 18

CONCRETE DRIVE

DRAGON LANE

HOUSE

NORTH LINE OF LOT 17

LOT 17

LANE

SHABONA DRIVE

ORDERED BY: THE RAULAND AGENCY
P.O. BOX 159
WALWORTH, WI. 53184

PLAT OF SURVEY OF

LOT 18, BLOCK "C", COUNTRY CLUB ESTATES-UNIT 3 AND THE NORTHERLY 48 FEET AS MEASURED ALONG THE EASTERLY LINE AND 30 FEET AS MEASURED ALONG THE WESTERLY LINE OF LOT 17, BLOCK "C" COUNTRY CLUB ESTATES-UNIT 3, VILLAGE OF FONTANA, WALWORTH COUNTY, WISCONSIN.

I HEREBY CERTIFY THAT I HAVE SURVEYED THE ABOVE DESCRIBED PROPERTY AND THAT THE ABOVE MAP IS A TRUE REPRESENTATION THEREOF AND SHOWS THE SIZE AND LOCATION OF THE PROPERTY, ITS EXTERIOR BOUNDARIES, THE LOCATION OF ALL VISIBLE STRUCTURES AND DIMENSIONS OF ALL PRINCIPAL BUILDINGS THEREON, BOUNDARY FENCES, APPARENT EASEMENTS, ROADWAYS AND VISIBLE ENCROACHMENTS, IF ANY, TO THE BEST OF MY KNOWLEDGE AND BELIEF.

THIS SURVEY IS MADE FOR THE USE OF THE PRESENT OWNERS OF THE PROPERTY, AND ALSO THOSE WHO PURCHASE, MORTGAGE, OR GUARANTEE THE TITLE THERETO WITHIN ONE (1) YEAR FROM DATE HEREON.

David F. Abell

DAVID F. ABELL
WISCONSIN REGISTERED LAND SURVEYOR. S-1596

December 13, 1993

DATE JOB NUMBER - 93187
NOTE: THIS IS NOT A CERTIFIED COPY UNLESS SEALED.

N



SCALE 1"=30'

LEGEND

- ⊙ -IRON PIPE FOUND
- △ -UTILITY POLE
- GUY WIRE
- () -RECORDED AS

SC03-46

5-1353