
SURVEYING & MAPPING

DELAVAN, WISCONSIN 53115 414-728-6737

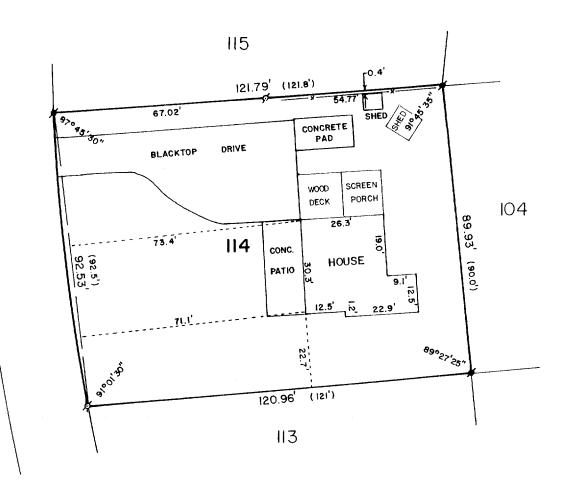


PLAT OF SURVEY OF

LOT 114 OF UNIT 2 OF COUNTRY CLUB ESTATES, LOCATED IN THE VILLAGE OF FONTADA-ON-GENEVA LAKE, WALWORTH COUNTY, WISCONSIN.

ORDERED BY: THE RAULAND AGENCY 118 KENOSHA STREET VALWORTH, WI. 53184

REVISED: APRIL 25, 1994 ORDERED BY: COLDWÉLL BANKER GENEVA LAKES 836 MAIN STREET LAKE GENEVA, WI 53147

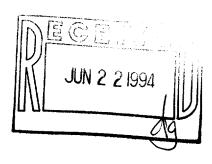



SCALE - 1"=30"

LEGEND

- IRON PIPE FOUND CONCRETE MONUMENT

FOUND FENCE

SAUGONASH

DRIVE

)- RECORDED AS

I HEREBY CERTIFY THAT I HAVE SURVEYED THE ABOVE DESCRIBED PROPERTY AND THAT THE ABOVE MAP IS A TRUE REPRESENTATION THEREOF AND SHOWS THE SIZE AND LOCATION OF THE PROPERTY, ITS EXTERIOR BOUNDARIES, THE LOCATION OF ALL VISIBLE STRUCTURES AND DIMENSIONS OF ALL PRINCIPAL BUILDINGS THEREON, BOUNDARY FENCES, APPARENT EASEMENTS, ROADWAYS AND VISIBLE ENCROACHMENTS, IF ANY, TO THE BEST OF MY KNOWLEDGE AND BELIEF.

THIS SURVEY IS MADE FOR THE USE OF THE PRESENT OWNERS OF THE PROPERTY, AND ALSO THOSE WHO PURCHASE, MORTGAGE, OR GUARANTEE THE TITLE THERETO WITHIN ONE (1) YEAR FROM DATE HEREOF.

DAVID F. ABELL WISCONSIN REGISTERED LAND SURVEYOR, S-1596

REVISED: 4/25/94

NUMBER - 88252 NOTE: THIS IS NOT A CERTIFIED COPY UNLESS SEALED.

Sc02-108