ABERNATHY and ASSOCIATES Kenneth B. Abernathy Jr.

Wisconsin Registered Land Surveyor 5-1594

Rt. 3, Box 273

Elkhorn, Wisconsin 53121 Phone: (414) 723-4260 (office) (414) 723-4813 (residence)

PLAT OF SURVEY

Parcel "AA"


The Westerly 66.00 feet of Lot 7 and the Easterly 12.00 feet of Lot 8 of Glenwood Terrace Subdivision, as recorded in Volume 10, Page 11 of Plats, Dated July 2. 1928, being located in the North 1/2 of the Northeast 1/4 of the Northeast 1/4 of Section 23, Town 1 North, Range 16 East, Village of Fontana, County of Walworth, State of Wisconsin, more particularly described as follows;

Commencing at a Found Concrete Monument at the Northeast Corner of said Section 23, thence S 87°28'00" W along the North Line of said Section 33.00 feet to a Found Concrete Monument on the West Right-of-way Line of Indian Hills Road; thence S 2°21'56" E (recorded as S 2°29' E 464.20 feet) along said right-of-way line 464.12 feet to an Iron Pipe on the South Right-of-way Line of Forest Drive; thence S 87°28'07" W along said South Right-of-way Line 449.46 feet (recorded as 449.90 feet) to an Iron Pipe at a point 5.99 feet (recorded as 6.00 feet) Westerly from the Northeast Corner of Lot 7 and the point of beginning; thence continue S 87'28'07" W along said right-of-way line 77.92 feet (recorded as 78.00 feet) to an Iron Pipe; thence S 2*38'01" E 192.79 feet to an Iron Pipe on the South Line of said subdivision; thence N 87°30'46" E (recorded as N 87°21' E 78.00 feet) along said south line 77.92 feet to an Iron Pipe; thence N 2'38'01" W 192.85 feet to the point of beginning. Said parcel contains 0.345 Acres of land more or less and is subject to easements recoreded or unrecorded.

Owners: Glenwood Terrace Limited Partnership

Ordered by: John O'Neill O'Neill Builders, Inc. Post Office Box 351 Fontana, Wisconsin

53125-0351

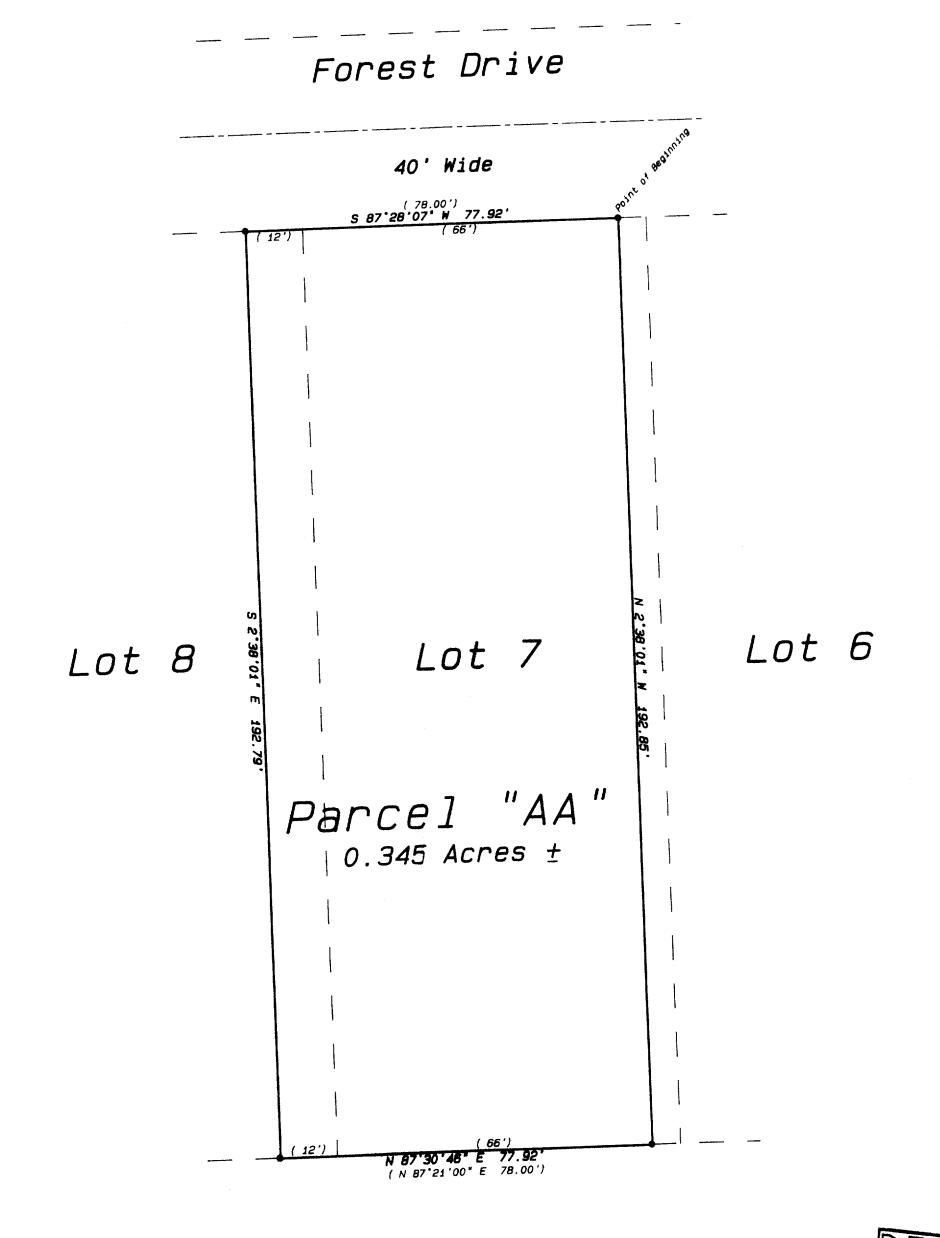

Legend

- FOUND IRON PIPE
- FOUND IRON ROD
- FOUND BRASS CAPPED MONUMENT FOUND CONCRETE MONUMENT
- CHISEL CUT IN CONCRETE
- SET IRON PIPE, 24" LONG, WEIGHING
- 4.5 LBS./LINEAL FT., 1-11/16" DIA.
- (xx) RECORDED AS DIMENSION

-x-x- EXISTING FENCE





SCALE: 1"= 20 FEET

"I hereby certify that I have surveyed the above described property and that the above map is a true representation thereof and shows the size and location of the property, its exterior boundaries, the location of all visible structures and dimensions of all principal buildings thereon, boundary ments, if any.'

the property, and also those who purchase, mortgage

KENNETH B. ABERNATHY, JR. WISCONSIN REGISTERED LAND SURVEYOR,

S-1594 . Job No. <u>1994.</u> 79

Date: July 20, 1994

MM5-1391