


Lot 13

Lot 12

Lot 11

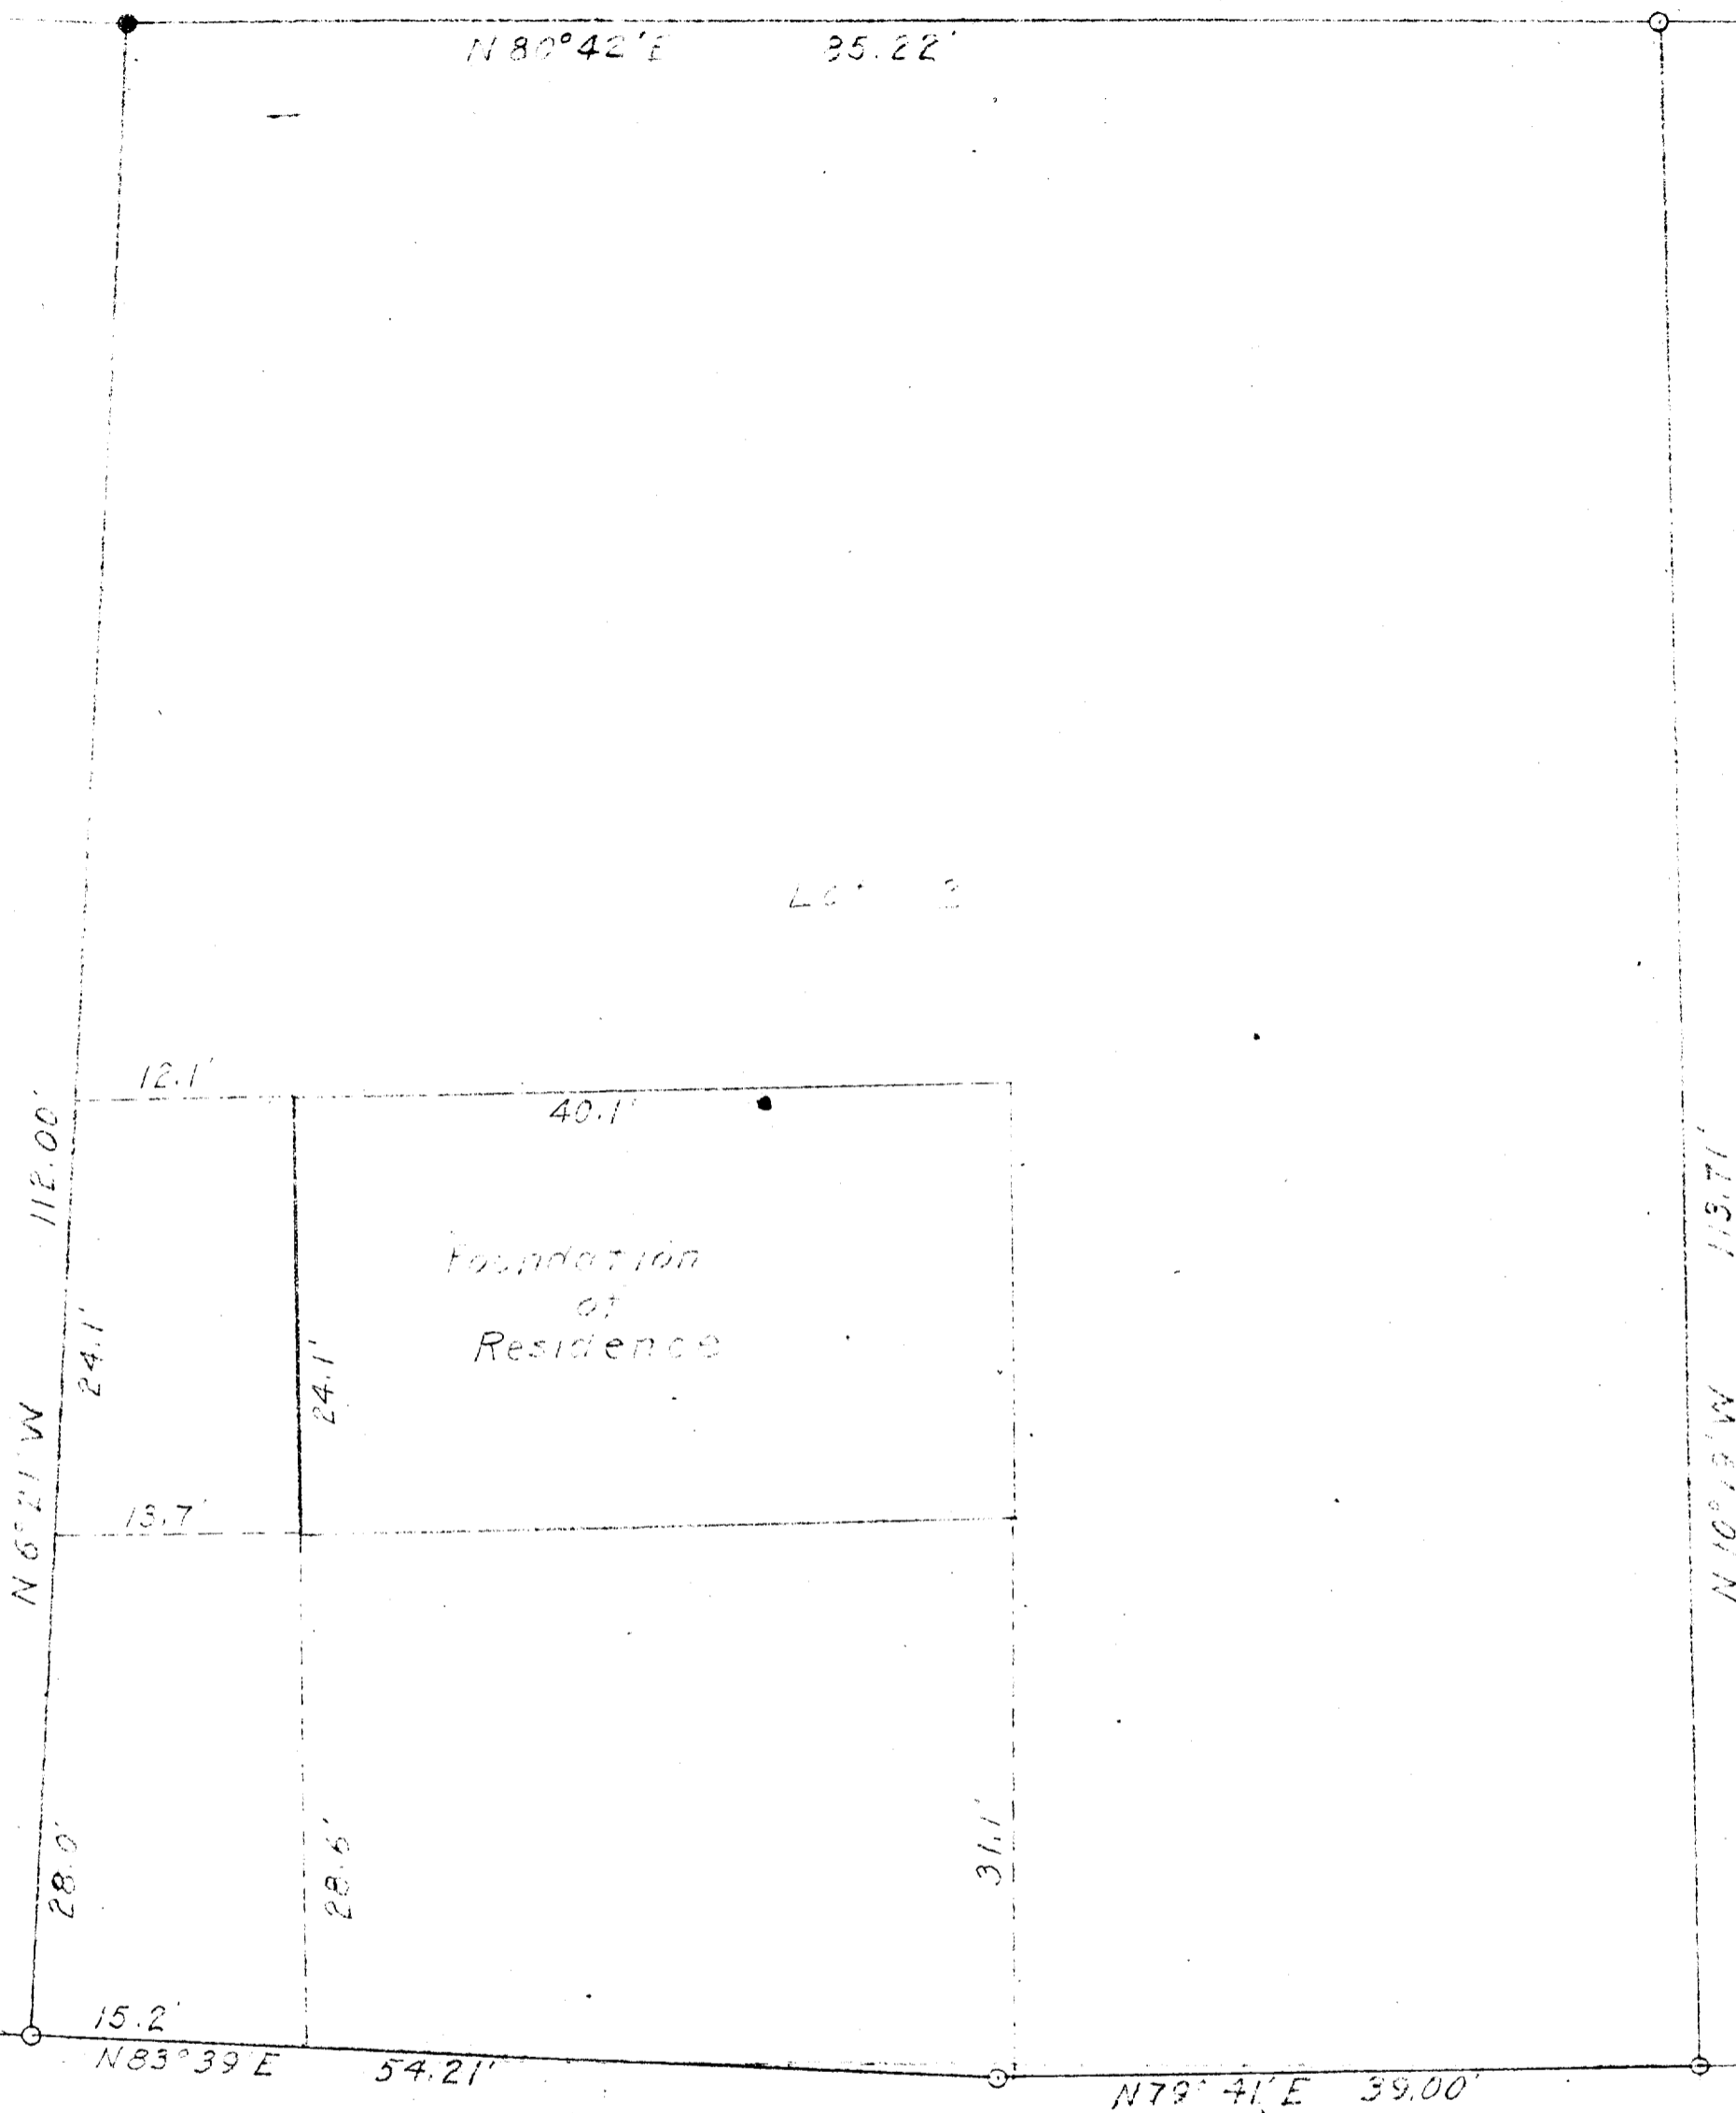

Woodland Drive


- - Iron Pipe
- - Concrete Monument

State of Wisconsin  
County of Walworth

I, Lloyd L. Jensen, do hereby certify that I have surveyed the property hereon described according to the official records, and that the plat hereon is a correct representation of the Lot lines and principal lines of buildings thereon.

July, 1957

*Lloyd L. Jensen*  
Surveyor

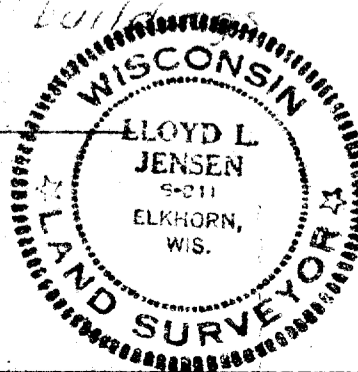

### PLAT OF SURVEY OF

Lot 12, Addition E to Country Club Estates, Village of Fontana-on-Geneva Lake, Walworth County, Wisconsin.

*Lloyd L. Jensen*  
Surveyor

SCALE 1" = 10'

DATE July, 1957