

ROBERS & FISCHER, INC.

~~HOGANSON & ROBERS, INC.~~

CONSULTING ENGINEERS & LAND SURVEYORS

PHONE (414) 763-2652

116 E. CHESTNUT ST.

BURLINGTON, WIS. 53105


LOT 6, BLOCK 5, C. L. DOUGLAS
SUB. (ASSESSOR PLAT NO. 1), VILLAGE
OF FONTANA, WALWORTH CO., WIS.

49.5'

ST.
S

SS FONTANA


AVE. SS

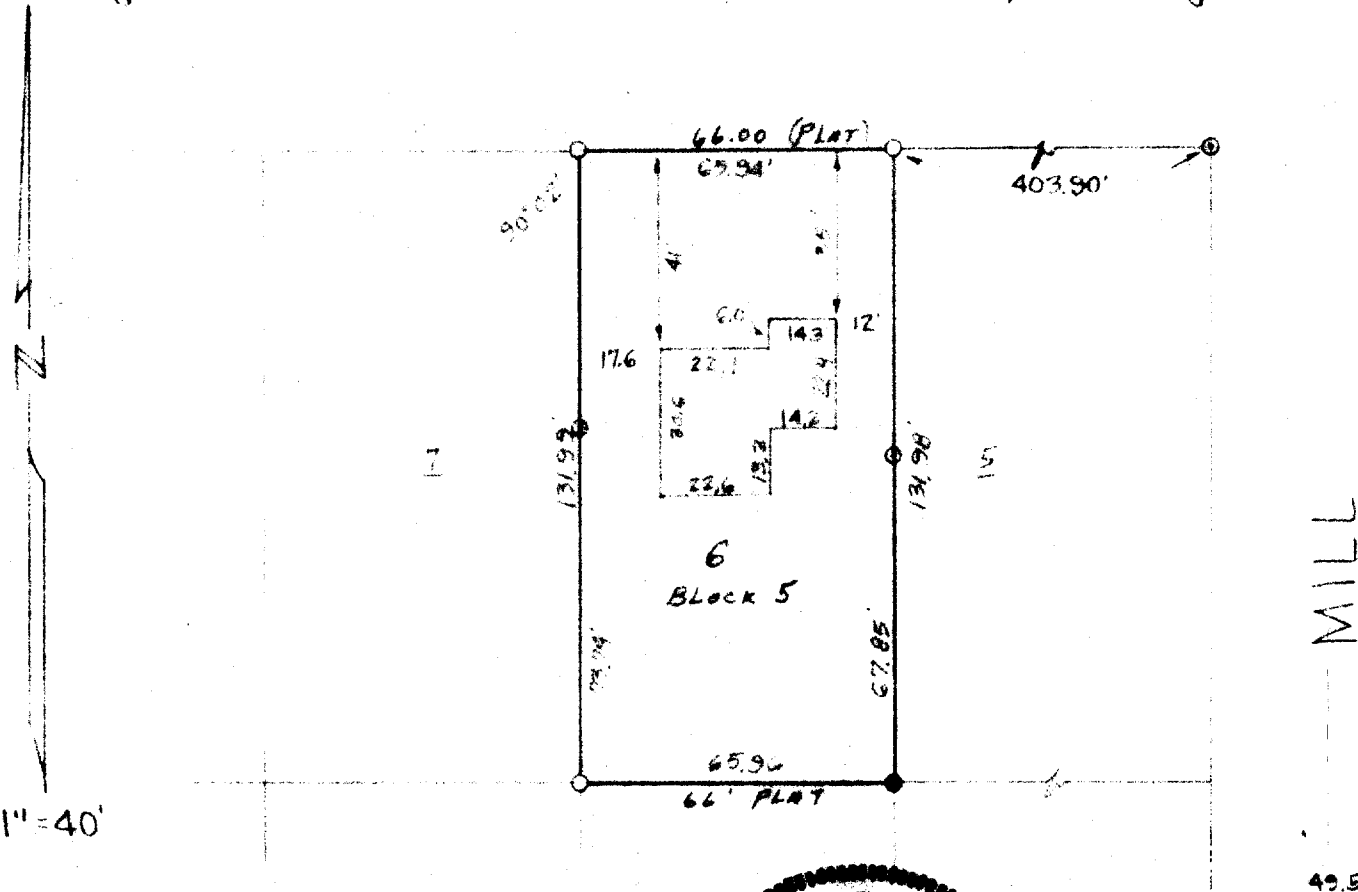

1" = 40'

Block 5 North Line 0.95' SHORT OR
0.00086 Ft/Ft

66' LOT = 65.94'

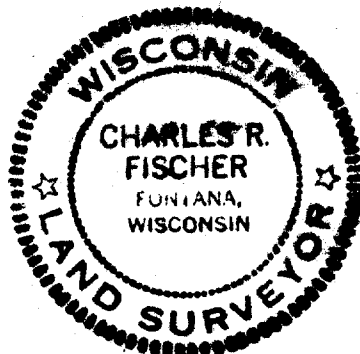

MONUMENT KEY

- IRON PIPE SET
- CONC. MON. FOUND
- IRON PIPE FOUND

I HEREBY CERTIFY THAT WE HAVE SURVEYED THE LANDS DESCRIBED
ABOVE ACCORDING TO OFFICIAL RECORDS AND THAT THE PLAT
DRAWN HEREON IS A CORRECT REPRESENTATION OF SAID SURVEY.

Charles R. Fischer
WIS. REG. LAND SURVEYOR 5-821

DATE 7-8-70

5-151

JOB NO. 70092