


**ABELL
SURVEYING & MAPPING
DELAVAN, WISCONSIN 53115
414-728-6737**

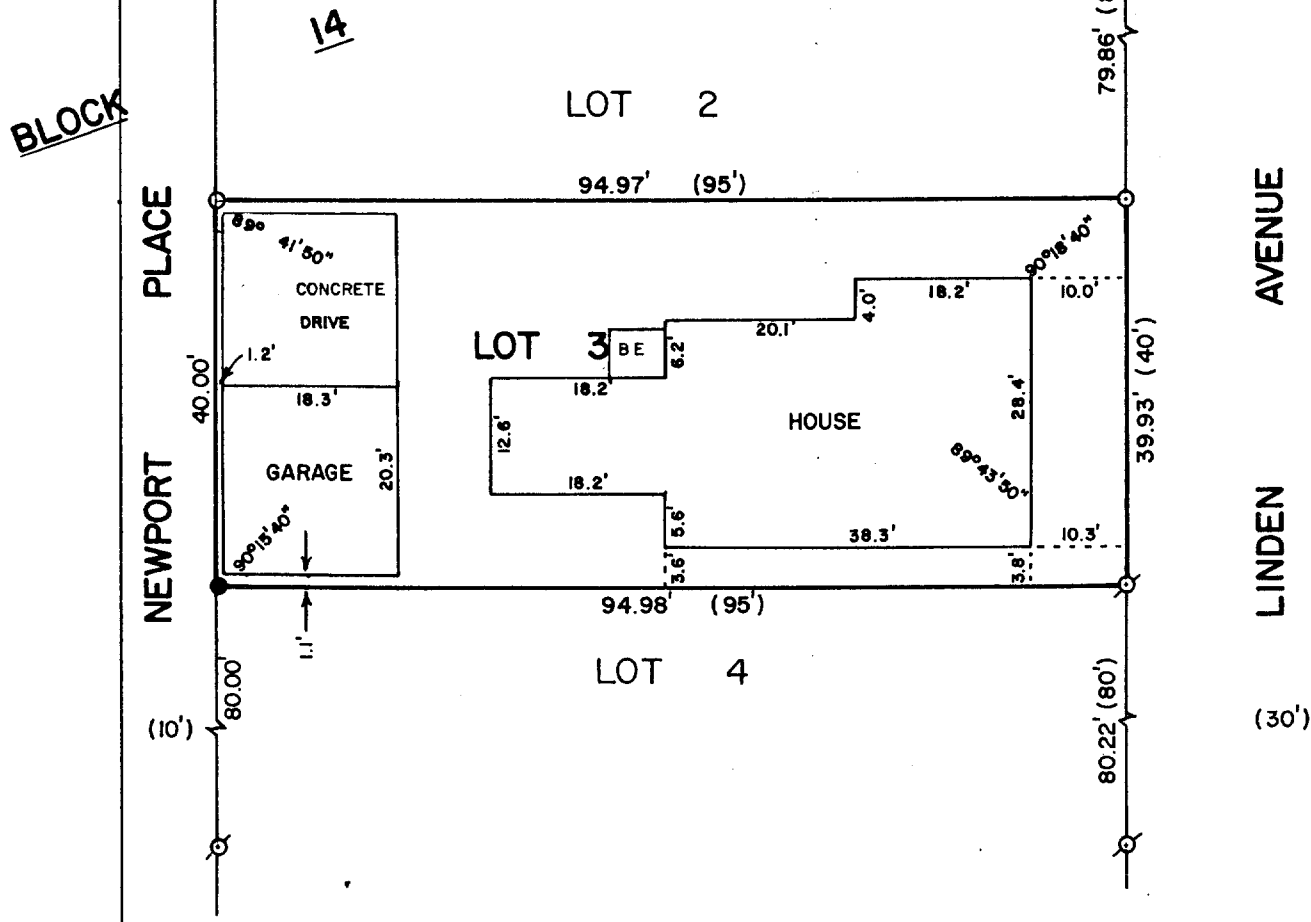


PLAT OF SURVEY OF

LOT 3, BLOCK 14 OF GLENWOOD SPRINGS, LOCATED IN THE VILLAGE OF FONTANA-ON-GENEVA, WALWORTH COUNTY, WISCONSIN.

ORDERED BY: KEEFE REAL ESTATE
P.O BOX 268
WALWORTH, WI. 53184

REVISED: SEPT. 19, 1995
ORDERED BY: SEMMELMAN & BERTUCCI
191 E. DEERPATH
LAKE FOREST, IL 60045

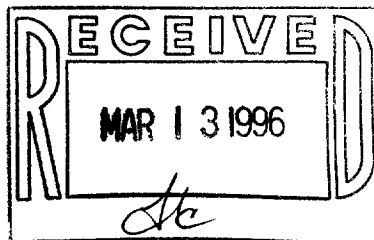

SCALE - 1"=20'

LEGEND

- ⊙ - IRON PIPE FOUND
- - IRON ROD FOUND
- - CONCRETE MONUMENT FOUND
- - IRON ROD SET FOUND 9/18/95
- () - RECORDED AS
- BE - BASEMENT ENTRY

I, DAVID F. ABELL, DO HEREBY CERTIFY THAT I HAVE SURVEYED THE PROPERTY HEREON DESCRIBED ACCORDING TO THE OFFICIAL RECORDS AND THAT THE PLAT HEREON IS A CORRECT REPRESENTATION OF THE PROPERTY LINES TO THE BEST OF MY KNOWLEDGE AND BELIEF.

David F. Abell
DAVID F. ABELL
WISCONSIN REGISTERED LAND SURVEYOR, S-1596

October 27, 1987 REVISED: 9/19/95
DATE JOB NUMBER - 87165

NOTE: THIS IS NOT A CERTIFIED COPY UNLESS SEALED.

SGS-83
005-1521