


# PLAT OF SURVEY

PATHFINDER SURVEYING  
929 WILLIAMS ST. LAKE GENEVA, WI.  
(414) 248-3897

ORDERED BY : KENNETH STRUCK  
489 S. SHORE DRIVE  
FONTANA, WI.

DATE: 5/15/97

DESCRIPTION: LOT 2 OF CERTIFIED SURVEY MAP NO. 1037 LOCATED IN OUTLOT 91 OF THE ASSESSORS PLAT OF THE VILLAGE OF FONTANA-ON-GENEVA LAKE, WALWORTH COUNTY, WISCONSIN.

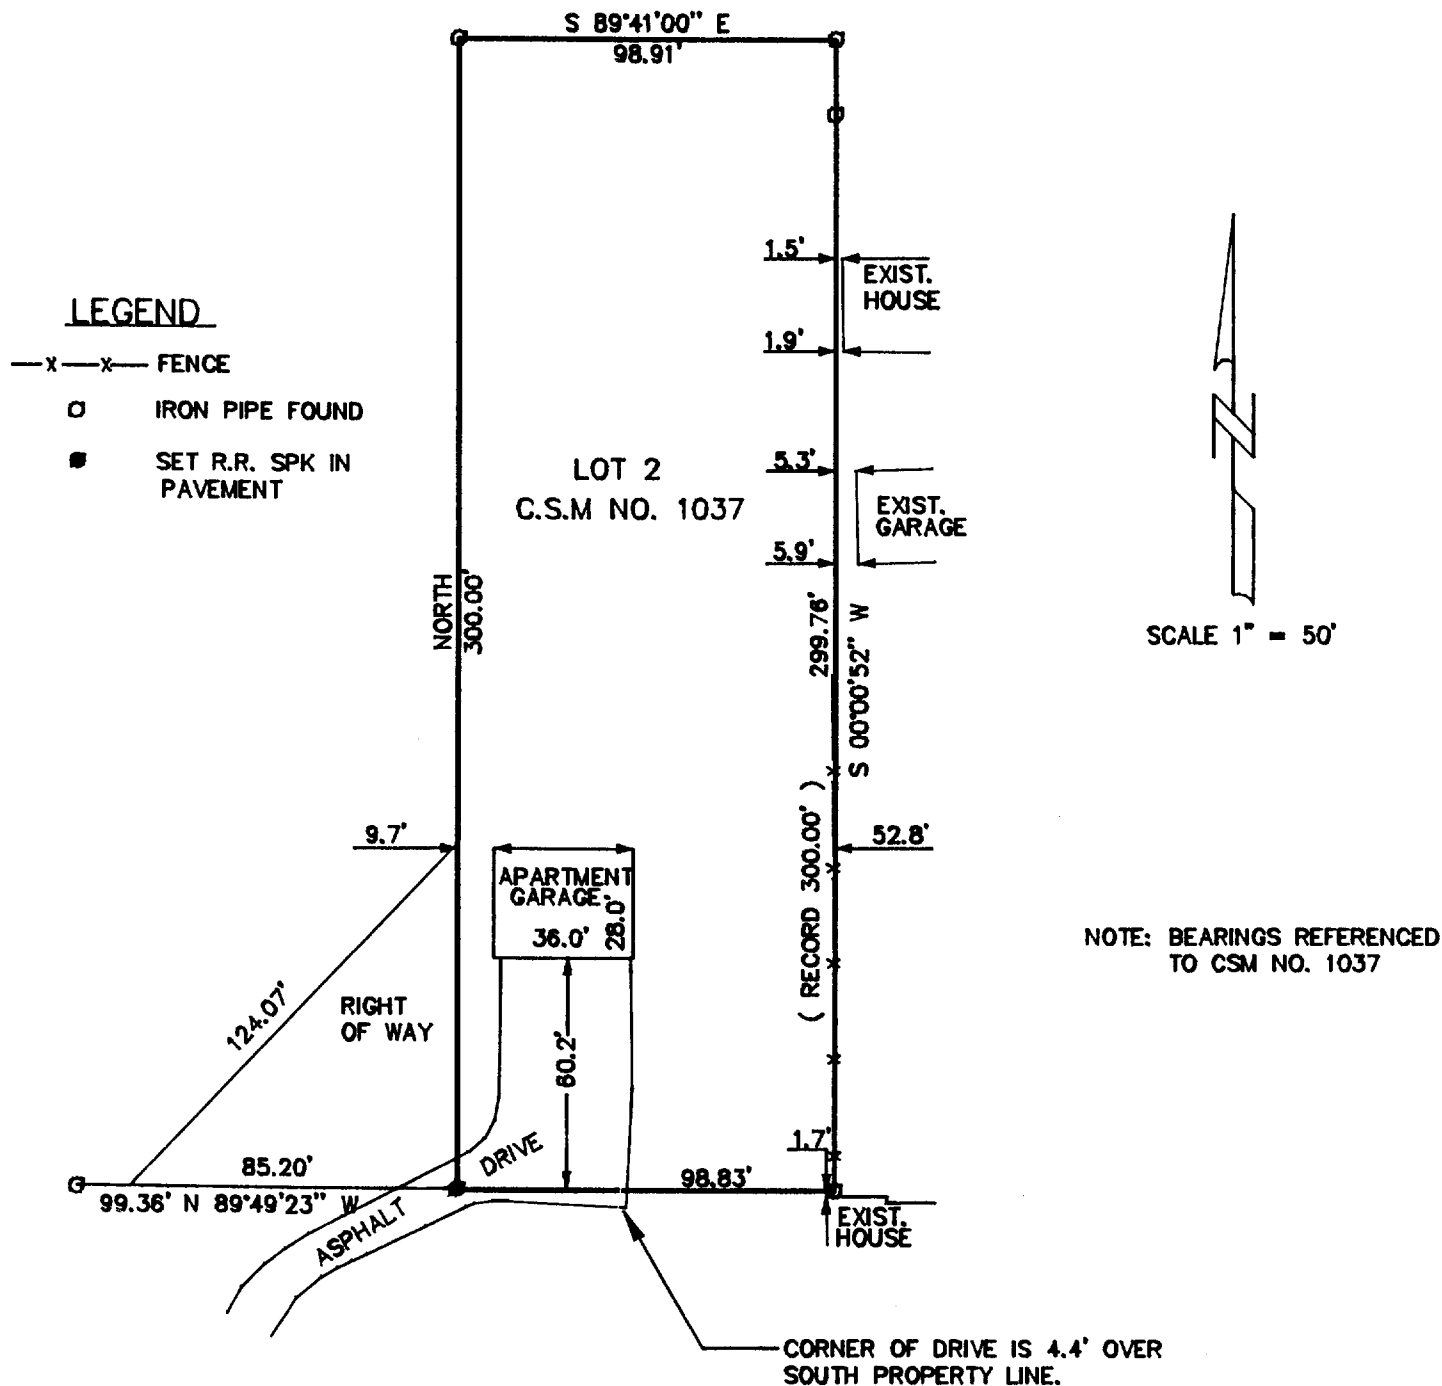


NOTE: LOCATION OF RIGHT OF WAY TAKEN FROM PREVIOUS SURVEYS ON RECORD. NO TITLE SEARCH PERFORMED FOR RIGHT OF WAY LOCATION.

THE ABOVE MAP IS A TRUE REPRESENTATION THEREOF AND SHOWS THE SIZE AND LOCATION OF ALL THE PROPERTY, EXTERIOR BOUNDARIES, THE LOCATION OF ALL VISIBLE BOUNDARY FENCES, APPARENT EASEMENTS, ROADWAYS AND VISIBLE ENCROACHMENTS, IF ANY.

THIS SURVEY IS MADE FOR THE USE OF THE PRESENT OWNERS OF THE PROPERTY, AND ALSO THOSE WHO PURCHASE, MORTGAGE OR GUARANTEE TITLE THERETO WITHIN ONE (1) YEAR FROM DATE HERETO.

*John P. Krott*  
JOHN P. KROTT, R.L.S. 2258

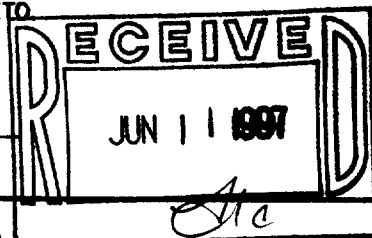

NOTE: THIS IS NOT A CERTIFIED COPY UNLESS SEAL IS IN RED.

JOB NUMBER 97016

005-1574

SA-1037-2