


1140 SEQUOIA STREET • DELAVAN, WISCONSIN 53115
414-728-6737




12

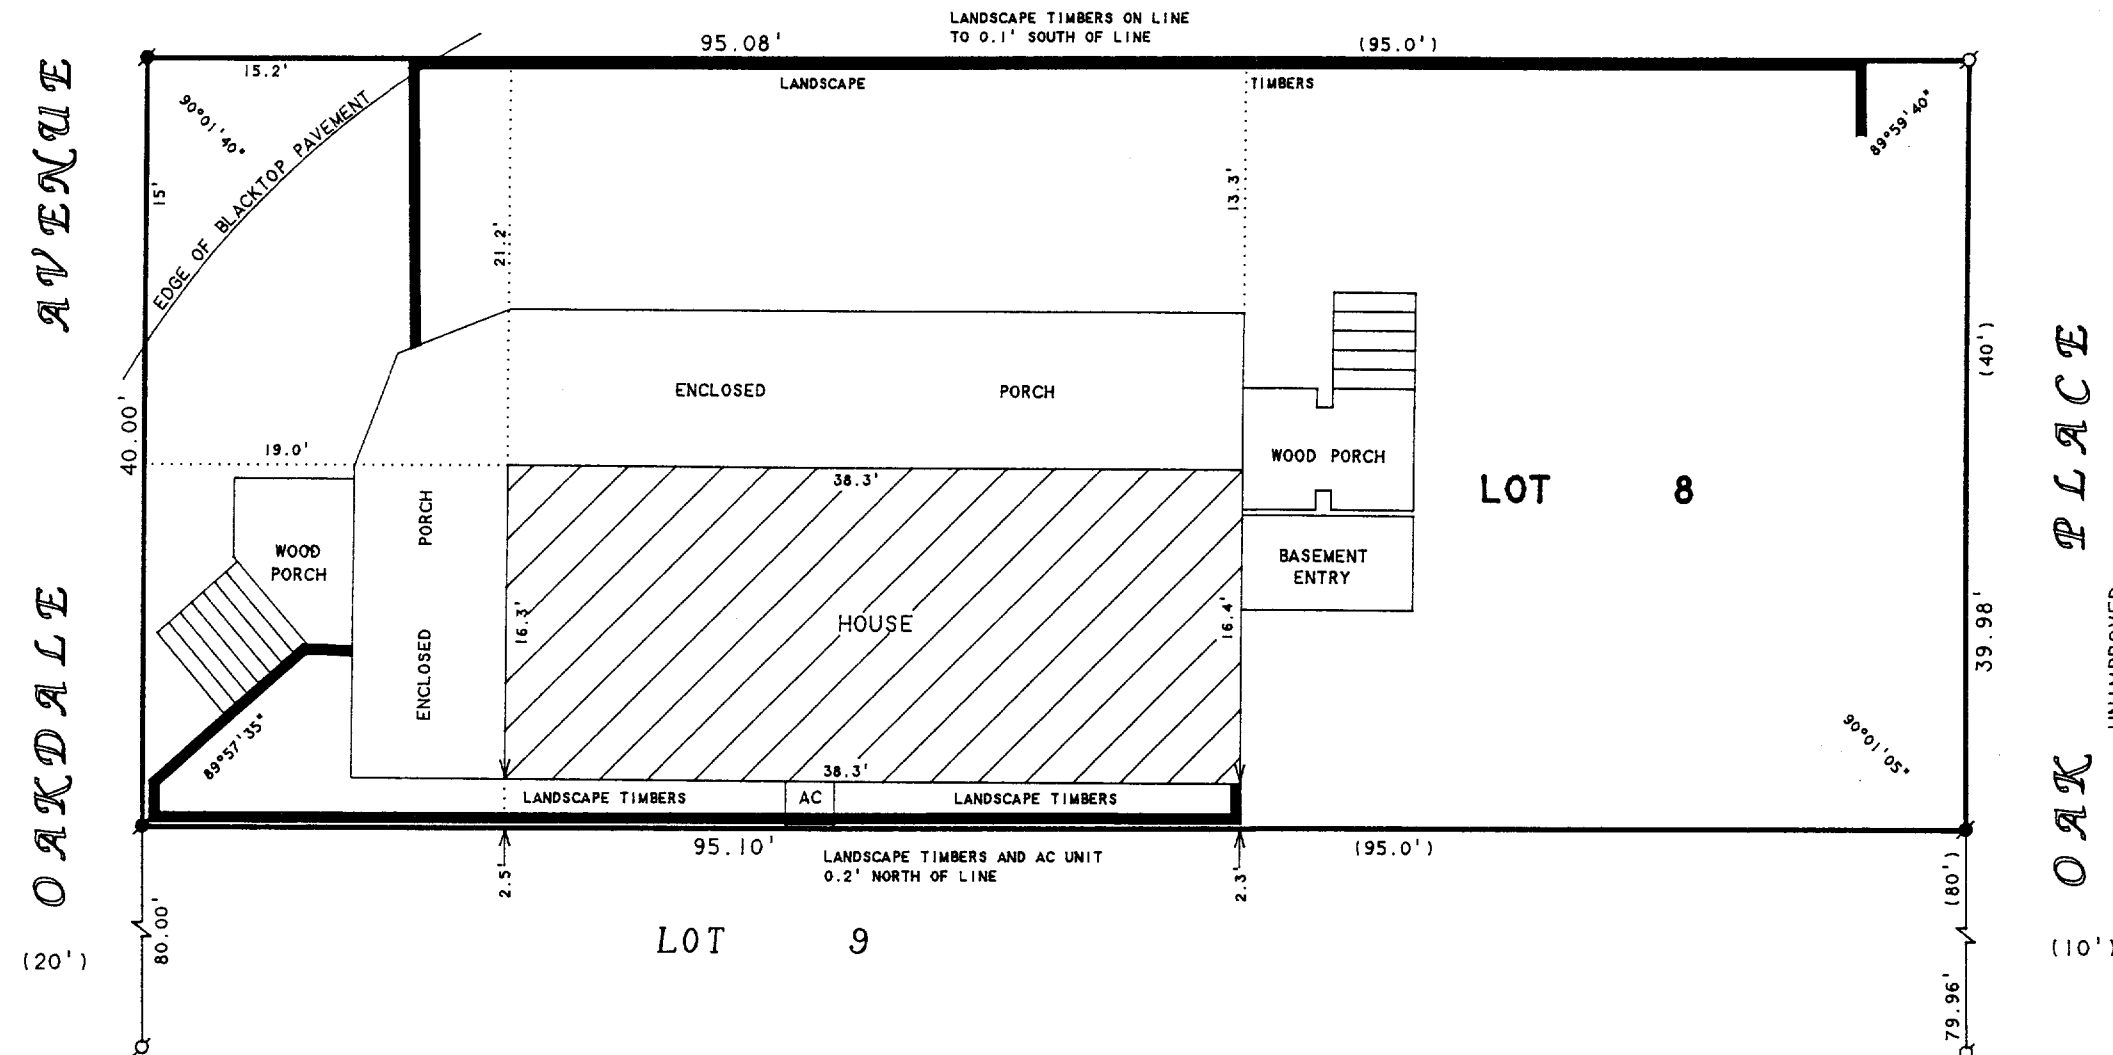

SCALE 1" = 10'

LEGEND

♂ - IRON PIPE FOUND
 ● - IRON ROD FOUND
 () - RECORDED AS

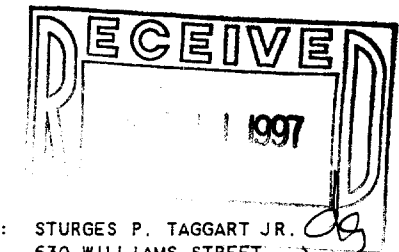

ORDERED BY: STURGES P. TAGGART JR.
630 WILLIAMS STREET
LAKE GENEVA, WI 53147

LOT 8, BLOCK 12 OF GLENWOOD SPRINGS, A SUBDIVISION
LOCATED IN THE VILLAGE OF FONTANA-ON-GENEVA LAKE,
WALWORTH COUNTY, WISCONSIN.

I HEREBY CERTIFY THAT I HAVE SURVEYED THE ABOVE DESCRIBED PROPERTY AND THAT THE ABOVE MAP IS A TRUE REPRESENTATION THEREOF AND SHOWS THE SIZE AND LOCATION OF THE PROPERTY, ITS EXTERIOR BOUNDARIES, THE LOCATION OF ALL VISIBLE STRUCTURES AND DIMENSIONS OF ALL PRINCIPAL BUILDINGS THEREON, BOUNDARY FENCES, APPARENT EASEMENTS, ROADWAYS AND VISIBLE ENCROACHMENTS, IF ANY, TO THE BEST OF MY KNOWLEDGE AND BELIEF.

THIS SURVEY IS MADE FOR THE USE OF THE PRESENT OWNERS OF THE PROPERTY, AND ALSO THOSE WHO PURCHASE, MORTGAGE, OR GUARANTEE THE TITLE THERETO WITHIN ONE (1) YEAR FROM DATE HEREON.

David F. Bell

DAVID F. ABELL
WISCONSIN REGISTERED LAND SURVEYOR, S-1596

July 3, 1997

DATE _____ JOB NUMBER - 88041
NOTE: THIS IS NOT A CERTIFIED COPY UNLESS SEALED.

SCS-66
005-1578