



NOTE: BEARINGS ARE REFERENCED TO THE
RECORDED SUBDIVISION PLAT.

ABELL
SURVEYING & MAPPING
DELAVAN, WISCONSIN 53115
414-728-6737

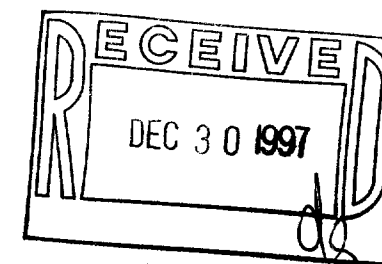

N

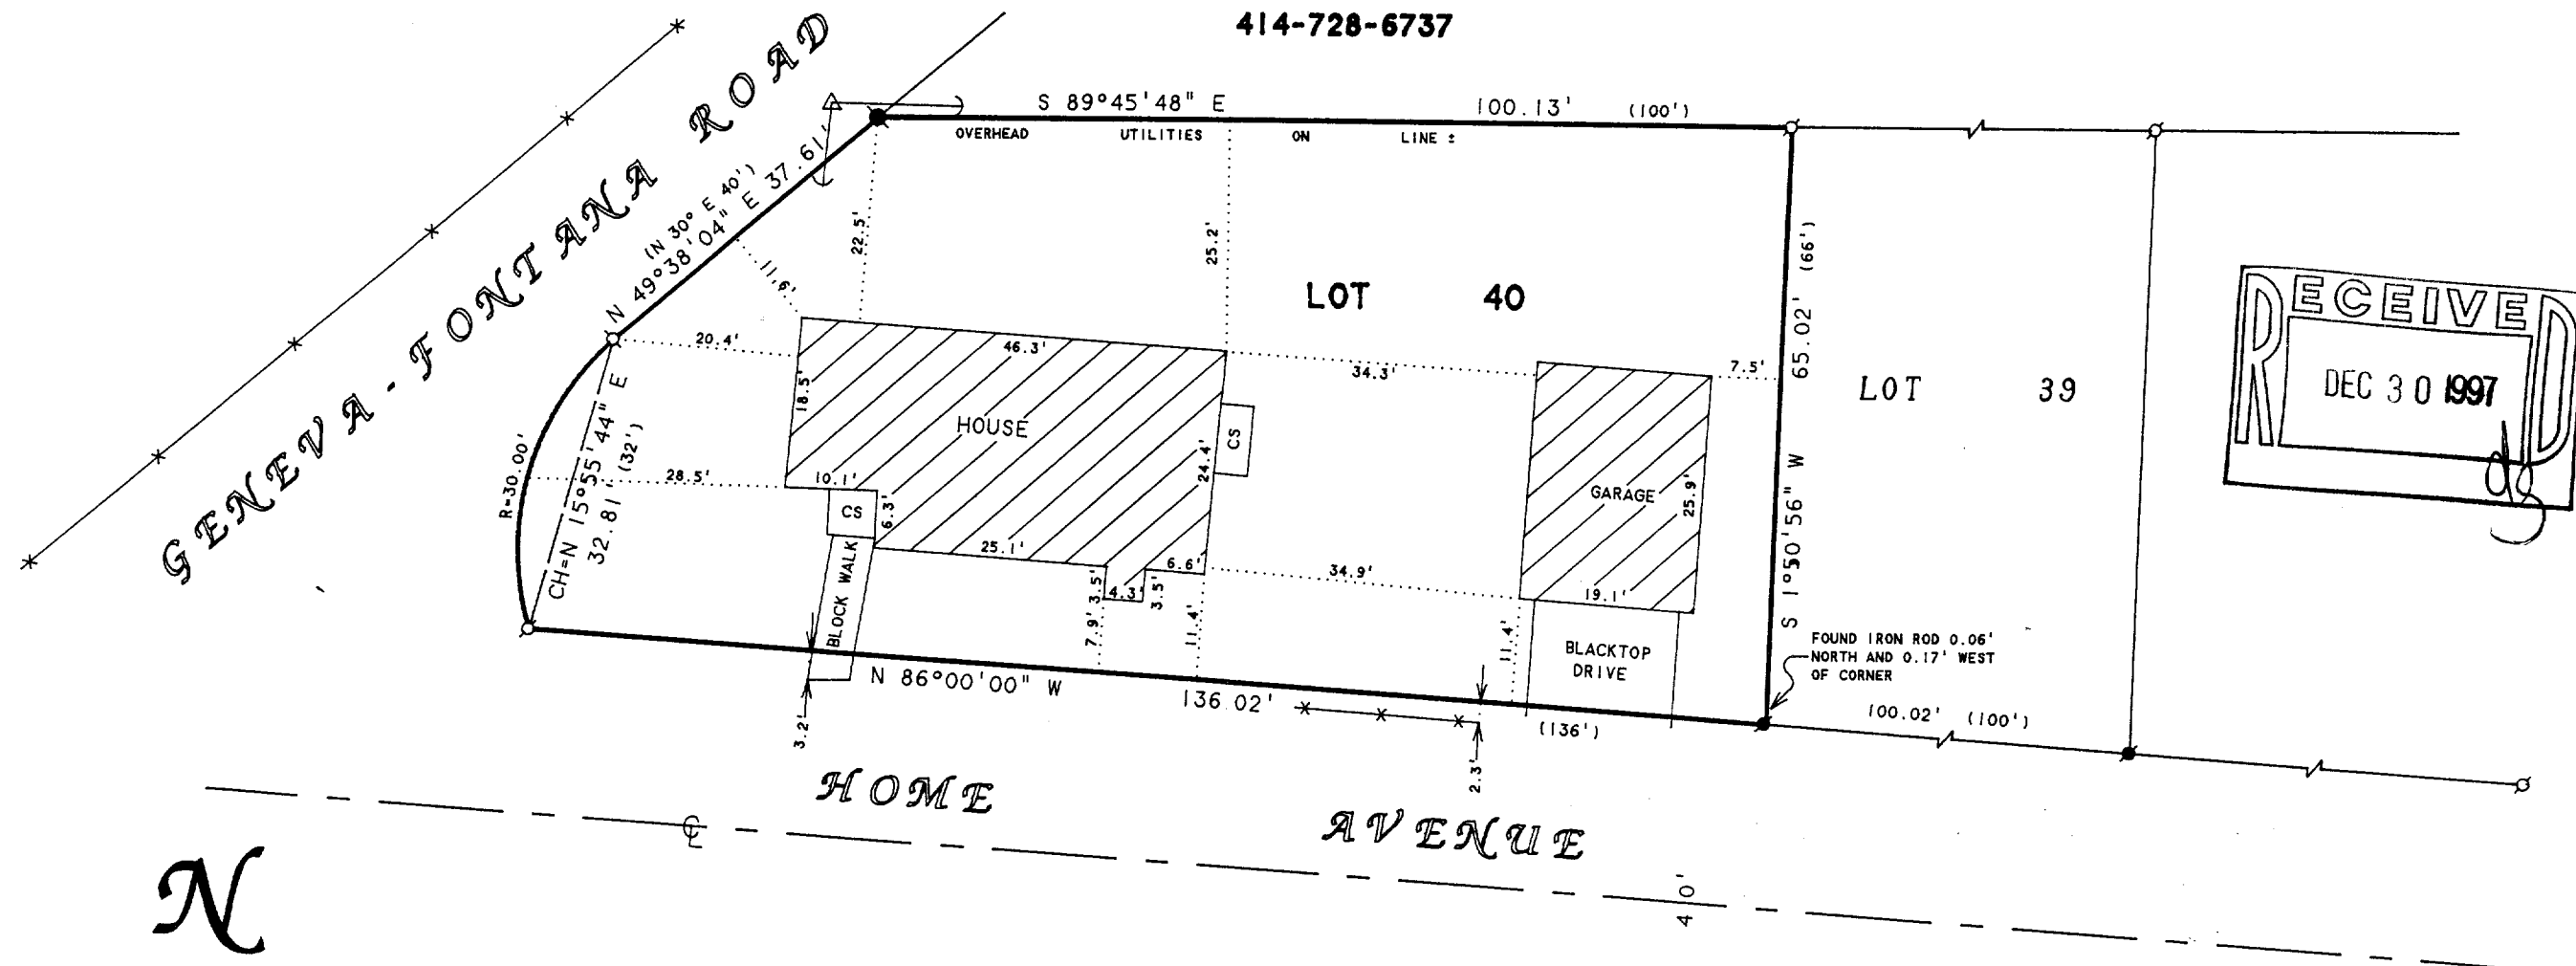

SCALE 1"=20'

LEGEND

- - IRON PIPE FOUND
- - IRON ROD FOUND
- - IRON BAR FOUND
- CS - CONCRETE STOOP
- △ - UTILITY POLE
- - GUY WIRE
- * - WIRE FENCE
- () - RECORDED AS

PLAT OF SURVEY OF

LOT 40, BUENA VISTA PARK, LOCATED IN THE VILLAGE OF
FONTANA, WALWORTH COUNTY, WISCONSIN.

ORDERED BY: JOE SCHILTZ
330 HOME AVENUE
FONTANA, WI 53125

I, DAVID F. ABELL, DO HEREBY CERTIFY THAT I HAVE SURVEYED THE PROPERTY HEREON
DESCRIBED ACCORDING TO THE OFFICAL RECORDS AND THAT THE PLAT HEREON IS A
CORRECT REPRESENTATION OF THE PROPERTY LINES TO THE BEST OF MY KNOWLEDGE AND
BELIEF.

David F. Abell

DAVID F. ABELL
WISCONSIN REGISTERED LAND SURVEYOR, S-1596

December 3, 1997

DATE JOB NUMBER - 97210
NOTE: THIS IS NOT A CERTIFIED COPY UNLESS SEALED.

005-1629

SBV-28