


PLAT OF SURVEY

LOT 6 OF COUNTRY CLUB ESTATES  
ADDITION "K", LOCATED IN THE VILLAGE  
OF FONTANA - ON - GENEVA LAKE,  
WALWORTH COUNTY, WISCONSIN.

OWNERS: BRADLEY AND REBECCA FIDELER  
1006 DAVIS CT.  
FONTANA, WI. 53125


Ordered by: Matt Miller  
The Rauland Agency, Inc.  
Post Office Box 159  
Walworth, Wisconsin  
53184-0159

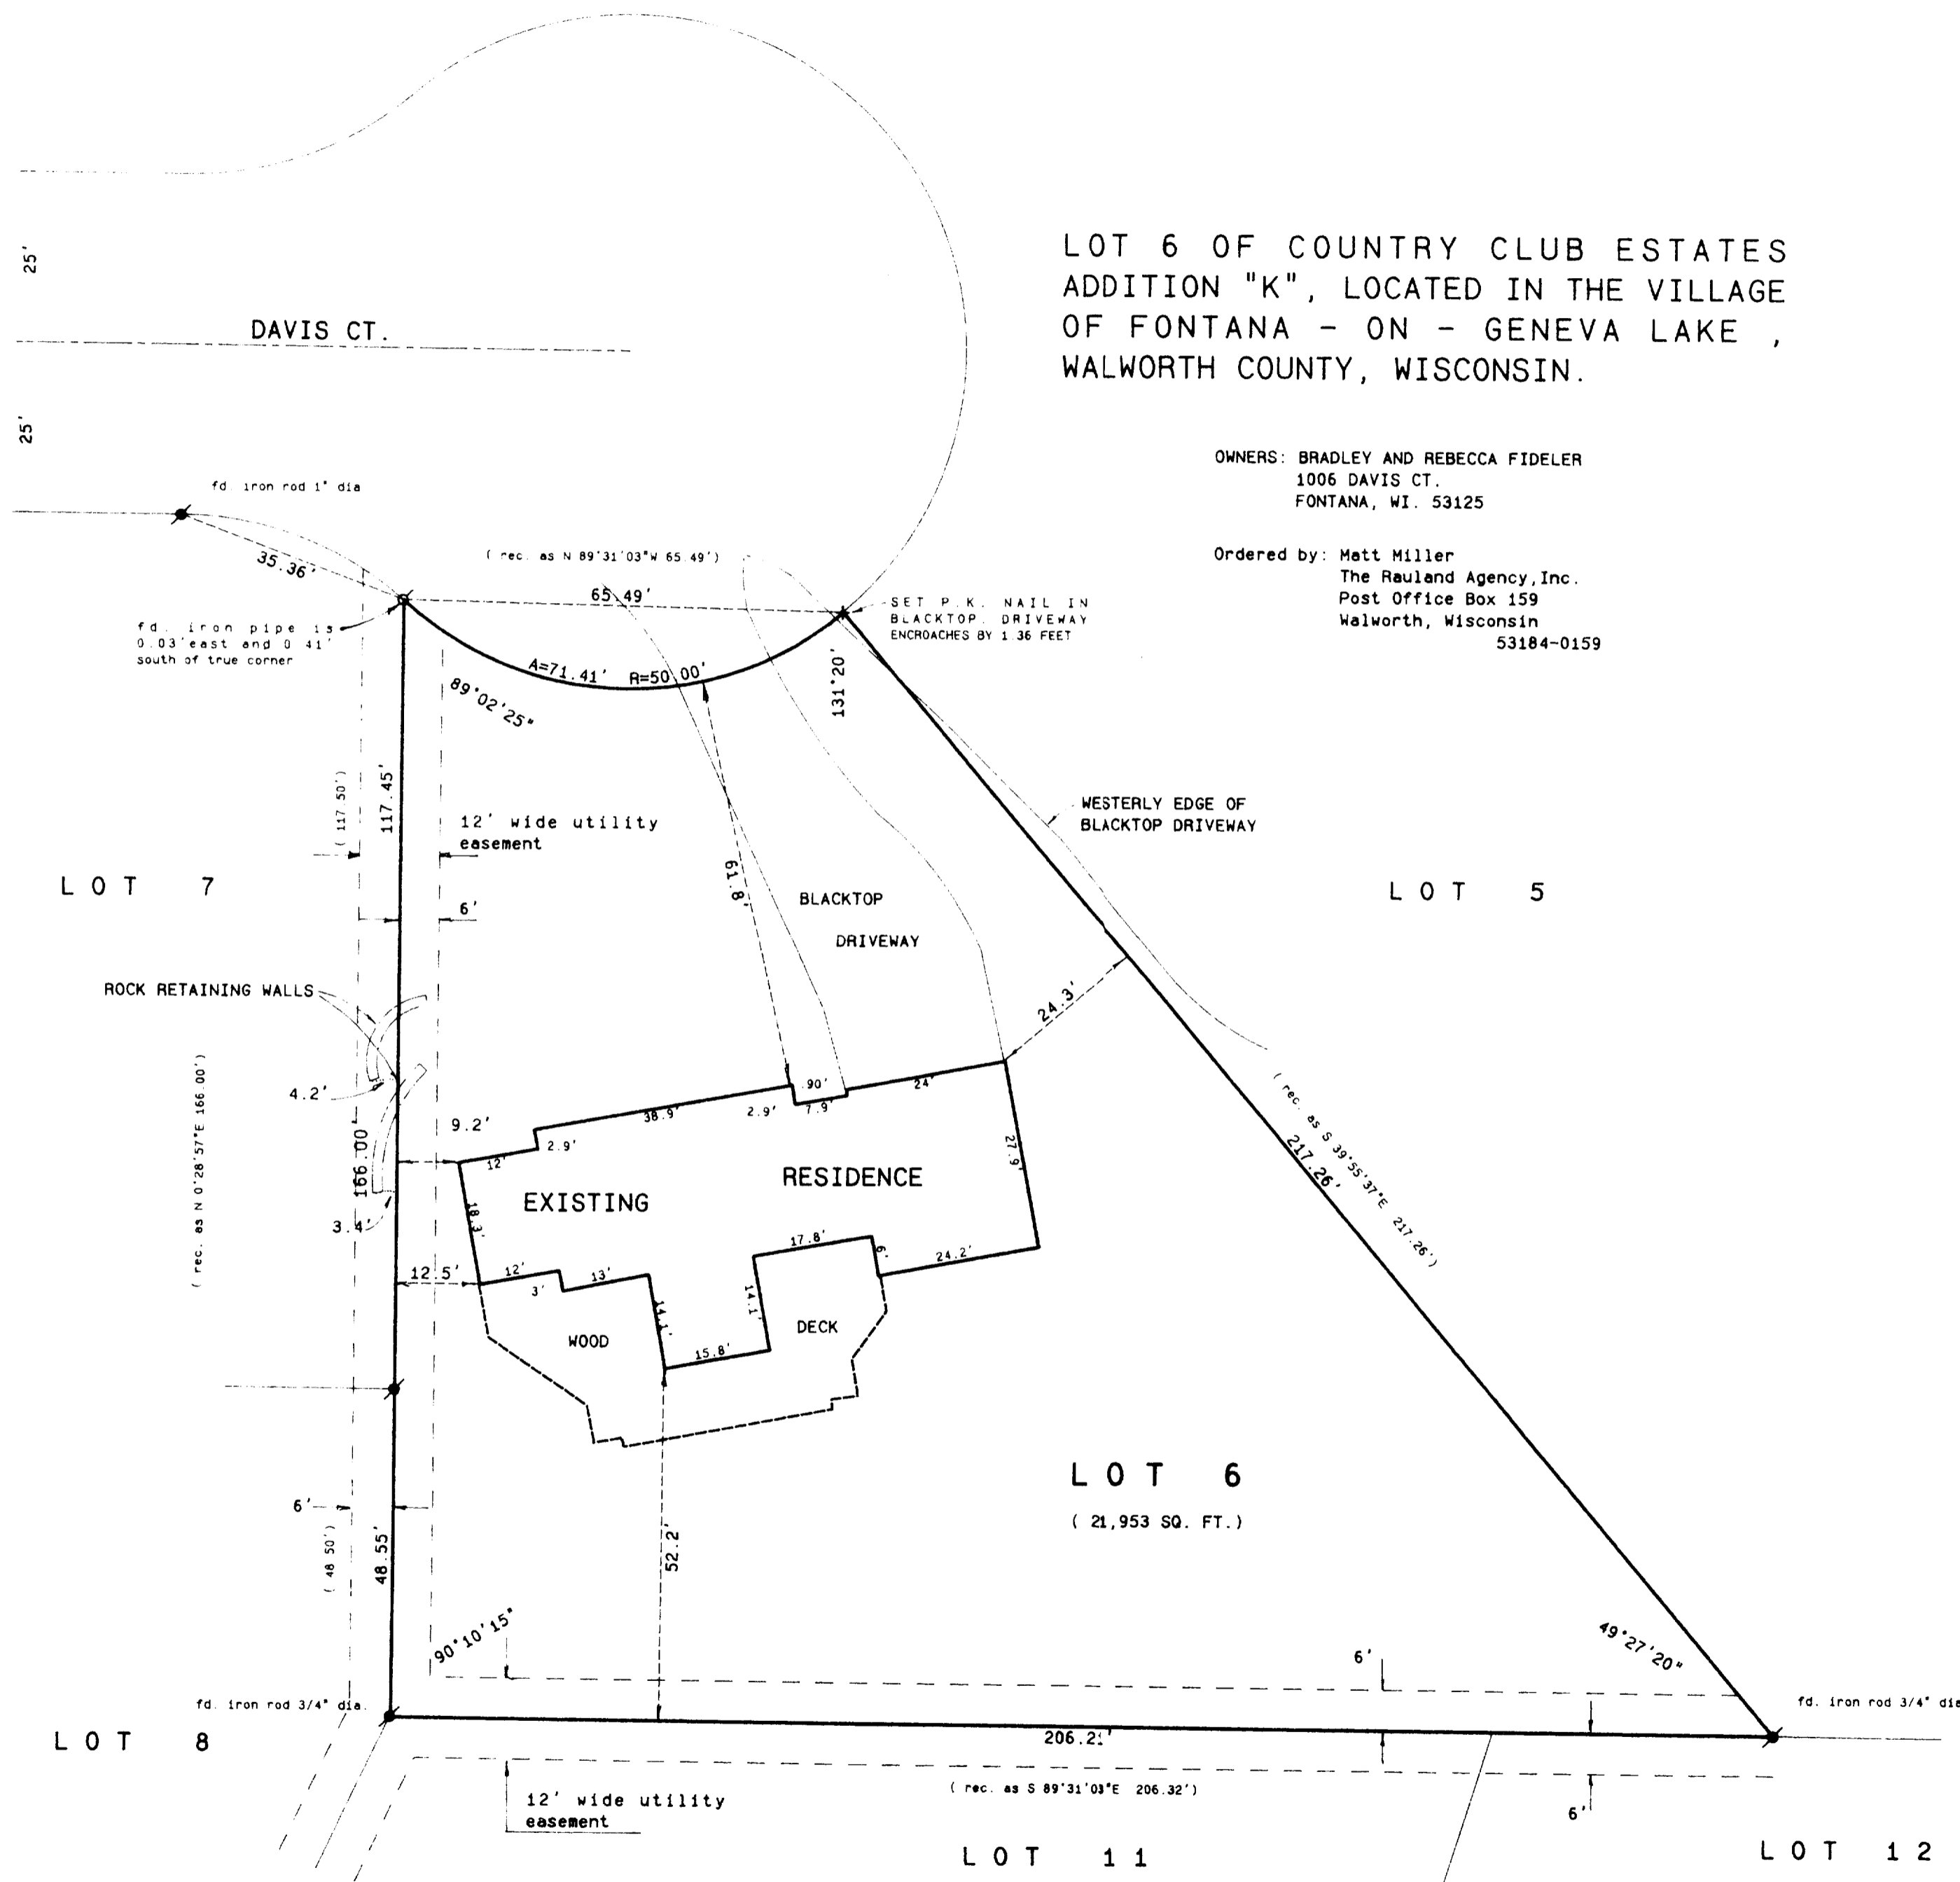

SCALE 1" = 20 FEET

Legend

- FOUND IRON PIPE
- FOUND IRON ROD
- FOUND BRASS CAPPED MONUMENT
- \* FOUND CONCRETE MONUMENT
- + CHISEL CUT IN CONCRETE
- SET IRON ROD, 24" LONG, WEIGHING 1.5 LBS. LINEAL FT., 3/4" DIA.
- SET IRON ROD, 30" LONG, WEIGHING 4.5 LBS. LINEAL FT., 1 1/16" DIA.
- (rec.) RECORDED AS DIMENSION
- - - - - EXISTING FENCE

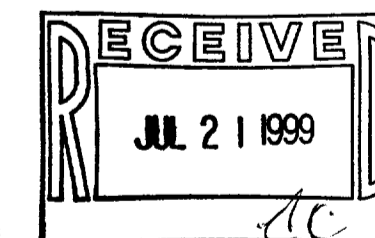

SCALE: 1" = 20 FEET



I hereby certify that the above described property has been surveyed by me or under my direction and that the above map is a true representation thereof and shows the size and location of the property, its exterior boundaries, the location of all visible structures and dimensions of all principal buildings thereon, boundary fences, apparent easements, roadways and visible encroachments, if any.

This survey is made for the use of the present owners of the property, and also those who purchase, mortgage, or guarantee the title thereto within one year from date hereof.

KENNETH B. ABERNATHY, JR.  
WISCONSIN REGISTERED LAND SURVEYOR,  
S-1594

Date: June 18, 1999 Job No. 99518

SKK-6 005-1725