

HOGANSON & ROBERS, INC.

CONSULTING ENGINEERS & LAND SURVEYORS

PHONE (414) 763-2652


116 E. CHESTNUT ST.

BURLINGTON, WIS. 53105

Plat of Survey
of
Lot F-32 Add. F
Country Club Estates
Village of Fontana-on-Geneva Lake
Walworth County, Wisconsin



SCALE 1" = 30'

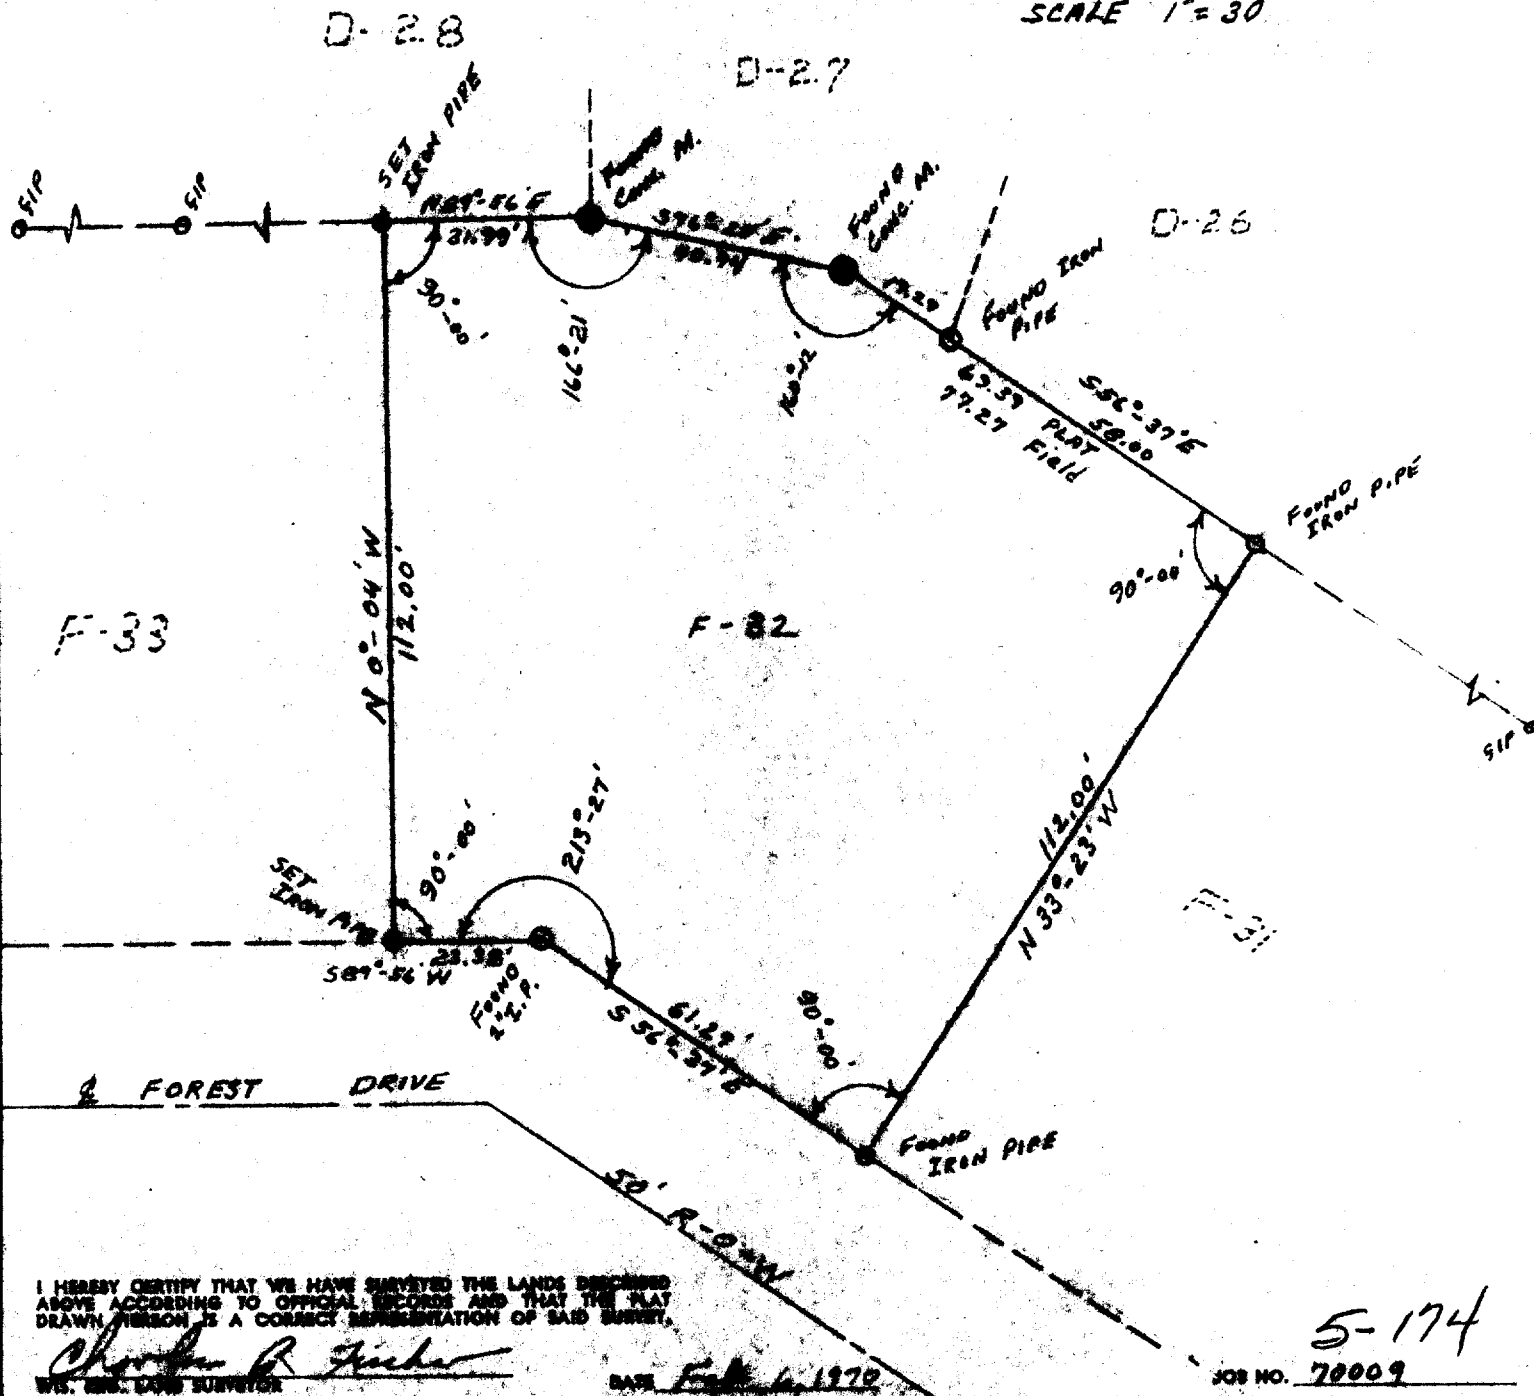

I HEREBY CERTIFY THAT WE HAVE SURVEYED THE LANDS DESCRIBED ABOVE ACCORDING TO OFFICIAL RECORDS AND THAT THE PLAT DRAWN HEREON IS A CORRECT REPRESENTATION OF SAID SURVEY.

Charles R. Fischer
WIS. ENG. LAND SURVEYOR

DATE *Feb 14 1970*

5-174

JOB NO. 70009

507 E-37