

GENEVA LAKE

ABELL SURVEYING & MAPPING

1140 SEQUOIA STREET • DELAVAN, WISCONSIN 53115
262-728-6737

PLAT OF SURVEY OF

LOT 2 OF CERTIFIED SURVEY MAP NO. 655 AS
RECORDED IN VOLUME 3 OF CERTIFIED SURVEY
MAPS ON PAGE 140 AS DOCUMENT NUMBER 15118,
LOCATED IN THE VILLAGE OF FONTANA-ON-GENEVA
LAKE, WALWORTH COUNTY, WISCONSIN.

CERTIFIED SURVEY MAP
NO. 655

LOT 1


N



SCALE 1"=50'


LEGEND

- - IRON PIPE FOUND
- - IRON ROD FOUND
- ⊙ - PK NAIL SET IN BLACKTOP DRIVE
- XX - CHAINLINK FENCE
- X— - WIRE FENCE
- MH ⊙ - MANHOLE COVER
- () - RECORDED AS

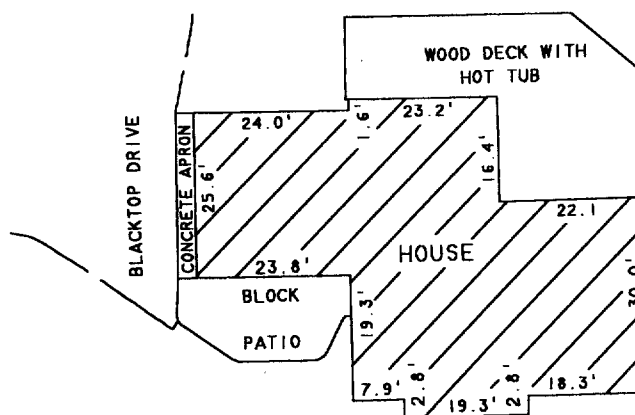

DETAIL SCALE 1"=30'

ORDERED BY: JOAN HUERTH
724 S. LAKE SHORE DRIVE
FONTANA, WI 53125

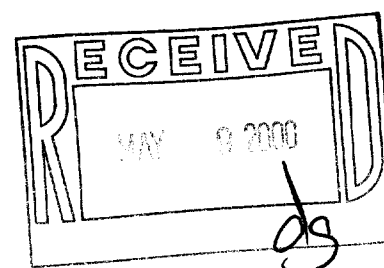

I HEREBY CERTIFY THAT I HAVE SURVEYED THE ABOVE DESCRIBED PROPERTY AND THAT THE ABOVE MAP IS A TRUE REPRESENTATION THEREOF AND SHOWS THE SIZE AND LOCATION OF THE PROPERTY, ITS EXTERIOR BOUNDARIES, THE LOCATION OF ALL VISIBLE STRUCTURES AND DIMENSIONS OF ALL PRINCIPAL BUILDINGS THEREON, BOUNDARY FENCES, APPARENT EASEMENTS, ROADWAYS AND VISIBLE ENCROACHMENTS, IF ANY, TO THE BEST OF MY KNOWLEDGE AND BELIEF.

THIS SURVEY IS MADE FOR THE USE OF THE PRESENT OWNERS OF THE PROPERTY, AND ALSO THOSE WHO PURCHASE, MORTGAGE, OR GUARANTEE THE TITLE THERETO WITHIN ONE (1) YEAR FROM DATE HEREON.

David F. Abell

DAVID F. ABELL
WISCONSIN REGISTERED LAND SURVEYOR, S-1596

March 2, 2000

DATE: _____ JOB NUMBER - 87029A
NOTE: THIS IS NOT A CERTIFIED COPY UNLESS SEALED.

SOUTH SHORE DR.

005-1795

SA-655-2