PLAT OF SURVEY


PATHFINDER SURVEYING FORMERLY KOLB LAND CONSULTING
929 WILLIAMS STREET LAKE GENEVA, WI. 53147
(262) 248-3697

URDERED BY

ALLEN, HARRISON, WILLIAMS, MCDONELL & SWATEK, LLP **527 CENTER STREET**

LAKE GENEVA, WI 53147

DESCRIPTION: A PARCEL OF LAND LOCATED IN THE NORTHWEST 1/4 OF SECTION 13, T.1.N., R.16.E., FUNTANA-ON-GENEVA LAKE, WALWORTH COUNTY, WISCONSIN, DESCRIBED AS FOLLOWS: COMMENCING AT THE MIDDLE 1/4 SECTION CORNER OF SAID SECTION 13; THENCE N 57°05' W 438.66 FEET; THENCE N 11°50' W 69.97 FEET; THENCE S 86°05' W 97.50 FEET TO THE POINT OF BEGINNING; THENCE N00°54′05' W 49.35 FEET; THENCE S 89°14′00' W 80.08 FEET; THENCE S 00°34′16" E 130.40 FEET; THENCE S 89°13′57' E 78.00 FEET; THENCE N01°07′36' E 87.26 FEET TO THE POINT OF BEGINNING.

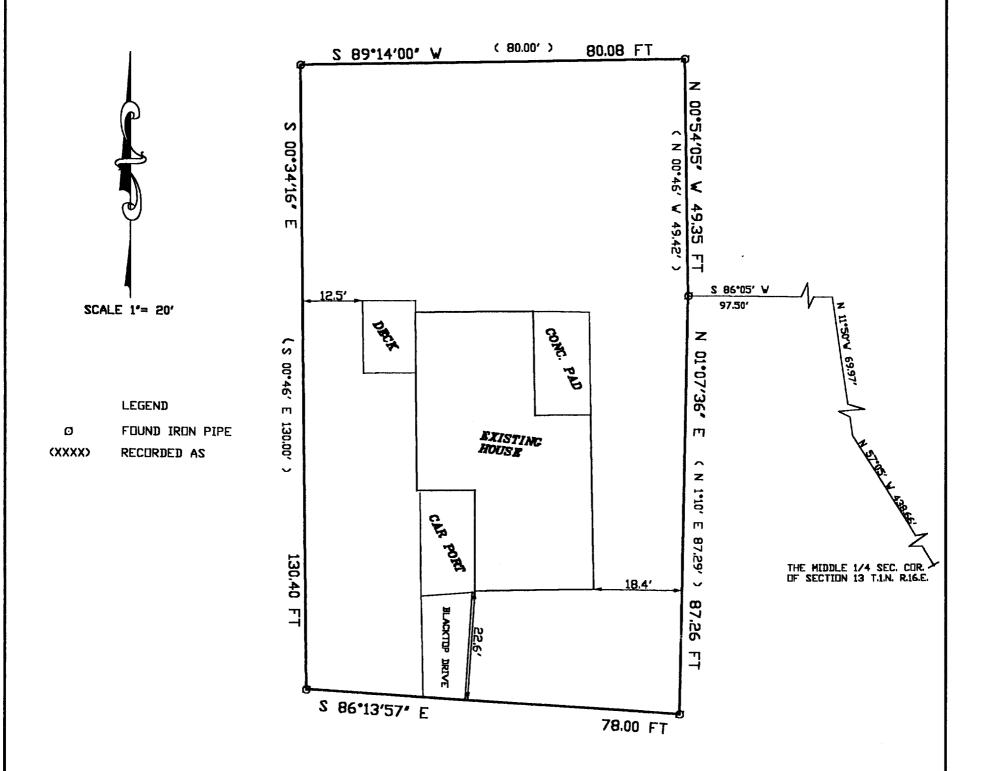

THE ABOVE MAP IS A TRUE REPRESENTATION THEREOF AND SHOWS THE SIZE AND LOCATION OF ALL THE PROPERTY, EXTERIOR BOUNDARIES, THE LOCATION OF ALL VISIBLE BOUNDARY FENCES, APPARENT EASEMENTS, ROADWAYS AND VISIBLE ENCROACHMENTS, IF ANY

THIS SURVEY IS MADE FOR THE USE OF THE PRESENT DWNERS OF THE PROPERTY, AND ALSO THOSE WHO PURCHASE, MORTGAGE OR GURANTEE TITLE THERETO WITHIN DNE (1) YEAR FROM DATE HERETO.



JOHN P. KROTT , R.L.S. 2258

NOTE: THIS IS NOT A CERTIFIED COPY JUB NUMBER: 00105-STFV 00100

DATE: 5 / 30 / 2000

005-1849