
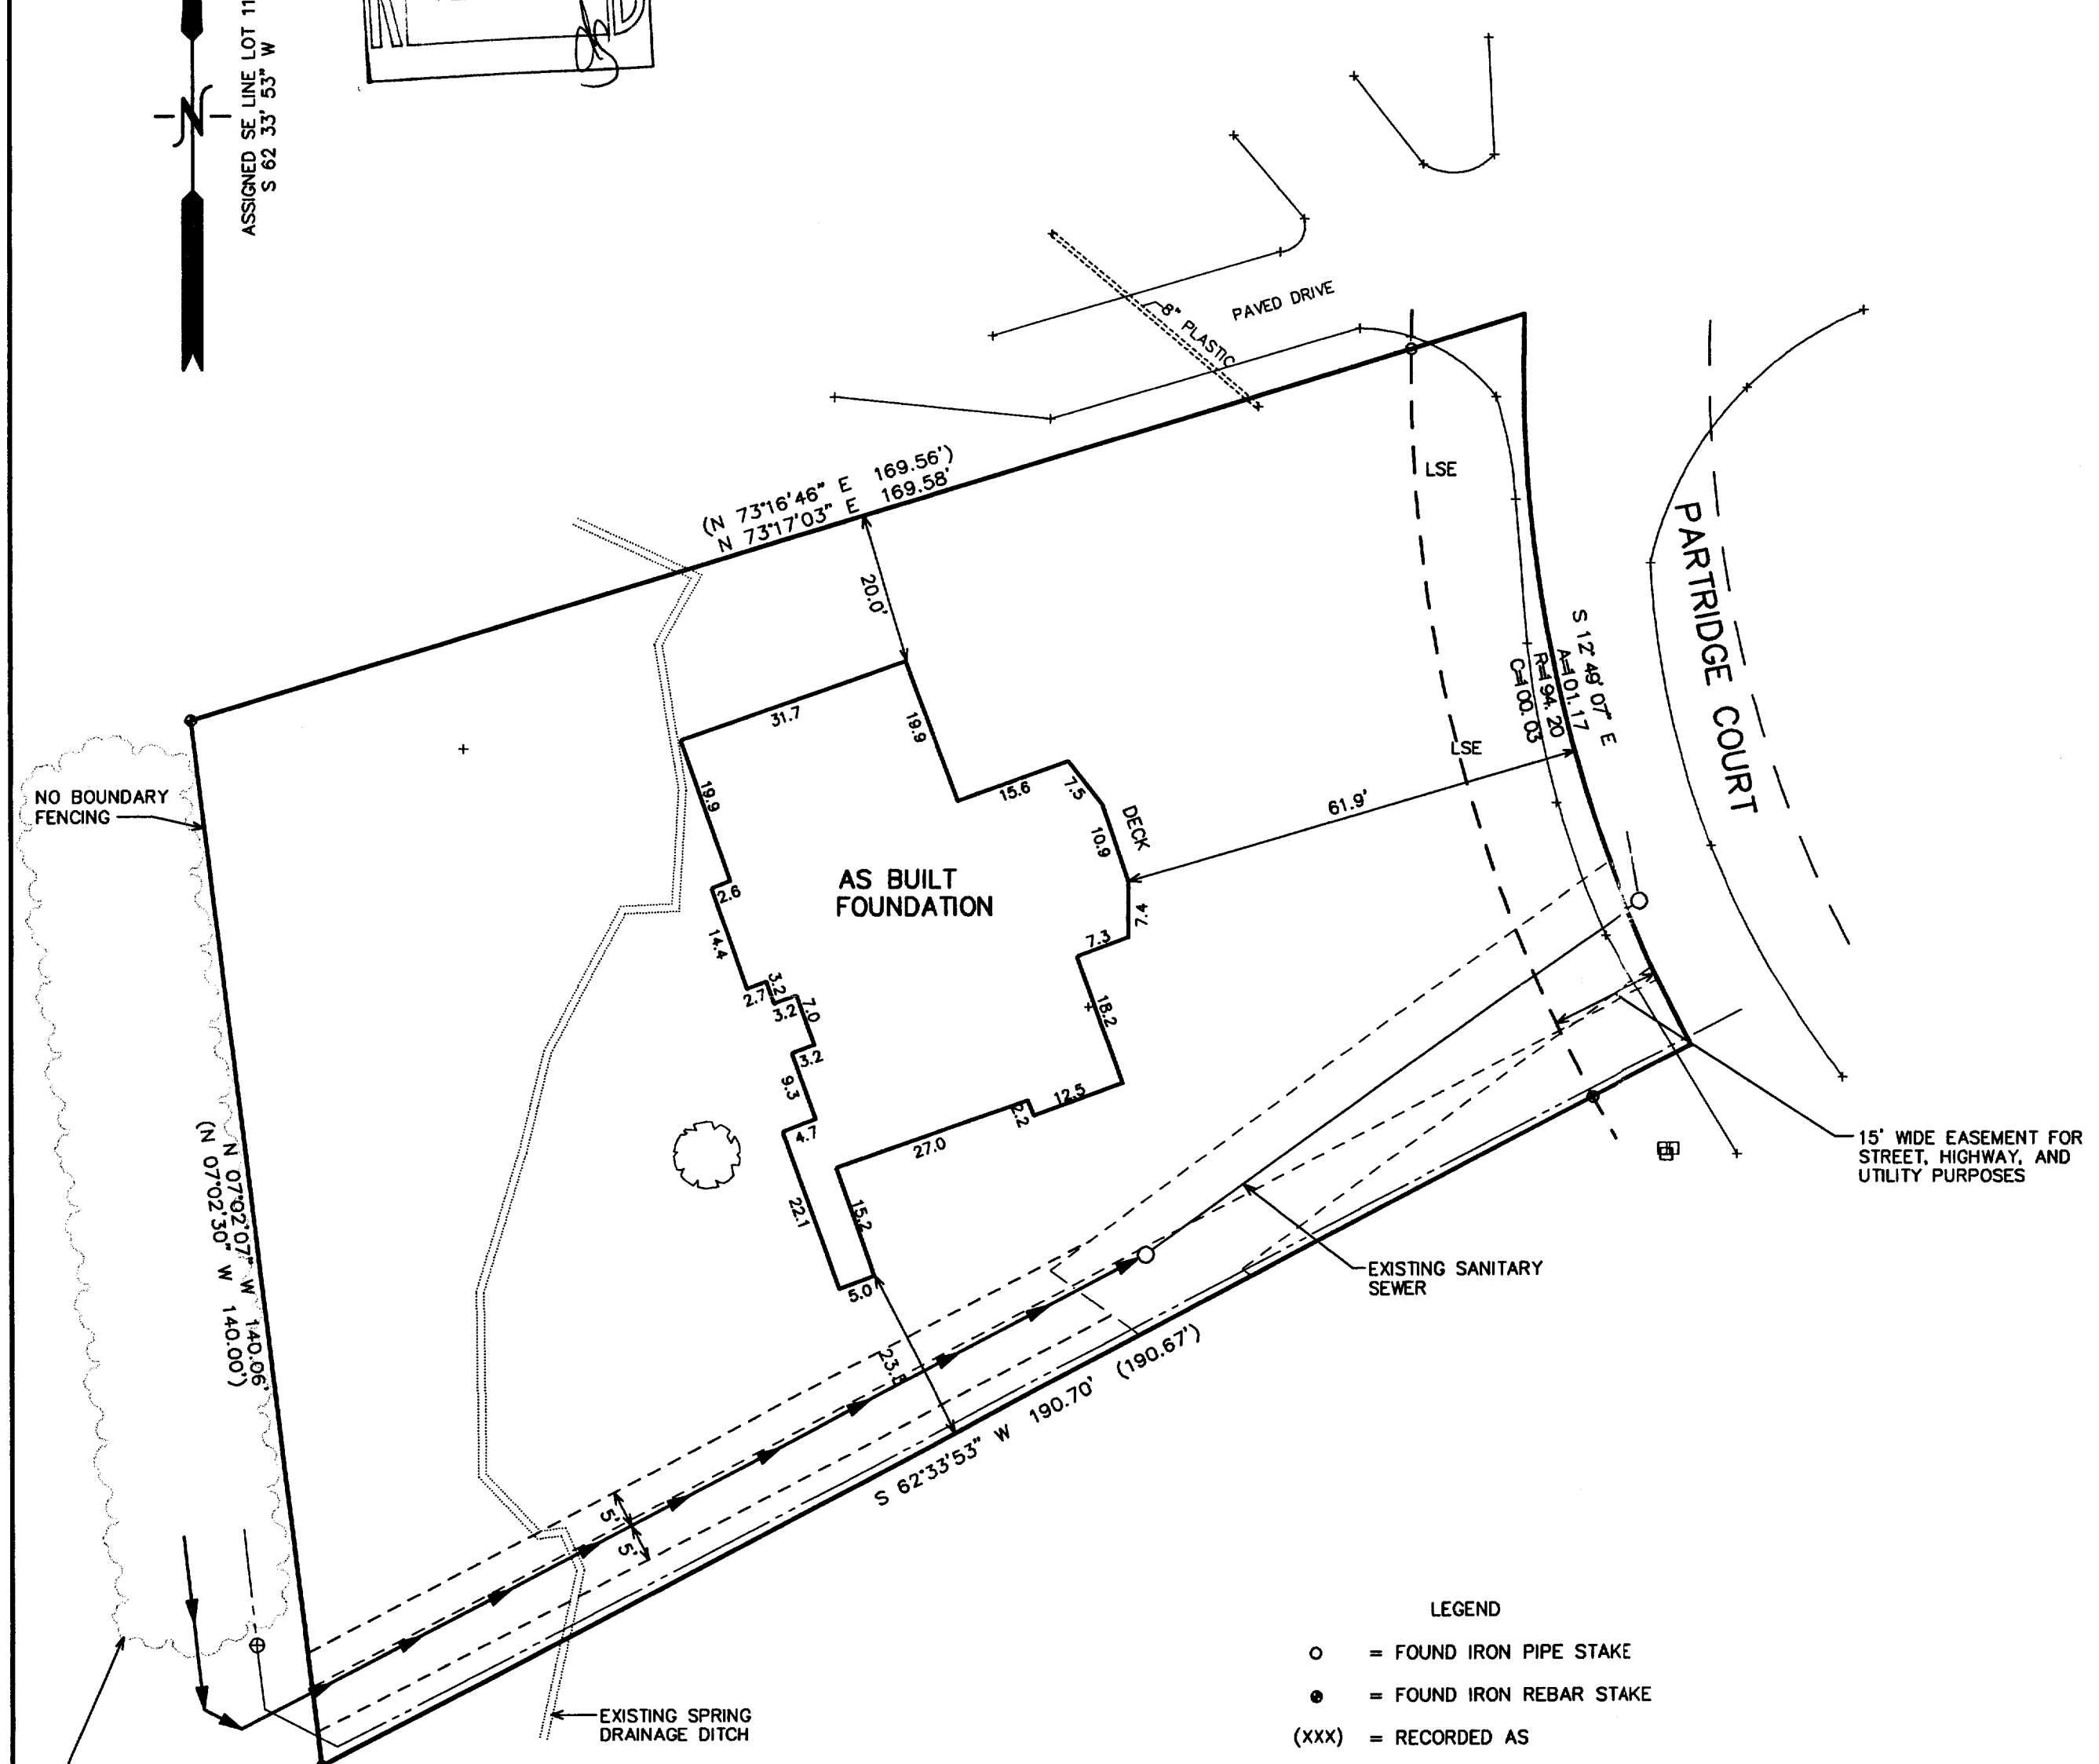
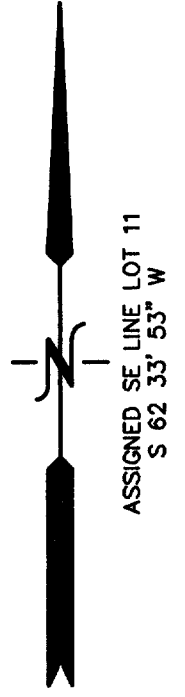


SITE, GRADING, DRAINAGE, & EROSION CONTROL PLAN

LOT 11 OF COUNTRY CLUB ESTATES UNIT 1
 LOCATED IN THE VILLAGE OF FONTANA-ON-GENEVA LAKE,
 WALWORTH COUNTY, WISCONSIN

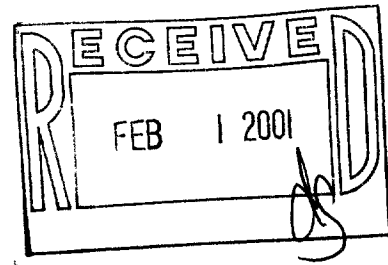

25' LANDSCAPE BUFFER YARD
 (MINIMUM CLUSTERED PINES
 SUITABLE FOR WETLAND SOILS,
 3 VARIABLE ROWS)
 (3'-4' HEIGHT)

- LEGEND**
- = FOUND IRON PIPE STAKE
 - = FOUND IRON REBAR STAKE
 - (XXX) = RECORDED AS
 - XXX--- = EXISTING CONTOURS
 - XXX— = PROPOSED CONTOURS
 - S-S- = PROPOSED SILT FENCE
 - = PROPOSED PAVEMENT ELEVATION
 - TOF=XXX.X = PROPOSED TOP OF FOUNDATION ELEVATION
 - FF=XXX.X = PROPOSED FIRST FLOOR ELEVATION
 - WO=XXX.X = PROPOSED WALK-OUT (BASEMENT) ELEVATION
 - GE=XXX.X = PROPOSED GARAGE ENTRY ELEVATION
 - LSE = LANDSCAPED ENTRANCE W/BOULDER ACCENTS OR STONE TO MATCH RESIDENCE
 - = PROPOSED STONE ENTRY PIER



NOTE: COPIES OF THIS MAP TO WHICH THE FOLLOWING CERTIFICATE WILL APPLY SHOW THE SURVEYOR'S ORIGINAL SEAL AND SIGNATURE IN RED INK. COPIES BY ANY OTHER MEANS MAY HAVE ALTERATIONS WHICH DO NOT REPRESENT THE SURVEYOR'S WORK PRODUCT.

I HEREBY CERTIFY THAT THE ABOVE DESCRIBED PROPERTY HAS BEEN SURVEYED UNDER MY DIRECTION AND THAT THE ABOVE MAP IS A TRUE REPRESENTATION THEREOF AND SHOWS THE SIZE AND LOCATION OF THE PROPERTY AND ITS EXTERIOR BOUNDARIES. THIS SURVEY IS MADE FOR THE USE OF THE PRESENT OWNERS OF THE PROPERTY, AND ALSO THOSE WHO PURCHASE, MORTGAGE, OR GUARANTEE THE TITLE THERETO WITHIN ONE YEAR FROM THE DATE HEREOF.

DATED: 03-23-2000

Peter S. Gordon
 PETER S. GORDON R.L.S. 2101

REVISED 11-20-2000
 ADD AS BUILT FOUNDATION

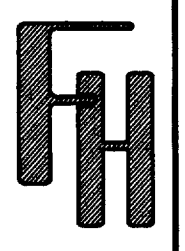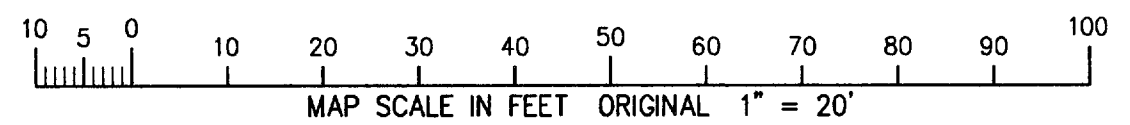

**SITE, GRADING, DRAINAGE,
 & EROSION CONTROL PLAN**
 VILLAGE OF FONTANA-ON-GENEVA LAKE
 WALWORTH COUNTY, WISCONSIN

WORK ORDERED BY -
 HOME DESIGN MAN. CORP.
 N.2002 HIGHWAY 67
 FONTANA, WI. 53125

FARRIS, HANSEN & ASSOCIATES, INC.
 ENGINEERING - ARCHITECTURE - SURVEYING
 7 RIDGWAY COURT P.O. BOX 437
 ELKHORN, WISCONSIN 53121
 OFFICE: (262) 723-2098 FAX: (262) 723-5886

REVISIONS
8/1/2000 GENERAL REVISIONS
8/28/2000 GENERAL REVISIONS

PROJECT NO. 5533
DATE: 04/07/2000
SHEET NO. 1 OF 1

NOV 20 2000

Scot-12

085-1867