ABERNATHY and ASSOCIATES

Kenneth B. Abernathy Jr.

Wisconsin Registered Land Surveyor 5-1594


Rt. 3, Box 273 Elkhorn, Wisconsin 53121 Phone: (414) 723-4260 (office) (414) 723-7209 (FAX)

PLAT OF SURVEY

Parcel "I"

The Northerly 1/2 of Lot 20 and the Northerly 1/2 of Lot 21 of Glenwood Terrace Subdivision, as recorded in Volume 10, Page 11 of Plats, Dated July 2, 1928, being located in the North 1/2 of the Northeast 1/4 of the Northeast 1/4 of Section 23, Town 1 North, Range 16 East, Village of Fontana, County of Walworth, State of Wisconsin, more particularly described as follows;

Commencing at a Found Concrete Monument at the Northeast Corner of said Section 23, thence S 87°28'00" W along the North Line of said Section 33.00 feet to a Found Concrete Monument on the West Right-of-way Line of Indian Hills Road; thence S 2'21'56" E (recorded as S 2°29' E 232.30 feet) along said right-of-way line 232.36 feet to an Iron Pipe on the South Right-of-way Line of Berwyn Drive; thence S 87°28'27" W along said South Right-of-way Line 1051.83 feet (recorded as 1052.90 feet) to an Iron Pipe at the Northeast Corner of said Lot 21; thence continue S 87°28'27" W along the said right-of-way line 143.98 feet (recorded as 144.00 feet) to an Iron Pipe at the Northwest Corner of said Lot 20; thence S 2°37′45" E along the West Line of Lot 20 95.94 feet to an Iron Pipe; thence N 87°28'16" E 143.95 feet (recorded as 144.00 feet) to an Iron Pipe on the East Line of said Lot 21; thence N 2°36'55" E 95.93 feet (recorded as 96.00 feet) to the Northeast Corner of Lot 21 and the point of beginning. Said parcel contains 0.317 Acres of land

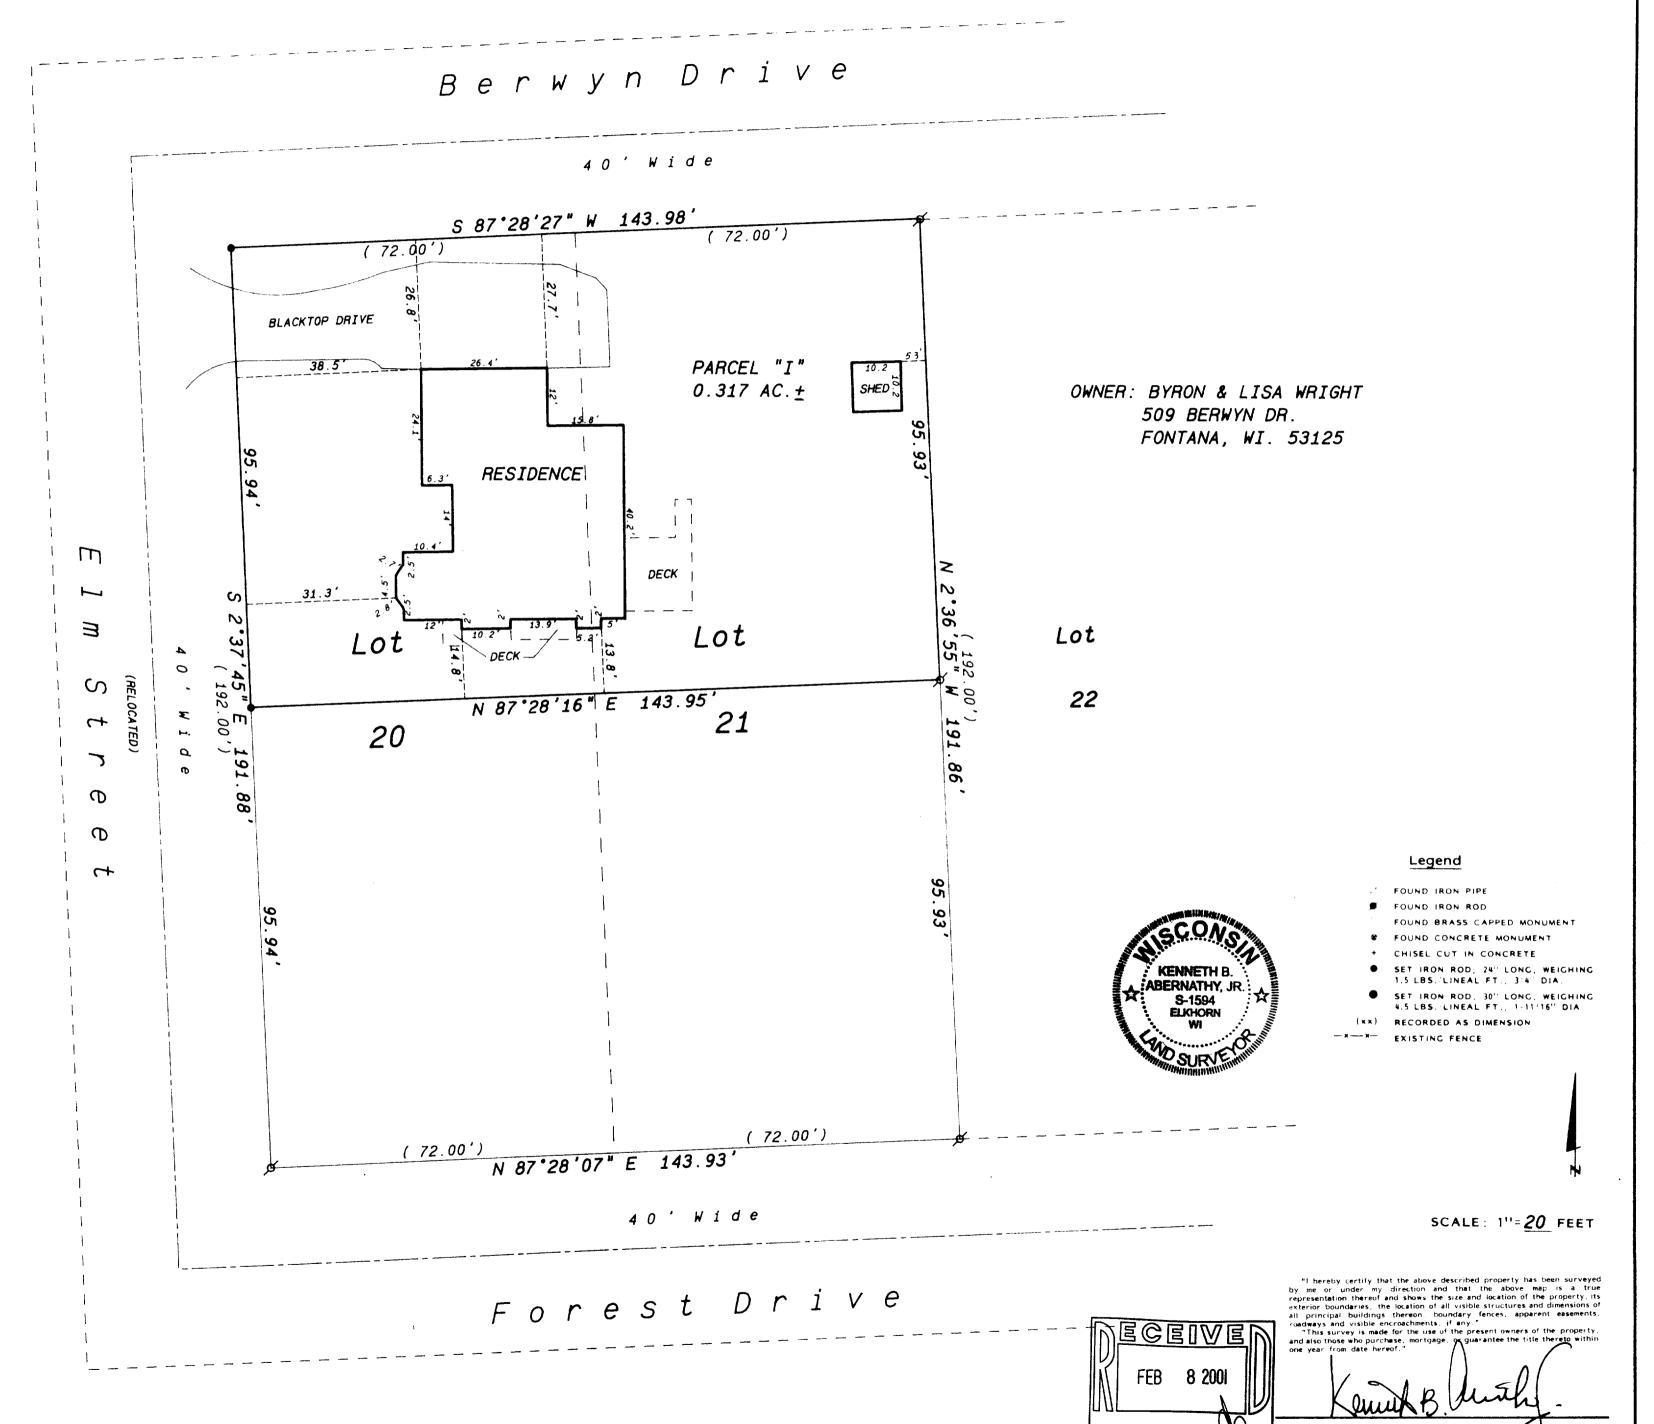

SGT-6A 005-1871

AS BUILT LOCATED AND REVISED 9/29/94
REVISED 9/6/2000

Date: <u>May 26, 1994</u>

____ Job No. <u>1994, 516</u>