


WALWORTH COUNTY SURVEYING & MAPPING


P. O. BOX 1115
LAKE GENEVA, WISCONSIN
414-248-0505

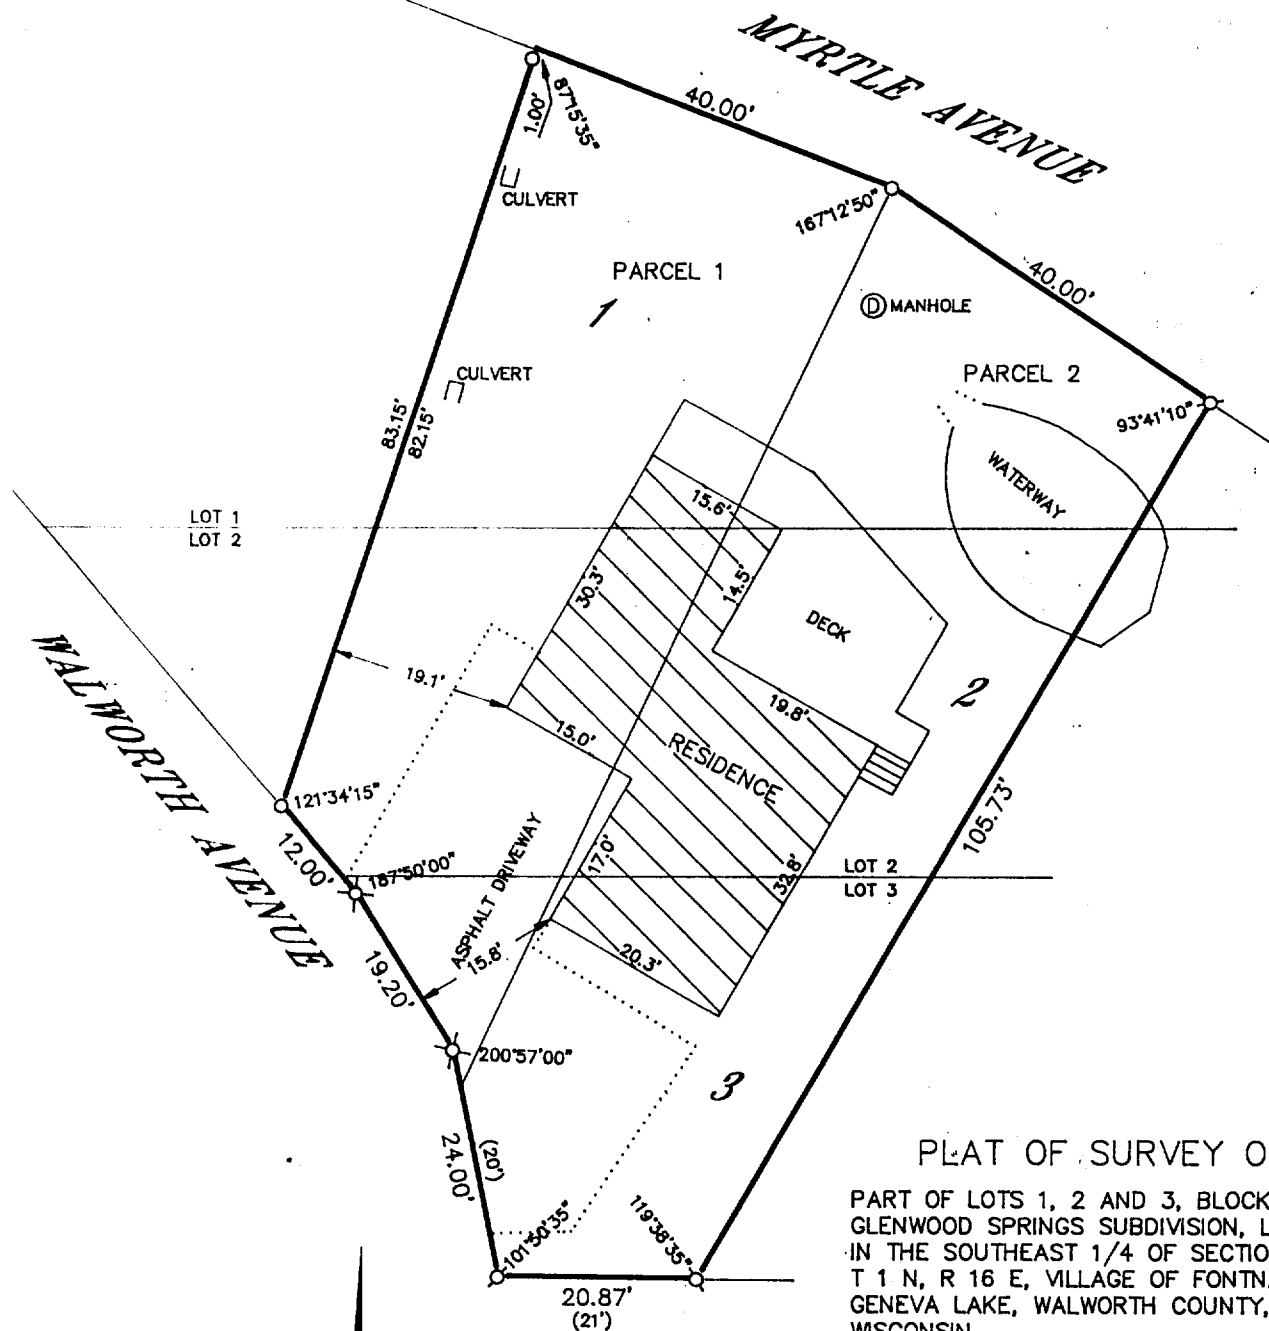

PLAT OF SURVEY OF

PART OF LOTS 1, 2 AND 3, BLOCK 10 OF
GLENWOOD SPRINGS SUBDIVISION, LOCATED
IN THE SOUTHEAST 1/4 OF SECTION 14,
T 1 N, R 16 E, VILLAGE OF FONTNA-ON-
GENEVA LAKE, WALWORTH COUNTY,
WISCONSIN.

ORDERED BY: COLDWELL BANKER
GENEVA LAKES AREA REALTORS
838 MAIN STREET
LAKE GENEVA, WISCONSIN
53147

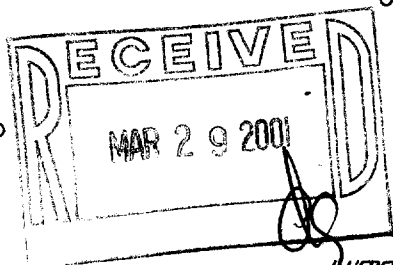


I HEREBY CERTIFY THAT I HAVE SURVEYED THE ABOVE DESCRIBED
PROPERTY AND THAT THE ABOVE MAP IS A TRUE REPRESENTATION
THEREOF AND SHOWS THE SIZE AND LOCATION OF THE PROPERTY,
ITS EXTERIOR BOUNDARIES, THE LOCATION OF ALL VISIBLE STRUCTURES
AND DIMENSIONS OF ALL PRINCIPAL BUILDINGS THEREON, BOUNDARY
FENCES, APPARENT EASEMENTS, ROADWAYS AND VISIBLE ENCROACH-
MENTS, IF ANY, TO THE BEST OF MY KNOWLEDGE AND BELIEF.

THIS SURVEY IS MADE FOR THE USE OF THE PRESENT OWNERS OF
THE PROPERTY AND ALSO THOSE WHO PURCHASE, MORTGAGE OR
GUARANTEE THE TITLE THERETO WITHIN ONE (1) YEAR FROM DATE
HEREOF.

ROBERT M. BAERENWALD
WISCONSIN REGISTERED LAND SURVEYOR, S-1508

DATE: AUG. 3, 1997 JOB NO. 5555

NOTE: THIS IS NOT A CERTIFIED COPY UNLESS SEALED.

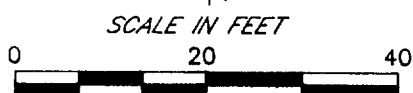

- LEGEND
- IRON PIPE FOUND
 - ⊙-IRON ROD FOUND
 - CONCRETE MONUMENT FOUND
 - IRON PIPE PLACED
 - RECORDED AS
 - ⊗-MAG NAIL SET

SCS-55

005-1901

**WALWORTH COUNTY
SURVEYING & MAPPING**


P. O. BOX 1115
LAKE GENEVA, WISCONSIN
414-248-0505

SHEET 2 OF 2 SHEETS

DESCRIPTION

PARCEL 1: PART OF LOTS 1, 2 AND 3 IN BLOCK 10, DESCRIBED AS FOLLOWS: COMMENCING ON THE EAST LINE OF WALWORTH AVENUE, 12 FEET NW OF THE SW CORNER OF LOT 2 AFORESAID; THENCE RUNNING SE'LY ALONG WALWORTH AVENUE TO A POINT 20 FEET NW'LY FROM THE SW CORNER OF LOT 3; THENCE NE'LY TO A POINT ON THE SOUTHERLY LINE OF MYRTLE AVENUE WHICH IS 63 FEET NW'LY FROM THE NE CORNER OF LOT 2; THENCE NW'LY ALONG MYRTLE AVENUE 40 FEET TO AN IRON PIN 89.5 FEET SE FROM THE NW CORNER OF SAID LOT 1; THENCE SOUTHERLY TO THE PLACE OF BEGINNING, IN GLENWOOD SPRINGS, BEING A SUBDIVISION ON THE SE 1/4 OF SECTION 14, T 1 N, R 16 E OF THE FOURTH PRINCIPAL MERIDIAN, ACCORDING TO THE PLAT THEREOF RECORDED NOVEMBER 16, 1892 IN VOLUME 5 OF PLATS, PAGES 25 AND 26 IN WALWORTH COUNTY, WISCONSIN.

PARCEL 2: PART OF LOTS 1, 2 AND 3 IN BLOCK 10, DESCRIBED AS FOLLOWS: COMMENCING ON THE EAST LINE OF WALWORTH AVENUE 20 FEET NORTH OF THE SW CORNER OF LOT 3; THENCE NE'LY TO A POINT ON THE SOUTHERLY LINE OF MYRTLE AVENUE, WHICH IS 63 FEET NW'LY FROM THE NE CORNER OF LOT 2; THENCE SE'LY ALONG THE SOUTH LINE OF MYRTLE AVENUE 40 FEET; THENCE SOUTHERLY TO A POINT 21 FEET EAST OF THE SW CORNER OF LOT 3; THENCE WESTERLY ALONG THE SOUTH LINE OF LOT 3 TO THE SW CORNER OF LOT 3; THENCE NORTHERLY ALONG THE NORTH LINE OF WALWORTH AVENUE TO THE PLACE OF BEGINNING, IN GLENWOOD SPRINGS, BEING A SUBDIVISION OF THE SE 1/4 OF SECTION 14, T 1 N, R 16 E OF THE FOURTH PRINCIPAL MERIDIAN, ACCORDING TO THE PLAT THEREOF RECORDED NOVEMBER 16, 1892 IN VOLUME 5 OF PLATS, PAGES 25 AND 26 IN WALWORTH COUNTY, WISCONSIN.

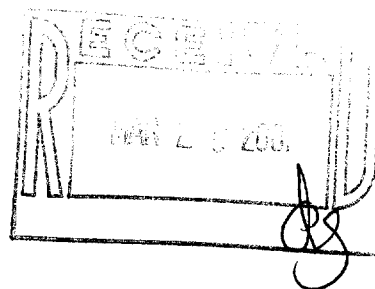

Robert M. Baerenwald
ROBERT M. BAERENWALD
WISCONSIN REGISTERED LAND SURVEYOR, S-1508

Aug. 3, 1997
DATE JOB NO. 5555P2

NOTE: THIS IS NOT A CERTIFIED COPY UNLESS SEALED.