
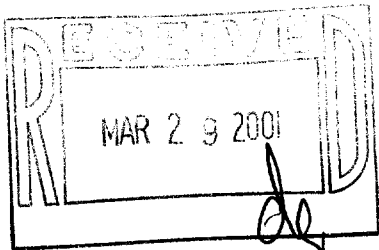


**WALWORTH COUNTY
SURVEYING & MAPPING**

P. O. BOX 1115
LAKE GENEVA, WISCONSIN
414-248-0505

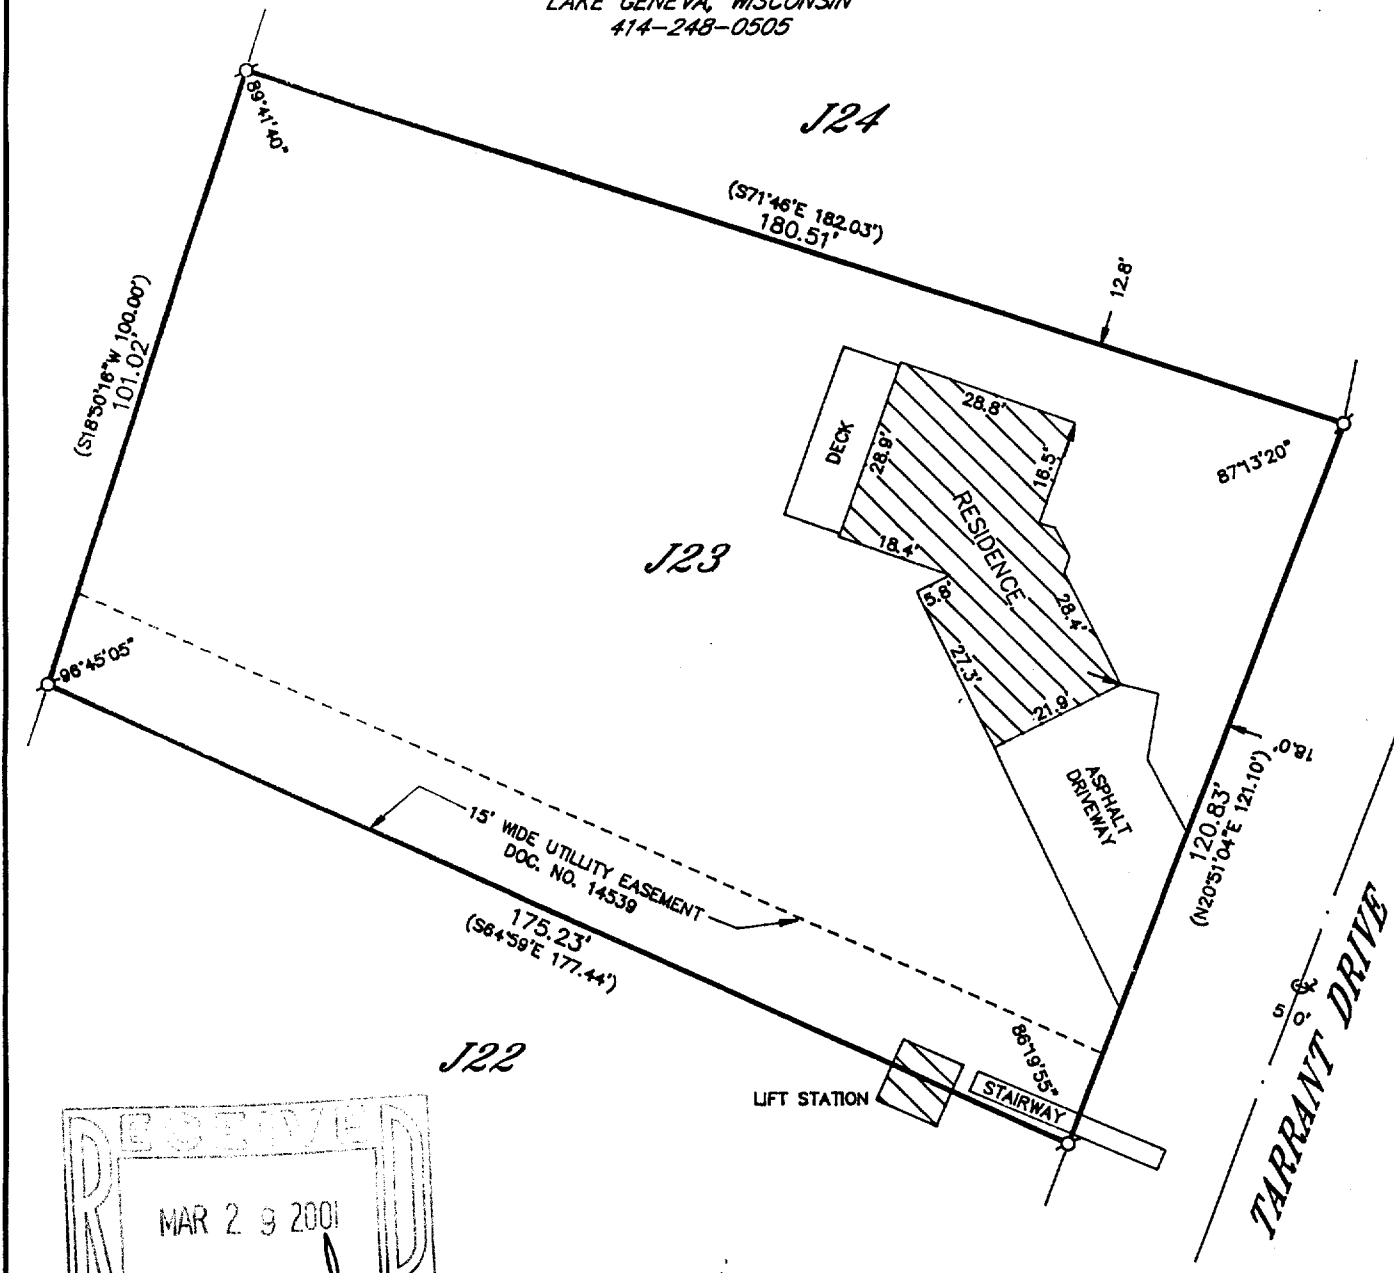

PLAT OF SURVEY OF

LOT J23, COUNTRY CLUB ESTATES, ADDITION "J", LOCATED IN OUTLOTS 101, 102 & 103 OF THE ASSESSOR'S PLAT OF THE VILLAGE OF FONTANA ON GENEVA LAKE IN THE SW 1/4 OF SECTION 14 AND THE NW 1/4 OF SECTION 23 AND THE NE 1/4 OF SECTION 22, T 1 N, R 16 E, VILLAGE OF FONTANA, WALWORTH COUNTY, WISCONSIN.

ORDERED BY: RICHARD W. TORHORST
P. O. BOX 1300
LAKE GENEVA, WISCONSIN
53147


I HEREBY CERTIFY THAT I HAVE SURVEYED THE ABOVE DESCRIBED PROPERTY AND THAT THE ABOVE MAP IS A TRUE REPRESENTATION THEREOF AND SHOWS THE SIZE AND LOCATION OF THE PROPERTY, ITS EXTERIOR BOUNDARIES, THE LOCATION OF ALL VISIBLE STRUCTURES AND DIMENSIONS OF ALL PRINCIPAL BUILDINGS THEREON, BOUNDARY FENCES, APPARENT EASEMENTS, ROADWAYS AND VISIBLE ENCROACHMENTS, IF ANY, TO THE BEST OF MY KNOWLEDGE AND BELIEF.

THIS SURVEY IS MADE FOR THE USE OF THE PRESENT OWNERS OF THE PROPERTY AND ALSO THOSE WHO PURCHASE, MORTGAGE OR GUARANTEE THE TITLE THERETO WITHIN ONE (1) YEAR FROM DATE HEREOF.

Robert M. Baerenwald
ROBERT M. BAERENWALD
WISCONSIN REGISTERED LAND SURVEYOR, S-1508

March 19, 1998
DATE: March 19, 1998 LOT NO. 5743

NOTE: THIS IS NOT A CERTIFIED COPY UNLESS SEALED.

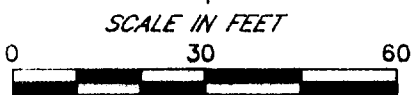

- LEGEND**
- IRON PIPE FOUND
 - ⊖—IRON ROD FOUND
 - CONCRETE MONUMENT FOUND
 - IRON PIPE PLACED
 - RECORDED AS

SCTJ-23
005-1949