



PLAT OF SURVEY

WORK ORDERED BY -  
MIKE FALLS  
PO BOX 587  
FONTANA, WI 53125




FARRIS, HANSEN & ASSOCIATES, INC.  
ENGINEERING - ARCHITECTURE - SURVEYING  
7 RIDGWAY COURT P.O. BOX 437  
ELKHORN, WISCONSIN 53121  
OFFICE: (262) 723-2098 FAX: (262) 723-5886

REVISIONS

PROJECT NO.  
1915.1501  
DATE  
11/02/2001  
SHEET NO.  
1 OF 1


PLAT OF SURVEY  
UNIT 1501 OF ABBEY SPRINGS  
CONDOMINIUM NO. 15

LOCATED IN PART OF THE SW 1/4 OF SECTION 13, TOWN 1 NORTH,  
RANGE 16 EAST, VILLAGE OF FONTANA-ON-GENEVA LAKE,  
WALWORTH COUNTY, WISCONSIN

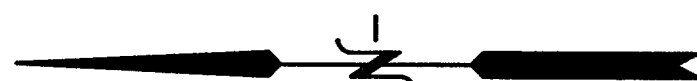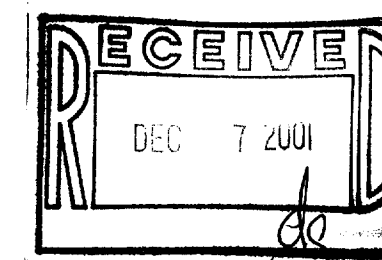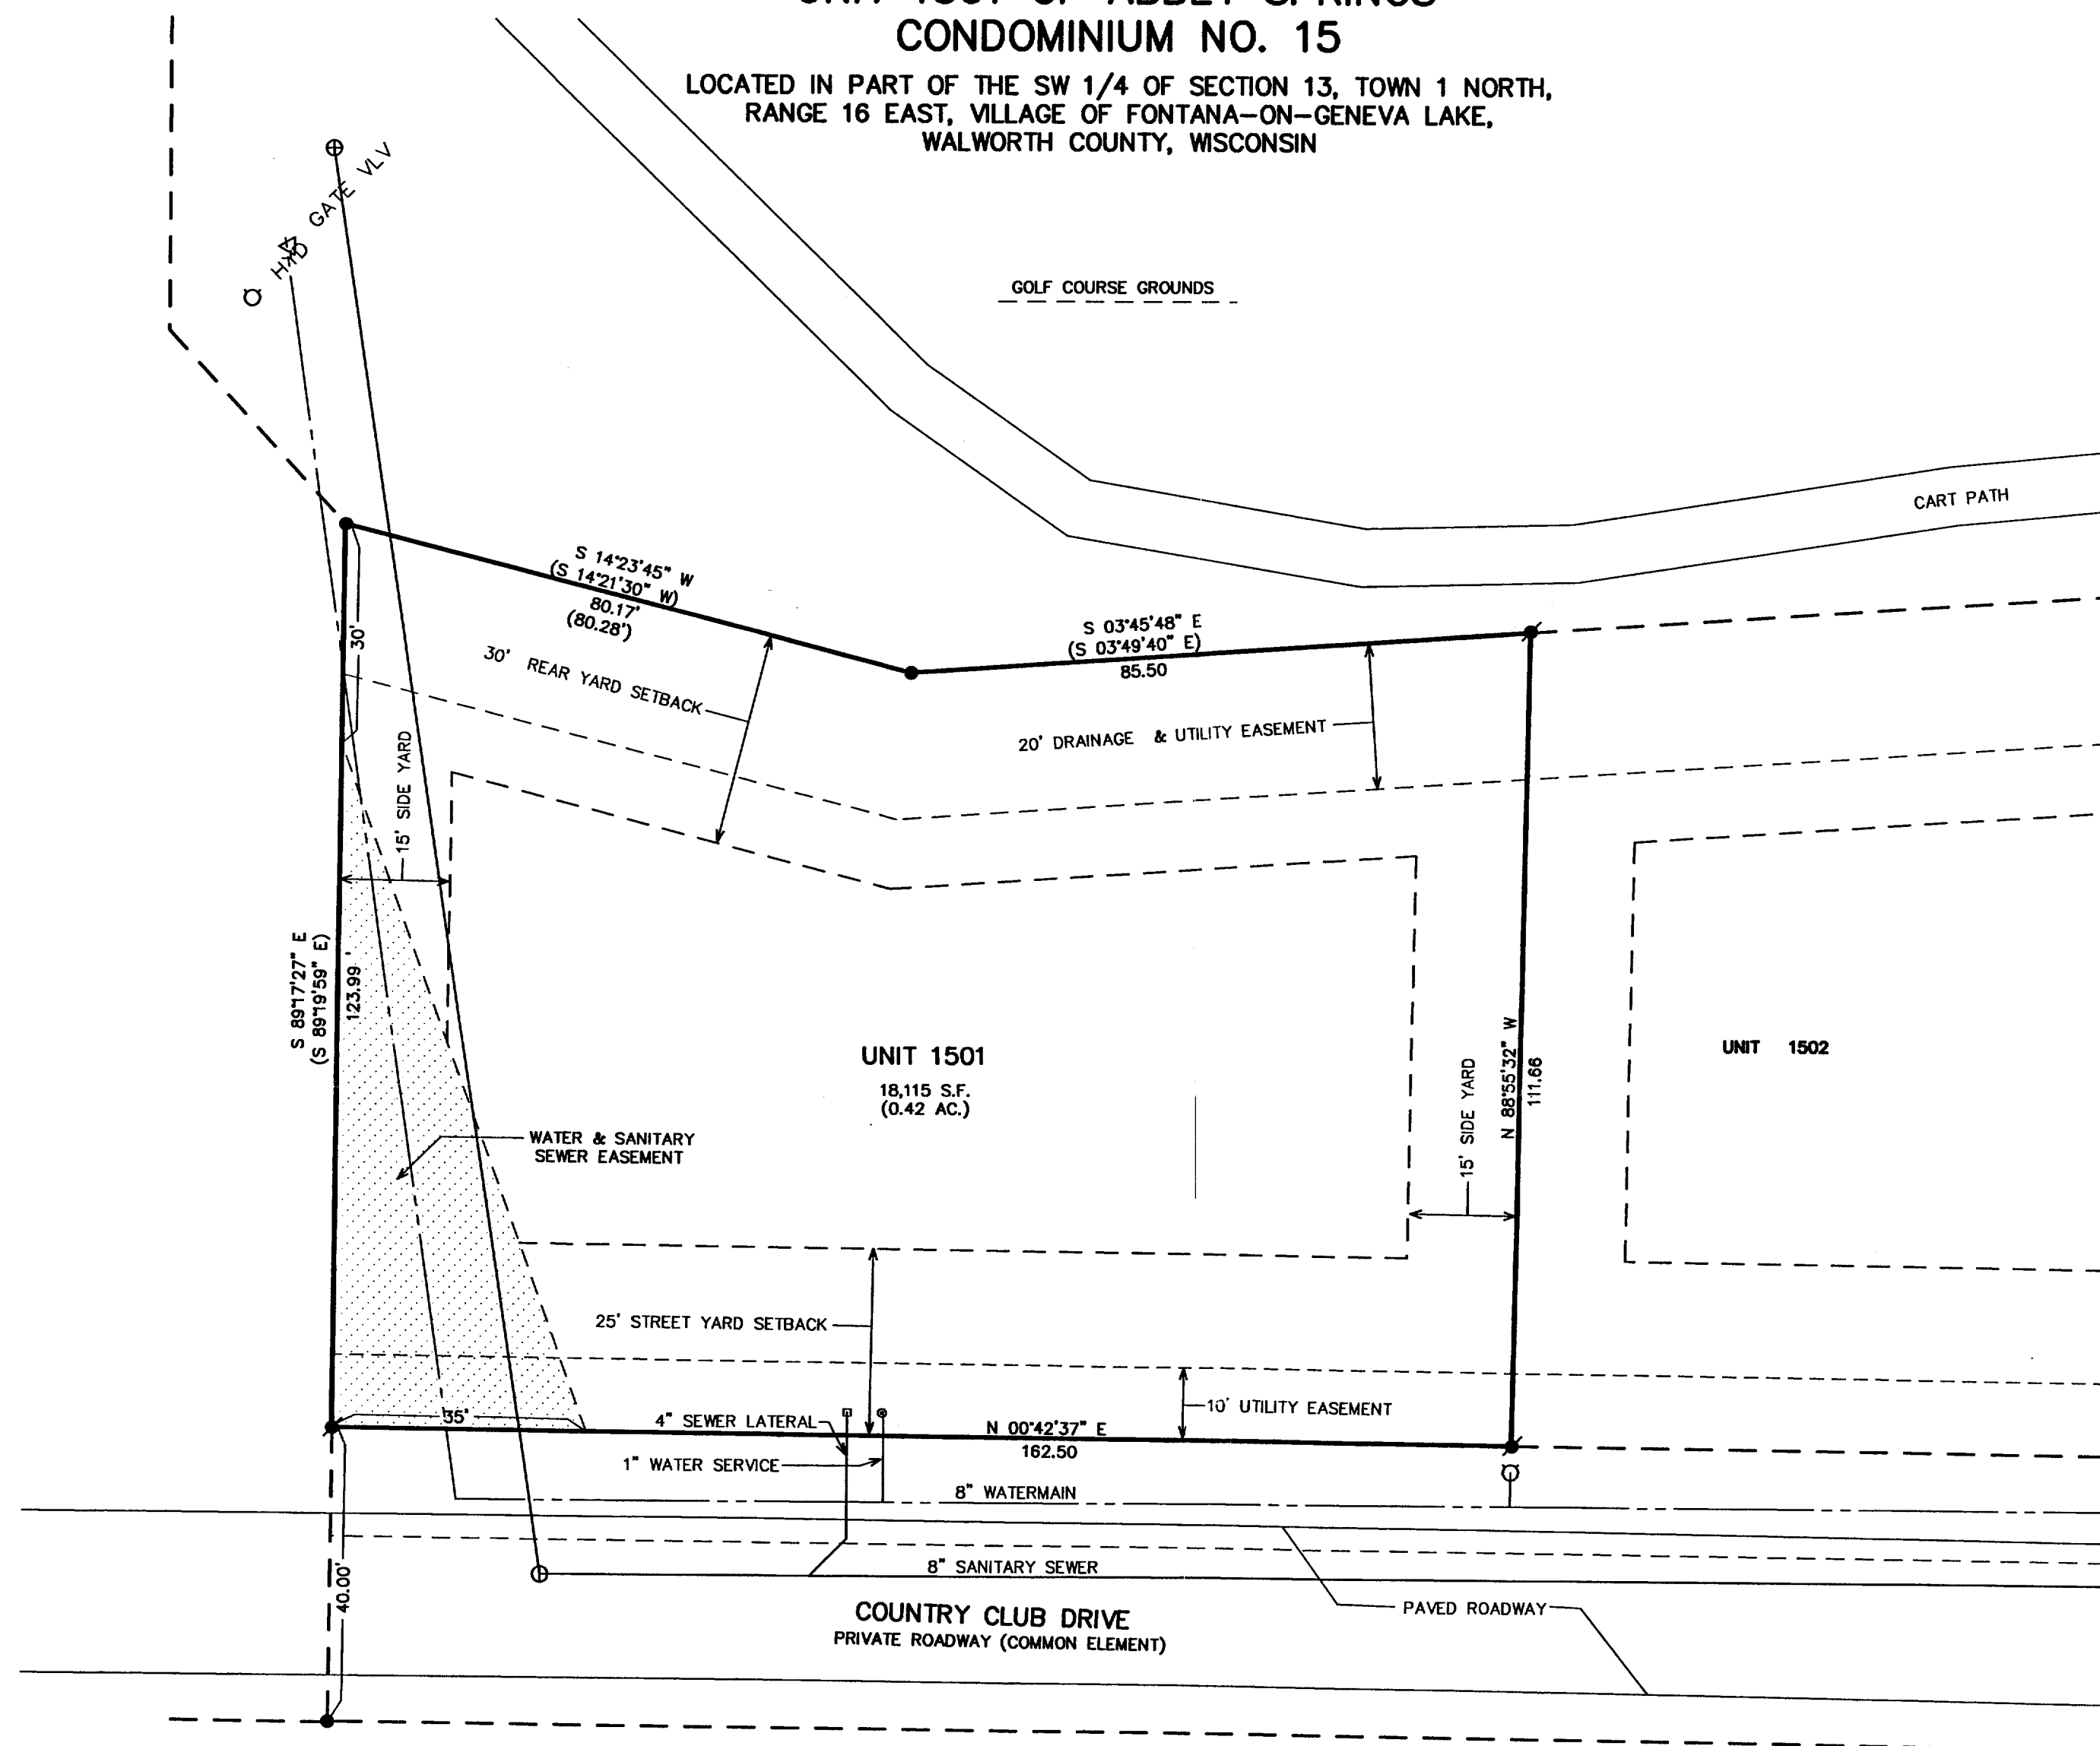

ASSIGNED NORTH LINE OF NW 1/4 OF SEC. 13-1-16  
N 88°33' W (PER CONDOMINIUM NO. 15 PLAT)

- LEGEND
- = FOUND IRON REBAR STAKE
  - ⚡ = SET IRON REBAR STAKE
  - = MANHOLE LOCATED
  - ⦿ = WATER SERVICE LOCATED
  - = SANITARY LATERAL BOARD LOCATED
  - {xxx} = RECORDED AS

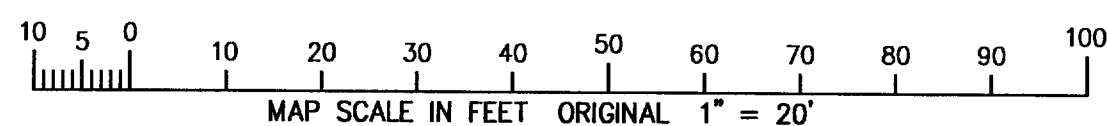

NOTE: COPIES OF THIS MAP TO WHICH THE FOLLOWING  
CERTIFICATE WILL APPLY SHOW SURVEYOR'S ORIGINAL SEAL AND  
SIGNATURE IN RED INK. COPIES BY ANY OTHER MEANS MAY HAVE  
ALTERATIONS WHICH DO NOT REPRESENT THE SURVEYOR'S WORK  
PRODUCT.

I HEREBY CERTIFY THAT THE ABOVE DESCRIBED PROPERTY HAS  
BEEN SURVEYED UNDER MY DIRECTION AND THAT THE ABOVE MAP  
IS A TRUE REPRESENTATION THEREOF AND SHOWS THE SIZE AND  
LOCATION OF THE PROPERTY AND ITS EXTERIOR BOUNDARIES.  
THIS SURVEY IS MADE FOR THE USE OF THE PRESENT OWNERS OF  
THE PROPERTY, AND ALSO THOSE WHO PURCHASE, MORTGAGE, OR  
GUARANTEE THE TITLE THERETO WITHIN ONE YEAR FROM THE DATE  
HEREOF.

DATED: 11-13-01

PETER S. GORDON R.L.S. 2101

SCDB15-1501  
005-1951