

1140 SEQUOIA STREET • DELAVAN, WISCONSIN 53115  
262-728-6737

**LOT 3**  
0.51 ACRES

LOT 4

LOT 3. COUNTRY CLUB ESTATES ADDITION "K".  
LOCATED IN THE VILLAGE OF FONTANA-ON-  
GENEVA LAKE, WALWORTH COUNTY, WISCONSIN.

ORDERED BY: DAN TRAPANI  
12 N. STRATFORD  
ARLINGTON HEIGHTS, IL 60004

DAVIS COURT

NOTE: BEARINGS ARE REFERENCED TO THE  
RECORDED SUBDIVISION PLAT.



SCALE 1" = 30'

### LEGEND

- ✂ - IRON PIPE FOUND  
 ✂ - IRON ROD FOUND  
 ○ - IRON PIPE SET  
 △ - UTILITY POLE  
 ● - CONCRETE MONUMENT FOUND  
 ( ) - RECORDED AS


I HEREBY CERTIFY THAT I HAVE SURVEYED THE ABOVE DESCRIBED PROPERTY AND THAT THE ABOVE MAP IS A TRUE REPRESENTATION THEREOF AND SHOWS THE SIZE AND LOCATION OF THE PROPERTY, ITS EXTERIOR BOUNDARIES, THE LOCATION OF ALL VISIBLE STRUCTURES AND DIMENSIONS OF ALL PRINCIPAL BUILDINGS THEREON, BOUNDARY FENCES, APPARENT EASEMENTS, ROADWAYS AND VISIBLE ENCROACHMENTS, IF ANY, TO THE BEST OF MY KNOWLEDGE AND BELIEF.

THIS SURVEY IS MADE FOR THE USE OF THE PRESENT OWNERS OF THE PROPERTY, AND ALSO THOSE WHO PURCHASE, MORTGAGE, OR GUARANTEE THE TITLE THERETO WITHIN ONE (1) YEAR FROM DATE HEREON.

DAVID F. ABELL  
WISCONSIN REGISTERED LAND SURVEYOR, S-1596

November 1, 2001

DATE \_\_\_\_\_ JOB NUMBER - 01158  
NOTE: THIS IS NOT A CERTIFIED COPY UNLESS SEALED.

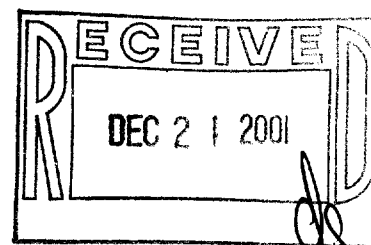

SCTK-3 ✓ ~~005~~-1957