





PLAT OF SURVEY  
UNIT 9 FONTANA CLUB CONDOMINIUM  
LOTS 1 THRU 4 OF BLOCK 9 &  
LOT 1 AND THE EAST 1/2 OF LOT 2 OF BLOCK 6  
GLENWOOD SPRINGS SUBDIVISION  
LOCATED IN THE VILLAGE OF FONTANA  
WALWORTH COUNTY, WISCONSIN

EXISTING RESIDENCE

FIP = FOUND IRON PIPE STAKE  
FRB = FOUND IRON REBAR STAKE  
PP = POWER POLE  
MH = MANHOLE  
CB = CATCH BASIN  
ST MH = STORM MANHOLE  
L.C.E. = LIMITED COMMON ELEMENT

NOTE: PARKING SPACES SHOWN ARE 10' WIDE BY 20' LONG


ASSIGNED WEST LINE LOTS 1 THRU 4 OF BLOCK 9  
N 02° 58' 05" W

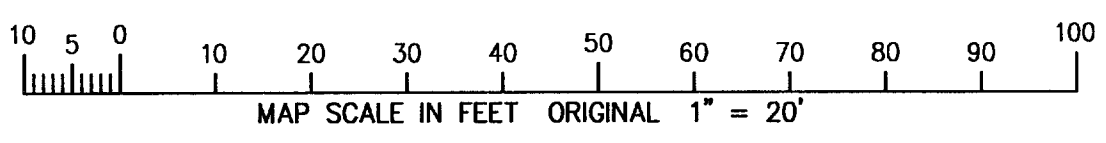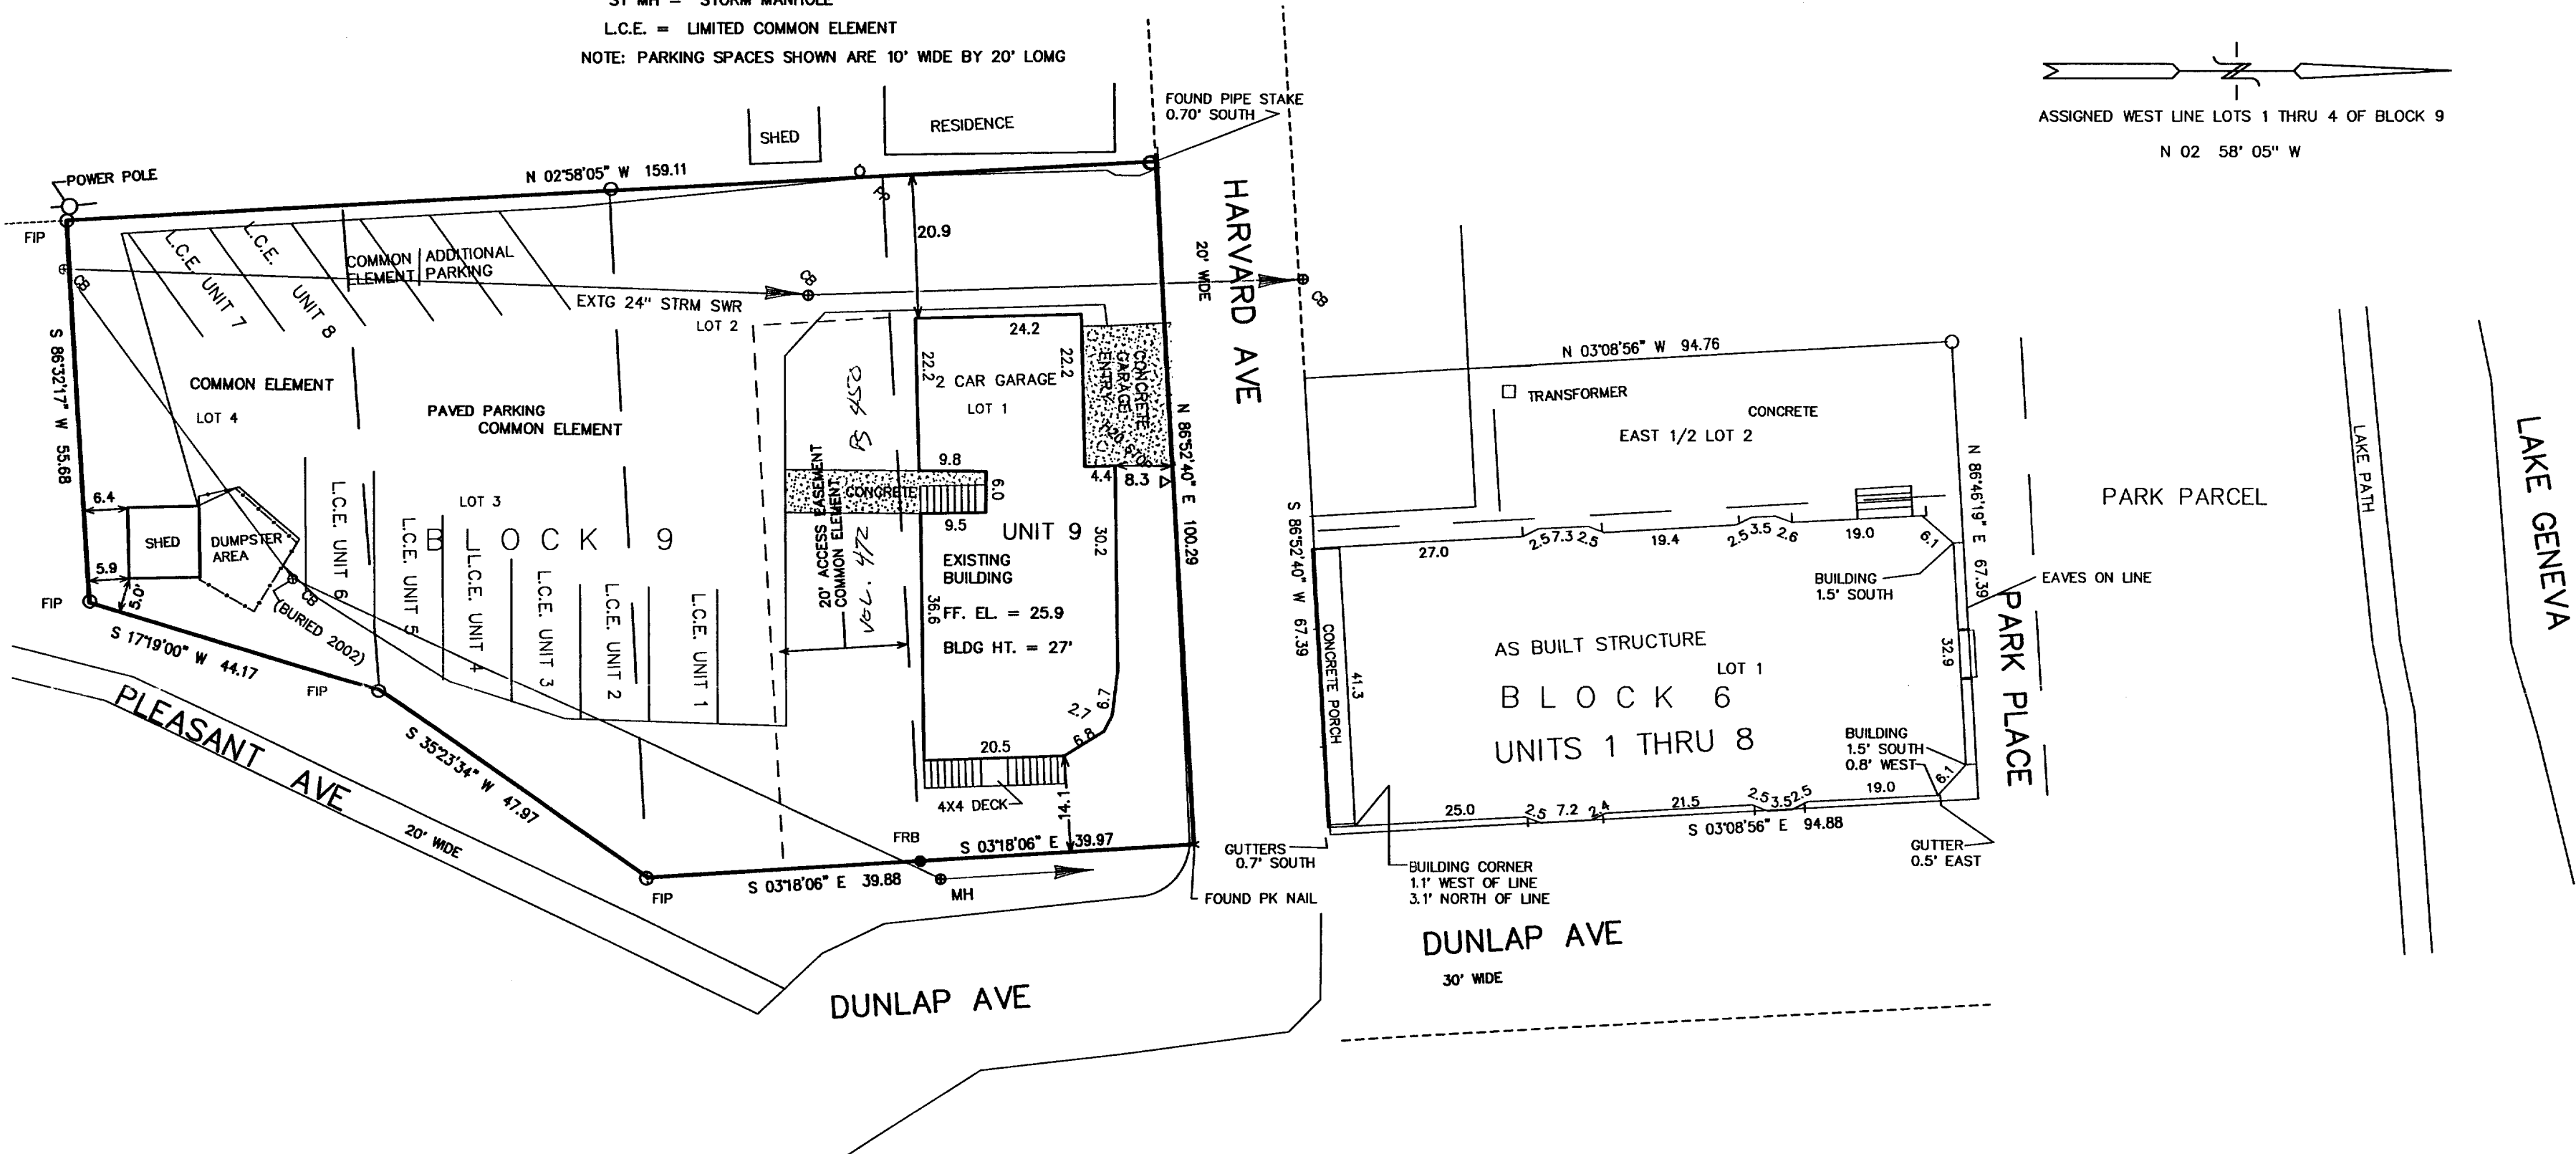

NOTE: COPIES OF THIS MAP TO WHICH THE FOLLOWING CERTIFICATE WILL APPLY SHOW SURVEYOR'S ORIGINAL SEAL AND SIGNATURE IN RED INK. COPIES BY ANY OTHER MEANS MAY HAVE ALTERATIONS WHICH DO NOT REPRESENT THE SURVEYOR'S WORK PRODUCT.

I HEREBY CERTIFY THAT THE ABOVE DESCRIBED PROPERTY HAS BEEN SURVEYED UNDER MY DIRECTION AND THAT THE ABOVE MAP IS A TRUE REPRESENTATION THEREOF AND SHOWS THE SIZE AND LOCATION OF THE PROPERTY, ITS EXTERIOR BOUNDARIES, THE LOCATION OF ALL VISIBLE STRUCTURES, AND DIMENSIONS OF ALL PRINCIPLE BUILDINGS THEREON, BOUNDARY FENCES, APPARENT EASEMENTS, ROADWAYS, AND VISIBLE ENCROACHMENTS, IF ANY. THIS SURVEY IS MADE FOR THE USE OF THE PRESENT OWNERS OF THE PROPERTY, AND ALSO THOSE WHO PURCHASE, MORTGAGE, OR GUARANTEE THE TITLE THERETO WITHIN ONE YEAR FROM THE DATE HEREOF.

DATED: 4-4-2002  
*Peter S. Gordon*  
PETER S. GORDON R.L.S. 2101

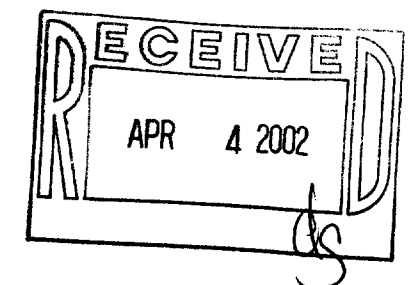

WORK ORDERED BY: PETER SCHWABE  
C/O KEEFE REAL ESTATE  
PO BOX 460  
LAKE GENEVA, WI. 53147

FARRIS, HANSEN & ASSOCIATES, INC.  
Engineering, Architecture, Surveying  
7 Ridgeway Court P.O. Box 437  
ELKHORN, WISCONSIN 53121  
Office: (262) 723-2098  
Fax: (262) 723-5886

REVISIONS	
PROJECT NO.	4673.02
DATE:	04-03-02
SHEET NO.	1 OF 1

APR 03 2002

SFC-91 005-1971