
and ASSOCIATES ABERNATHY Kenneth B. Abernathy Jr. Wisconsin Registered Land Surveyor PLAT 0 F

W4056 **BRAY RD**. ELKHORN, WI. 53121

PHONE: (262) 723-4260 (OFFICE) (262) 723-7209 (FAX)

S-1594 Email: abernathy@elknet.net

Owner: Pontiac National Bank, Trustee Trust No. 2350-99 223 N. Mill St. Pontiac, Il. 61764

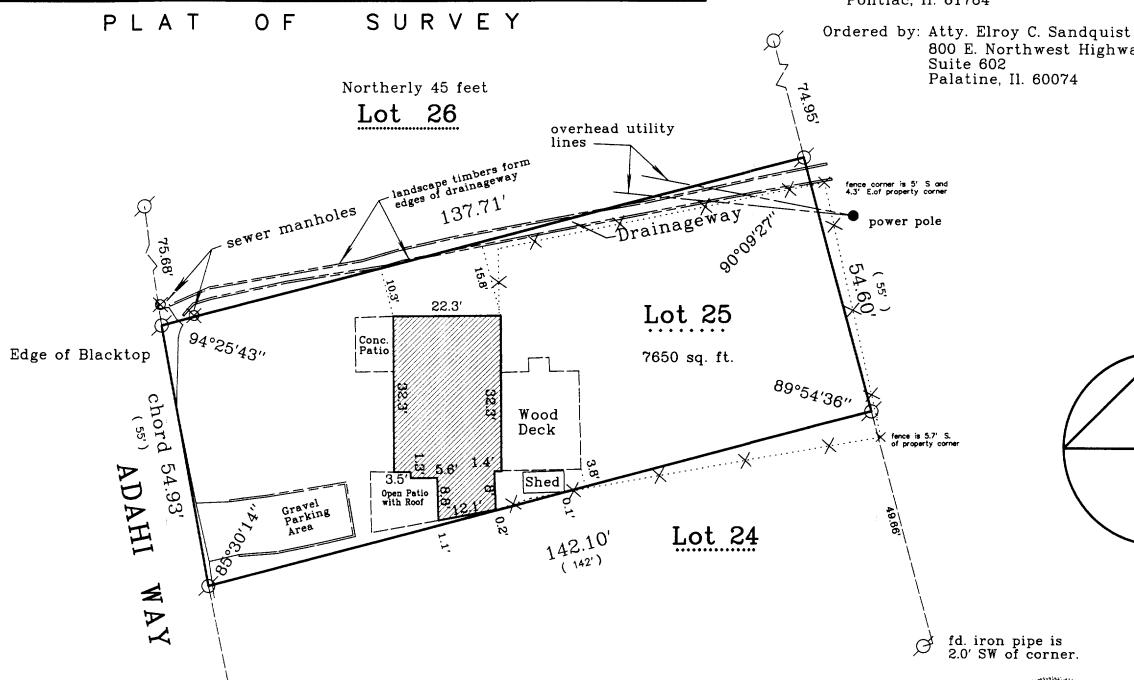

Legal Description: Vol. 669 P. 3192 Doc. No. 436507

Meridian, reference being had to the plat thereof recorded March 26, 1927 in Volume 8

of plats, pages 109 and 110, in Walworth

County. Wisconsin.

Lot Twenty-five (25) and Lot Twenty-Six (26) (except the North Forty-five (45) feet measured on the Easterly and Westerly lines thereof) in Block Five (5) in Indian Hills, being a Subdivision on Government Lot Four (4) in Section Fourteen (14), Township One (1) North, Range Sixteen (16) East of the Fourth Principal Meridian reference being had to the plat

800 E. Northwest Highway

Legend

FOUND IRON PIPE FOUND IRON ROD

 \boxtimes FOUND BRASS CAPPED MONUMENT

FOUND CONCRETE MONUMENT


CHISEL CUT IN CONCRETE


SET IRON ROD, 24" LONG, WEIGHING 1.5 LBS./LINEAL FT., 3/4" DIA.

SET IRON ROD, 30" LONG, WEIGHING 4.5 LBS./LINEAL FT., 1-11/16" DIA.

RECORDED AS DIMENSION

EXISTING FENCE

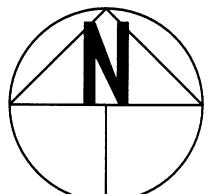

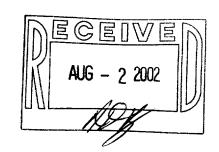

SCALE: 1'' = 20 FEET

"I hereby certify that the above described property has been surveyed by me or under my direction and that the above map is a true representation thereof and shows the size and location of the property, its exterior boundaries, the location of all visible structures and dimensions of all principal buildings thereon, boundary fences, apparent easements, roadways and visible encroachments, if any."

"This survey is made for the use of the present owners of the property, and also those who purchase, mortgage, or guarantee the title thereto within one year from the date hereof."

KENNETH B. ABERNATHY, JR. WISCONSIN RECISTERED LAND SURVEYOR.

Date:_July 29,2002

S-1594 Job No. <u>02.</u>712

SCONS KENNETH B. ABERNATHY, JR. S-1594 ELKHORN WI