ABERNATHY and ASSOCIATES

Kenneth B. Abernathy Jr.

|W4056 BRAY RD. **ELKHORN. WI.** 53121


PHONE: (262) 723-4260 (OFFICE) (262) 723-7209 (FAX)

Wisconsin Registered Land Surveyor

\$-1594 **Email:** abernathy@elknet.net

SURVEY 0 F PLAT

LOTS 15 AND 16 OF BLOCK 5 OF INDIAN HILLS, A SUBDIVISION LOCATED IN THE VILLAGE OF FONTANA-ON-GENEVA LAKE, WALWORTH COUNTY, WISCONSIN.

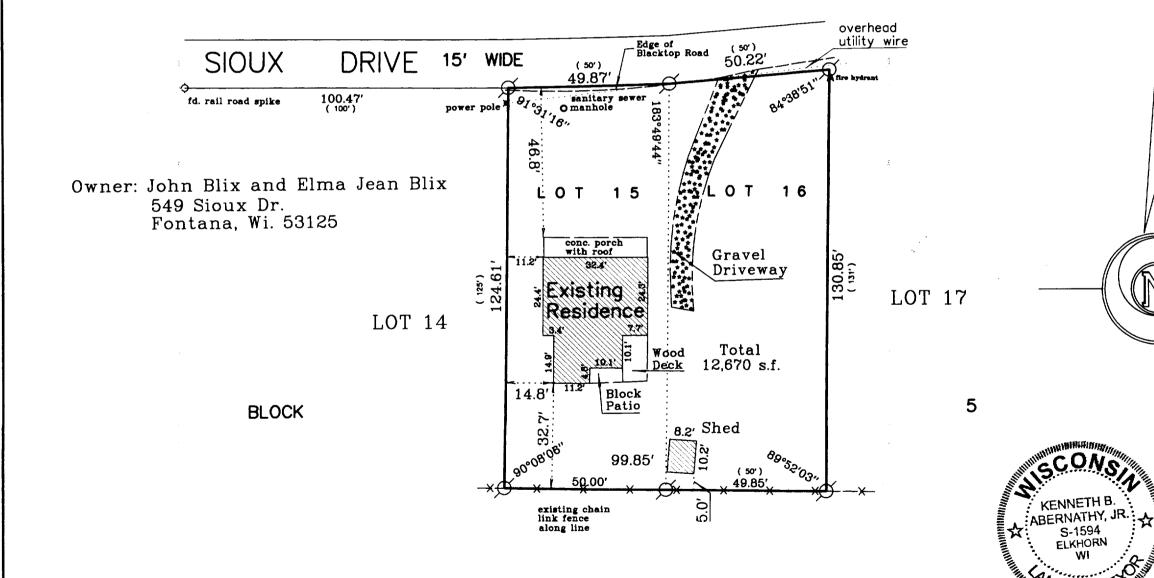

Legend

FOUND IRON PIPE

FOUND IRON ROD

FOUND BRASS CAPPED MONUMENT

FOUND CONCRETE MONUMENT


CHISEL CUT IN CONCRETE

SET IRON ROD, 24" LONG, WEIGHING 1.5 LBS./LINEAL FT., 3/4" DIA.

SET IRON ROD, 30" LONG, WEIGHING 4.5 LBS./LINEAL FT., 1-11/16" DIA.

RECORDED AS DIMENSION (xx)

EXISTING FENCE

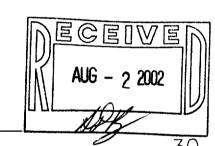

SCALE: $1'' = \frac{30}{100}$ FEET

"I hereby certify that the above described property has been surveyed by me or under my direction and that the above map is a true representation thereof and shows the size and location of the property, its exterior boundaries, the location of all visible structures and dimensions of all principal buildings thereon, boundary fences, apparent easements, roadways and visible encroachments,

"This survey is made for the use of the present owners of the property, and also those who purchase, mortgage, or guarantee the title thereto within one year from the date hereof."

KENNETH B. ABERNATHY, JR. WISCONSIN REGISTERED LAND SURVEYOR.

Date: June 19, 2002

KENNETH B.

S-1594 ELKHORN

> **S**-1594 Job No. 02.606