


1140 SEQUOIA STREET • DELAVAN, WISCONSIN 53115
262-728-6737

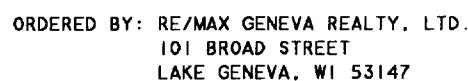

LOT 9, BLOCK E, UNIT 3 OF COUNTRY CLUB ESTATES,
LOCATED IN THE VILLAGE OF FONTANA-ON-GENEVA LAKE,
WALWORTH COUNTY, WISCONSIN.

Ø - IRON PIPE FOUND
 ■ - CONCRETE MONUMENT FOUND
 △ - UTILITY POLE
 CS - CONCRETE STOOP
 ← - GUY WIRE
 () - RECORDED AS

DATE 7/1/77 JOB NUMBER - 02060
NOTE: THIS IS NOT A CERTIFIED COPY UNLESS SEALED.

