



BOUNDARY & TOPOGRAPHIC SURVEY
LOT 4 OF BLOCK 12
GLENWOOD SPRINGS SUBDIVISION

LOCATED IN THE VILLAGE OF FONTANA-ON-GENEVA LAKE
WALWORTH COUNTY, WISCONSIN

WORK ORDERED BY: JORNDT BUILDERS
FOR: JAKE BIEDLER
815 TIMBERLANE DRIVE
GLENVIEW, IL 60025


FARRIS, HANSEN & ASSOCIATES, INC.
ENGINEERING - ARCHITECTURE - SURVEYING
7 RIDGWAY COURT P.O. BOX 437
ELKHORN, WISCONSIN 53121
OFFICE: (262) 723-2098 FAX: (262) 723-5886

REVISIONS

PROJECT NO.
5875
DATE:
10-09-01
SHEET NO.
1 OF 1

DUNLAP AVENUE

50' WIDE

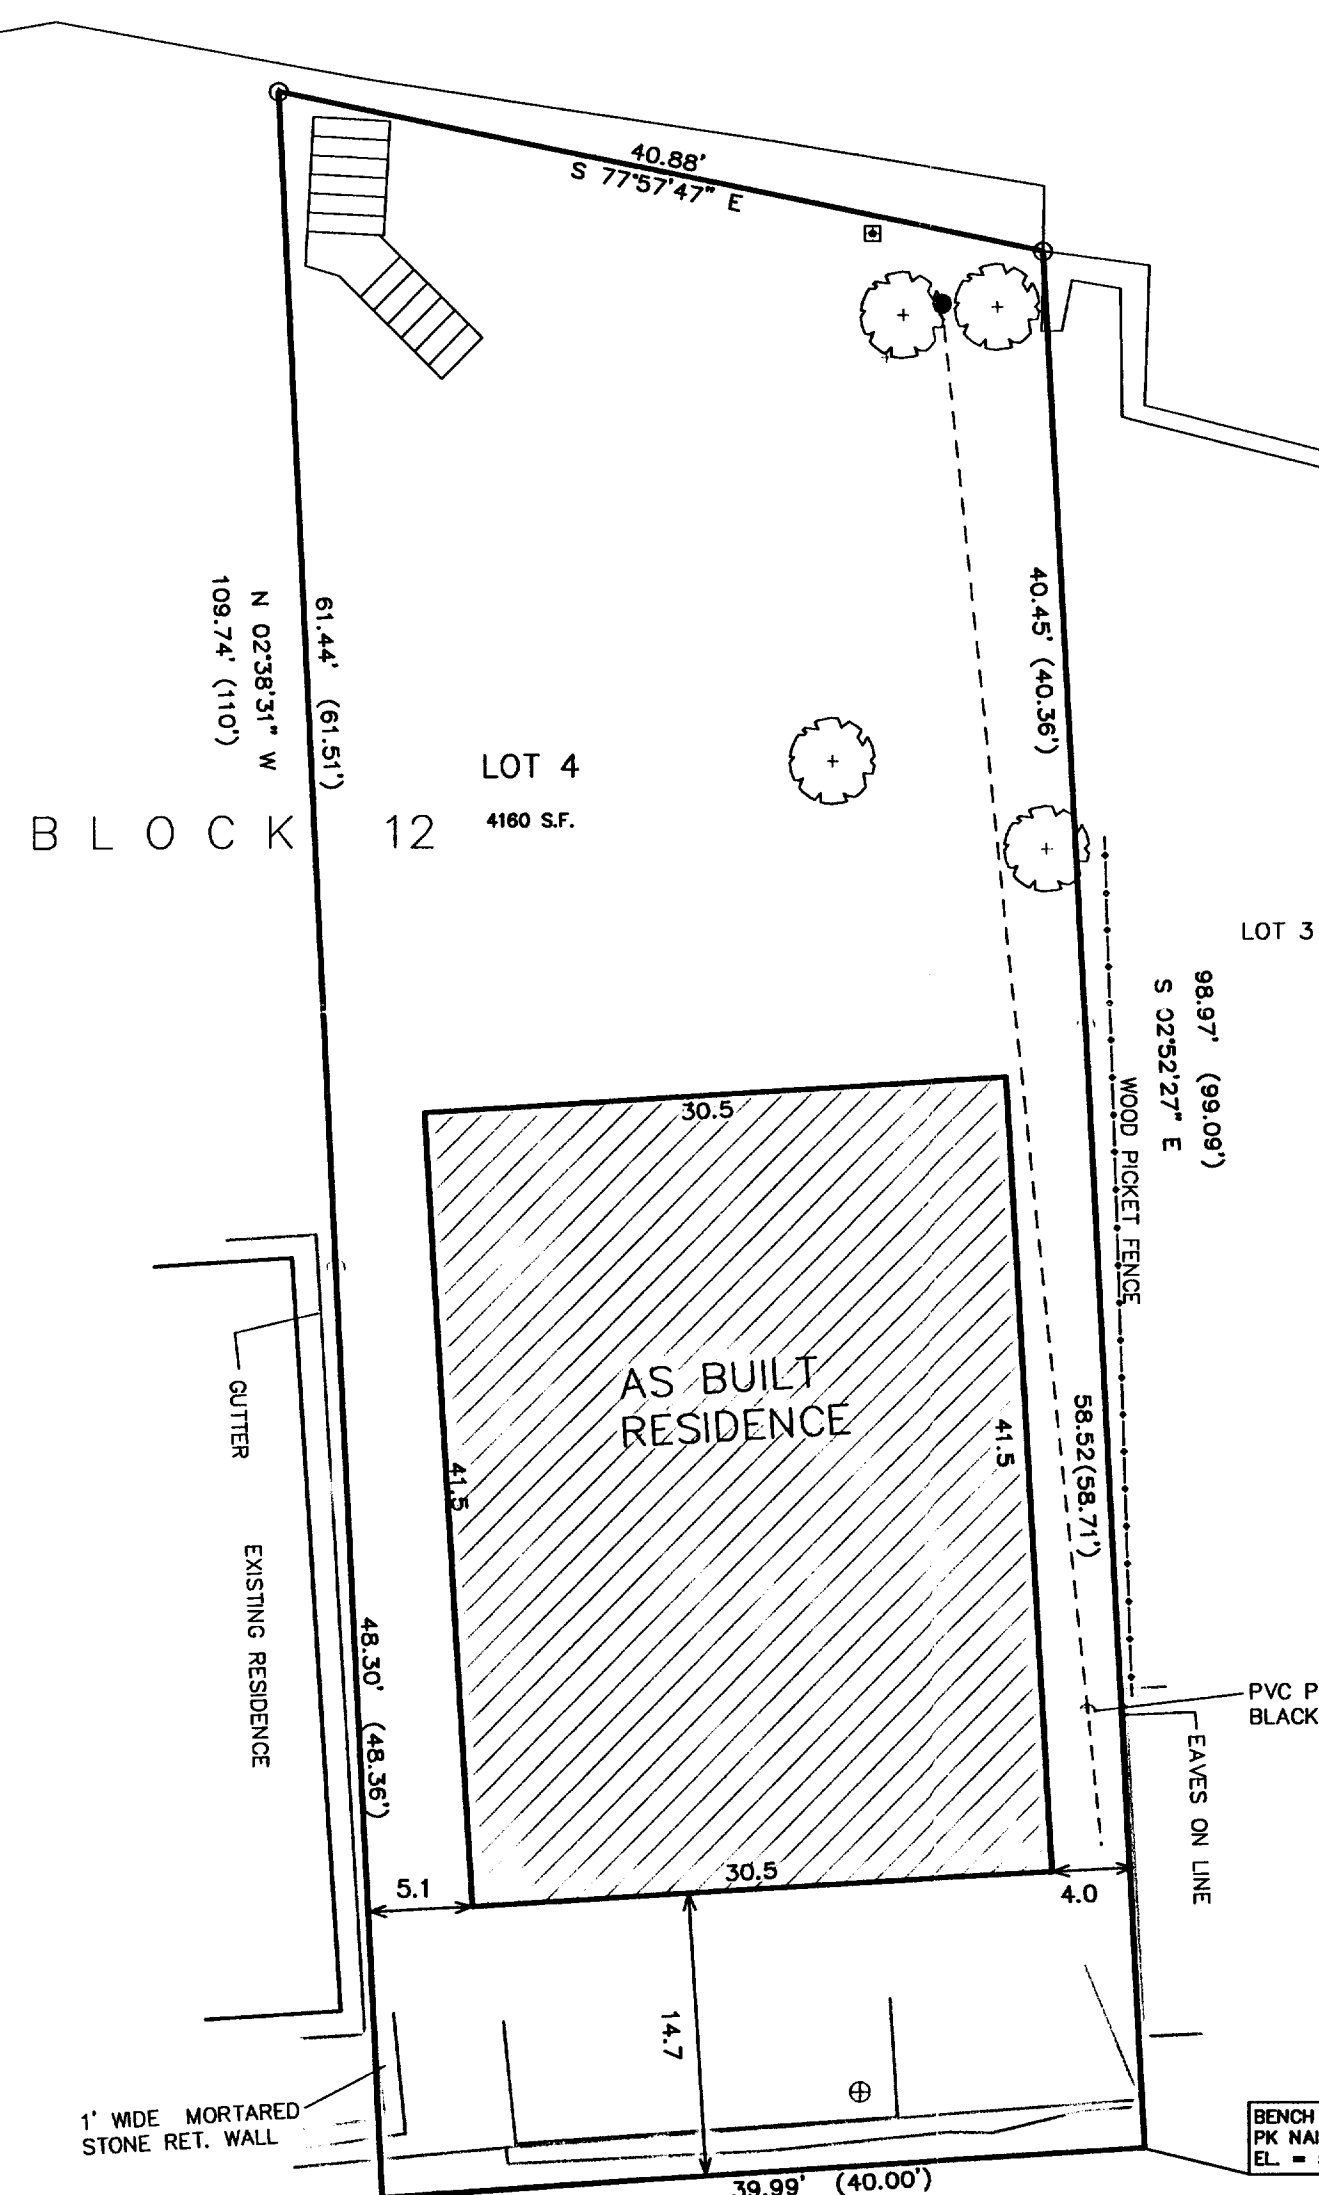

- = FOUND IRON PIPE STAKE 1" DIA.
- ✕ = SET NAIL IN PAVEMENT
- * = FOUND PK NAIL IN PAVEMENT
- (xxx) = RECORDED AS

NOTE: COPIES OF THIS MAP TO WHICH THE FOLLOWING
CERTIFICATE WILL APPLY SHOW SURVEYOR'S ORIGINAL SEAL AND
SIGNATURE IN RED INK. COPIES BY ANY OTHER MEANS MAY HAVE
ALTERATIONS WHICH DO NOT REPRESENT THE SURVEYOR'S WORK
PRODUCT.

I HEREBY CERTIFY THAT THE ABOVE DESCRIBED PROPERTY HAS
BEEN SURVEYED UNDER MY DIRECTION AND THAT THE ABOVE MAP
IS A TRUE REPRESENTATION THEREOF AND SHOWS THE SIZE AND
LOCATION OF THE PROPERTY AND ITS EXTERIOR BOUNDARIES.
THIS SURVEY IS MADE FOR THE USE OF THE PRESENT OWNERS OF
THE PROPERTY, AND ALSO THOSE WHO PURCHASE, MORTGAGE, OR
GUARANTEE THE TITLE THERETO WITHIN ONE YEAR FROM THE DATE
HEREOF.

DATED: OCT. 24, 2001

REVISED 10-03-02
TO SHOW SIZE &
LOCATION OF
PROPOSED RESIDENCE

PETER S. GORDON R.L.S. 2101

REVISED 12-04-02
TO SHOW SIZE & LOCATION
OF RESIDENCE AS BUILT

