

ABERNATHY and ASSOCIATES

Kenneth B. Abernathy Jr.

Wisconsin Registered Land Surveyor S-1594


W4056 BRAY RD.
ELKHORN, WI. 53121
PHONE: (262) 723-4260 (OFFICE)
(262) 723-7209 (FAX)
Email: abernathy@elknet.net

PLAT OF SURVEY

LOT 10, BLOCK 1 OF BROOKWOOD SUBDIVISION, LOCATED IN THE NORTHWEST 1/4 OF THE SOUTHWEST 1/4 OF SECTION 18, TOWN 1 NORTH, RANGE 17 EAST, VILLAGE OF FONTANA, WALWORTH COUNTY, WISCONSIN.
ALSO A PART OF LOT 11 IN BLOCK 1 OF SAID BROOKWOOD SUBDIVISION AS FOUND IN VOL. 29, PAGE 747, DOCUMENT NUMBER 625446 OF WALWORTH COUNTY RECORDS DESCRIBED AS FOLLOWS; TO WIT: BEGIN AT THE NORTHWEST CORNER OF SAID LOT 11 IN BLOCK 1; THENCE N 75°10' E 182.41 FEET TO AN IRON PIPE; THENCE S 20°53' E 44.50 FEET TO AN IRON PIPE; THENCE S 51°33' W 54.47 FEET TO AN IRON PIPE; THENCE N 80°24' W 151.71 FEET TO AN IRON PIPE; THENCE N 0°49' W 3.45 FEET TO AN IRON PIPE AND THE POINT OF BEGINNING TO THIS DESCRIPTION.


ORDERED BY:
HUMMEL CONSTRUCTION
N 1958 COUNTY ROAD "O"
DELAVER, WI 53115

LOT 9

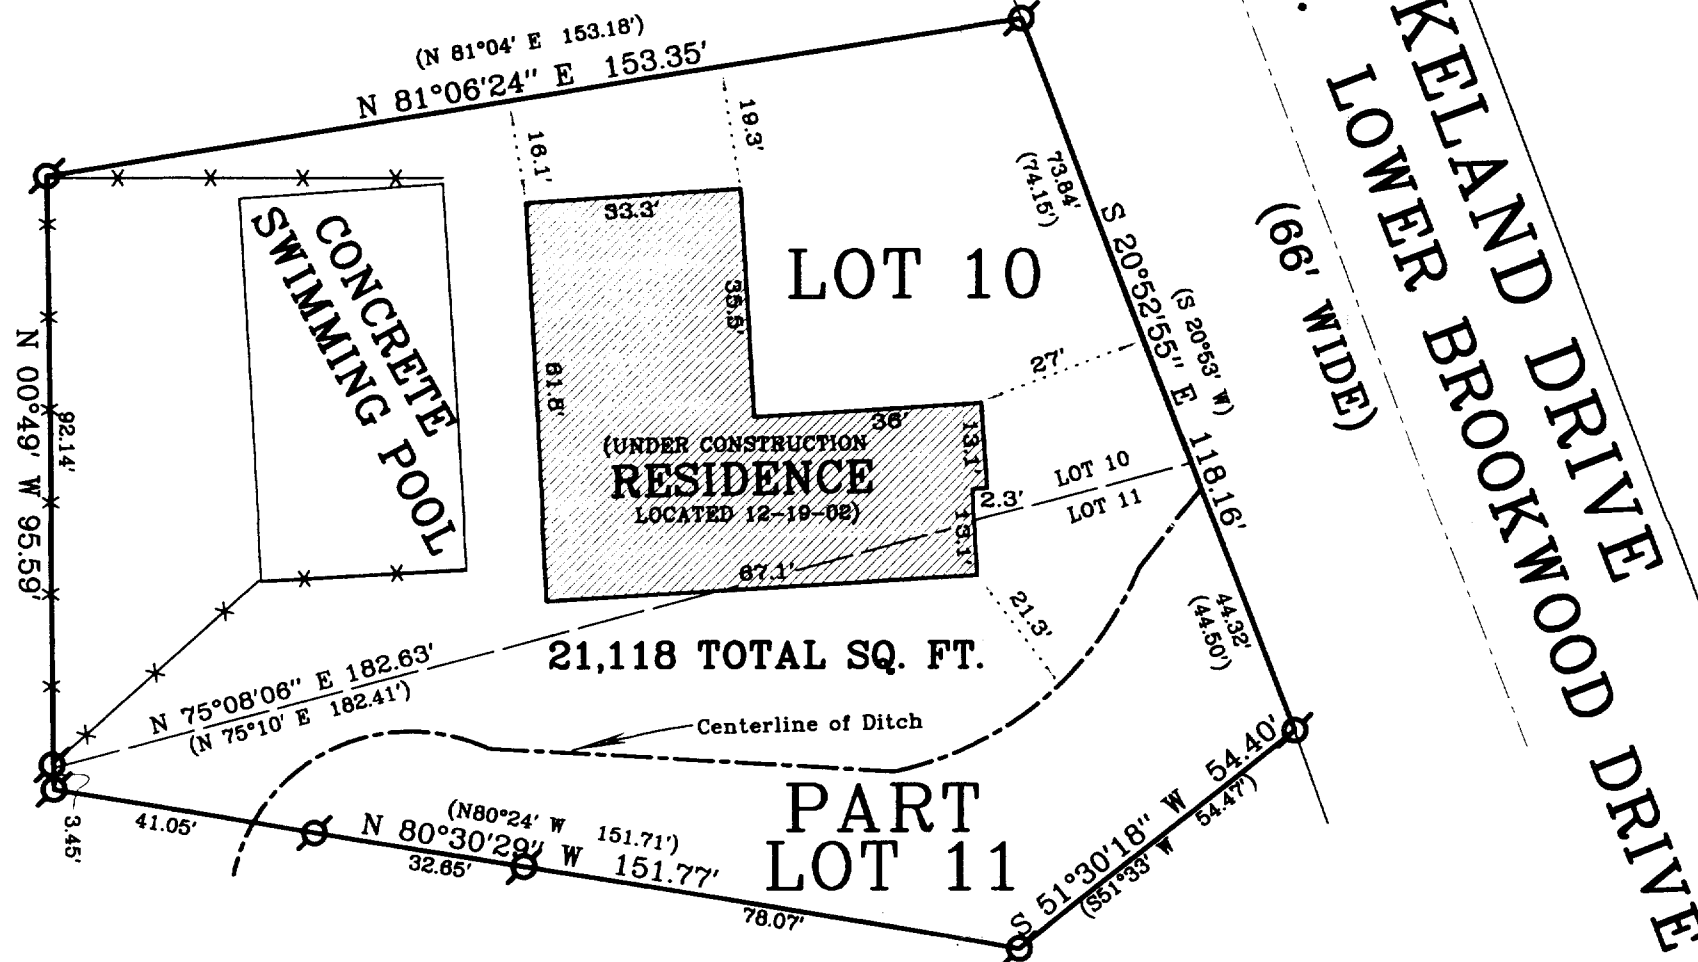

Legend

- FOUND IRON PIPE
- FOUND IRON ROD
- ⊠ FOUND BRASS CAPPED MONUMENT
- FOUND CONCRETE MONUMENT
- + CHISEL CUT IN CONCRETE
- SET IRON ROD, 24" LONG, WEIGHING 1.5 LBS./LINEAL FT., 3/4" DIA.
- SET IRON ROD, 30" LONG, WEIGHING 4.5 LBS./LINEAL FT., 1-11/16" DIA.
- (x x) RECORDED AS DIMENSION
- x — EXISTING FENCE

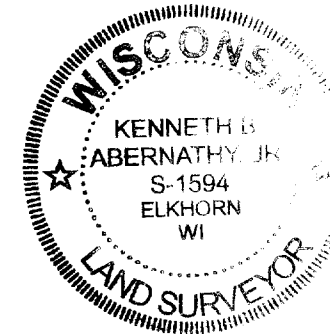

SCALE: 1" = 30 FEET

"I hereby certify that the above described property has been surveyed by me or under my direction and that the above map is a true representation thereof and shows the size and location of the property, its exterior boundaries, the location of all visible structures and dimensions of all principal buildings thereon, boundary fences, apparent easements, roadways and visible encroachments, if any."
"This survey is made for the use of the present owners of the property, and also those who purchase, mortgage, or guarantee the title thereto within one year from the date hereof."

Kenneth B. Abernathy, Jr.

KENNETH B. ABERNATHY, JR.
WISCONSIN REGISTERED LAND SURVEYOR,
S-1594

Date: DEC. 31, 2002 Job No. 02.1003