



ABELL SURVEYING & MAPPING

1140 SEQUOIA STREET • DELAVAN, WISCONSIN 53115
262-728-6737

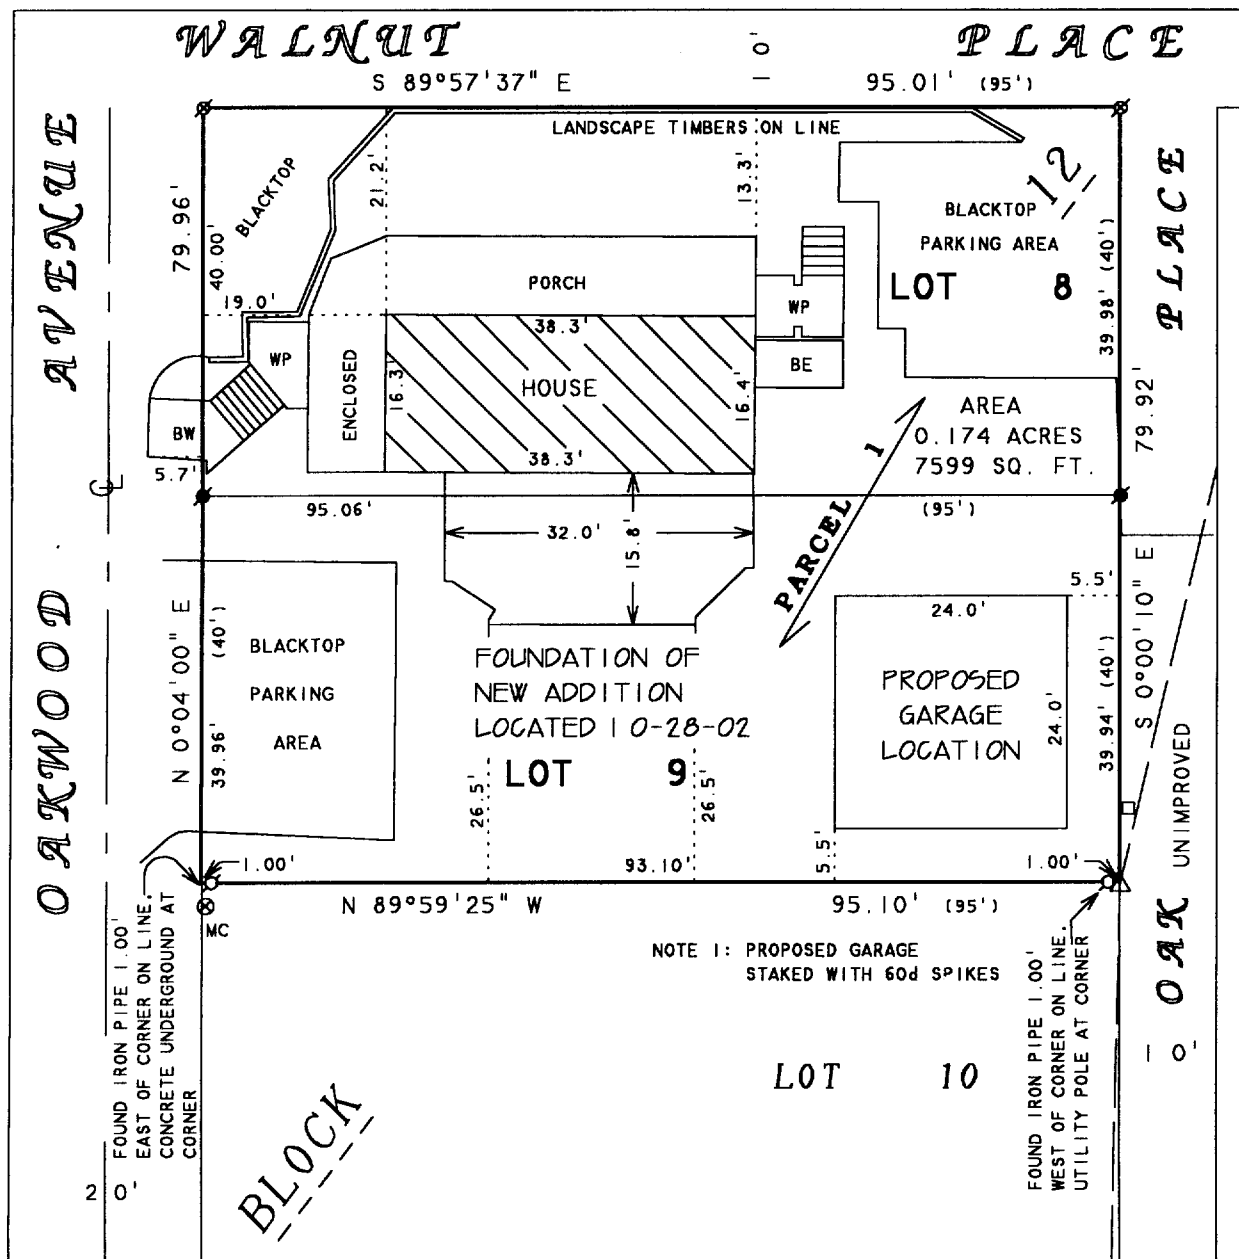

PLAT OF SURVEY OF

PARCEL 1: LOTS 8 AND 9, BLOCK 12
GLENWOOD SPRINGS, VILLAGE OF FONTANA-
ON-GENEVA LAKE, WALWORTH COUNTY,
WISCONSIN.

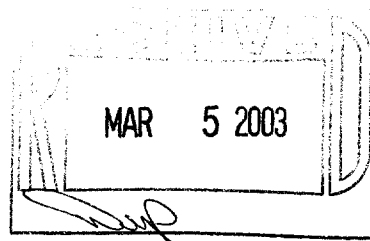

I HEREBY CERTIFY THAT I HAVE SURVEYED THE ABOVE DESCRIBED PROPERTY AND THAT THE ABOVE MAP IS A TRUE REPRESENTATION THEREOF AND SHOWS THE SIZE AND LOCATION OF THE PROPERTY, ITS EXTERIOR BOUNDARIES, THE LOCATION OF ALL VISIBLE STRUCTURES AND DIMENSIONS OF ALL PRINCIPAL BUILDINGS THEREON, BOUNDARY FENCES, APPARENT EASEMENTS, ROADWAYS AND VISIBLE ENCROACHMENTS, IF ANY, TO THE BEST OF MY KNOWLEDGE AND BELIEF.

THIS SURVEY IS MADE FOR THE USE OF THE PRESENT OWNERS OF THE PROPERTY, AND ALSO THOSE WHO PURCHASE, MORTGAGE, OR GUARANTEE THE TITLE THERETO WITHIN ONE (1) YEAR FROM DATE HEREON.

David F. Abell
DAVID F. ABELL
WISCONSIN REGISTERED LAND SURVEYOR, S-1596

October 29, 2002

DATE JOB NUMBER - 01118H
NOTE: THIS IS NOT A CERTIFIED COPY UNLESS SEALED.

- LEGEND**
- -IRON PIPE FOUND
 - -IRON ROD FOUND
 - ⊗ -PK NAIL FOUND IN BLACKTOP
 - △ -UTILITY POLE
 - -UTILITY PED.
 - -OVERHEAD UTILITY LINES
 - ⊗MC -METAL COVER
 - WP -WOOD PORCH
 - BE -BASEMENT ENTRY
 - BW -BLOCK WALK
 - () -RECORDED AS

REVISED DATE: NOVEMBER 14, 2002
REVISED TO SHOW NEW PROPOSED
GARAGE LOCATION.

ORDERED BY: TAGGART REAL ESTATE
797 WELLS STREET
LAKE GENEVA, WI 53147

SGS-66
SGS-67

005-2057