


DUNHAM SURVEYING, S.C.  
SURVEYING & SUBDIVIDING  
DELAVAN, WISCONSIN 53115

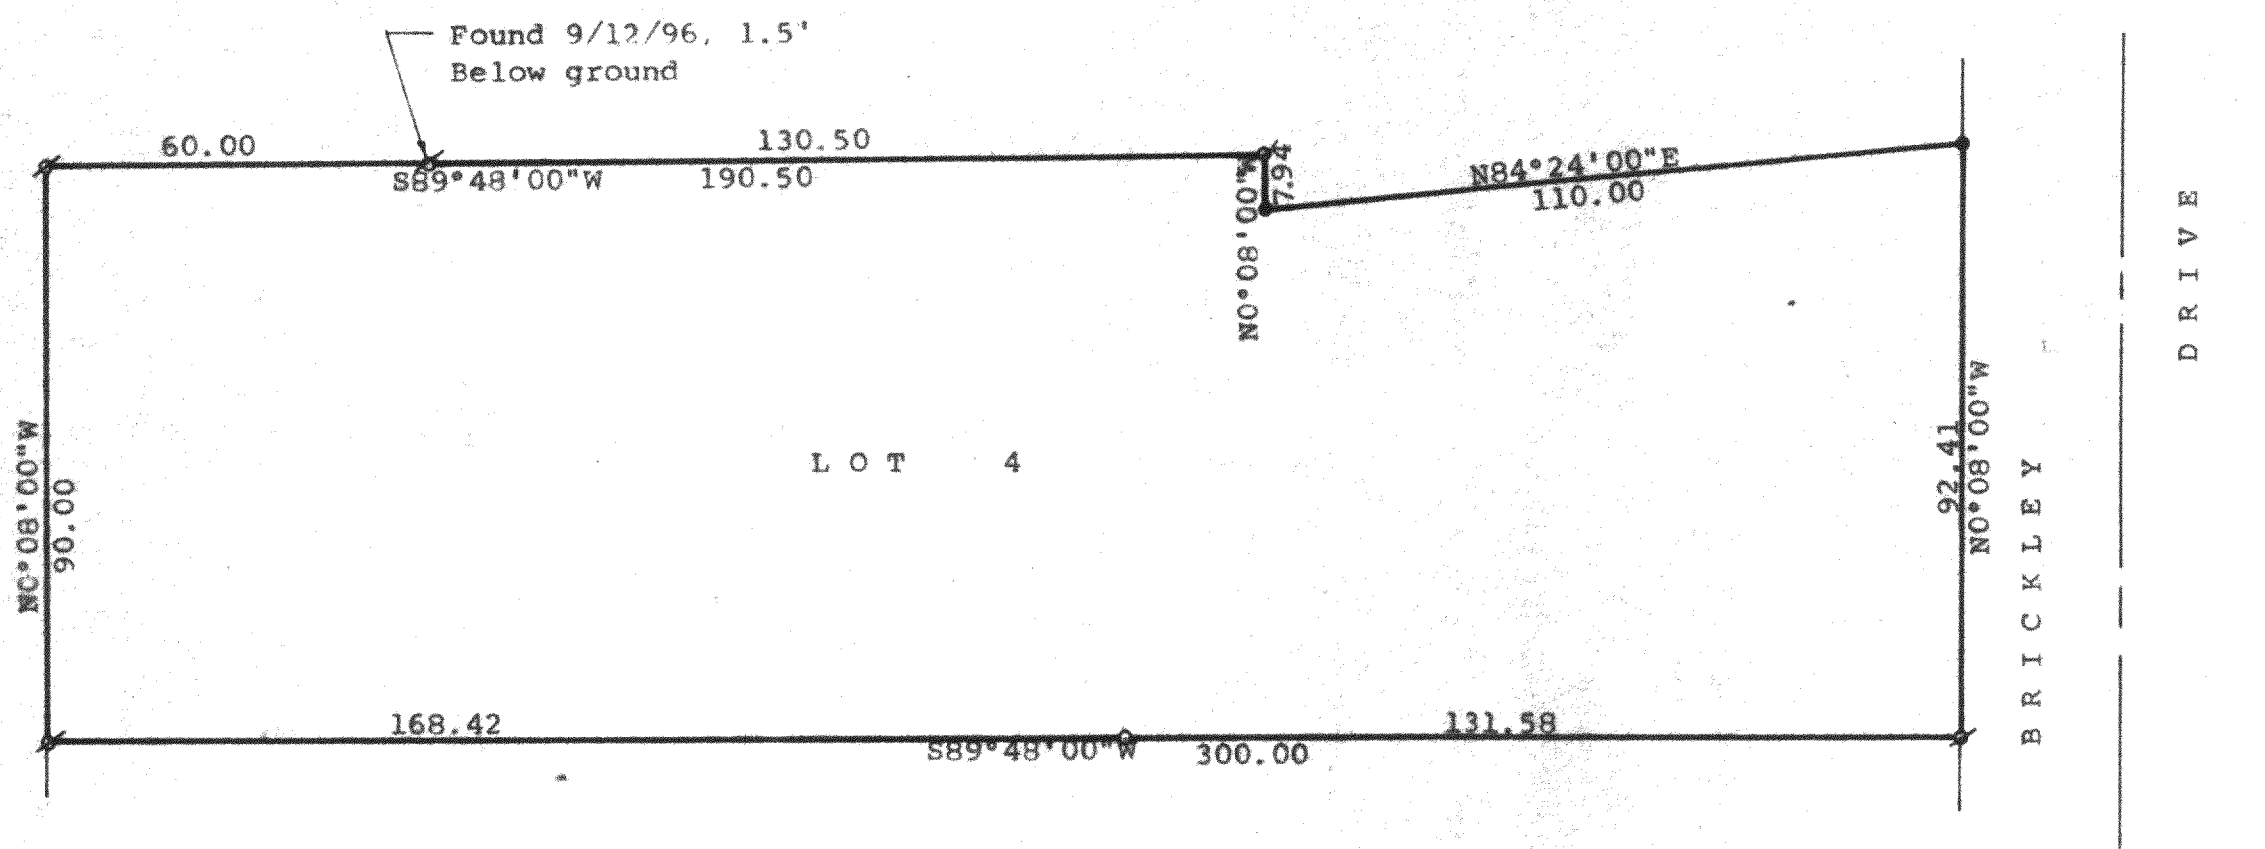

Scale - 1" = 30'  
 ⌀ = 1" Iron Pipe  
 ○ = 1/2" Iron Pipe  
 ● = 2" Iron Pipe  
 Bearings are those on the recorded plat  
 of Spring Valley Estates

STATE OF WISCONSIN)  
 COUNTY OF WALWORTH) SS

I, George T. Dunham, Surveyor, certify that I have surveyed the  
 property described as follows:

Lot 4 in Spring Valley Estates, a subdivision located in Government  
 Lot 3 in the Southeast 1/4 of Section 14, T 1 N, R 16 E, Village of  
 Fontana-on-Geneva Lake, Walworth County, Wisconsin,

and that the plat shown hereon is a correct representation thereof and shows  
 the size and location of the property, its exterior boundaries, the location  
 of all visible structures and dimensions of all principal buildings thereon,  
 boundary fences, apparent easements, roadways and visible encroachments, if  
 any, and that I have surveyed the property hereon described, according to the  
 official records, to the best of my knowledge and belief.

May 31, 1990

Updated and recertified to this  
 12th day of September, 1996

*George T. Dunham*  
 George T. Dunham, Surveyor

