


HAROLD H. KOLB
 REGISTERED PROFESSIONAL LAND SURVEYOR
 LAKE GENEVA, WISCONSIN

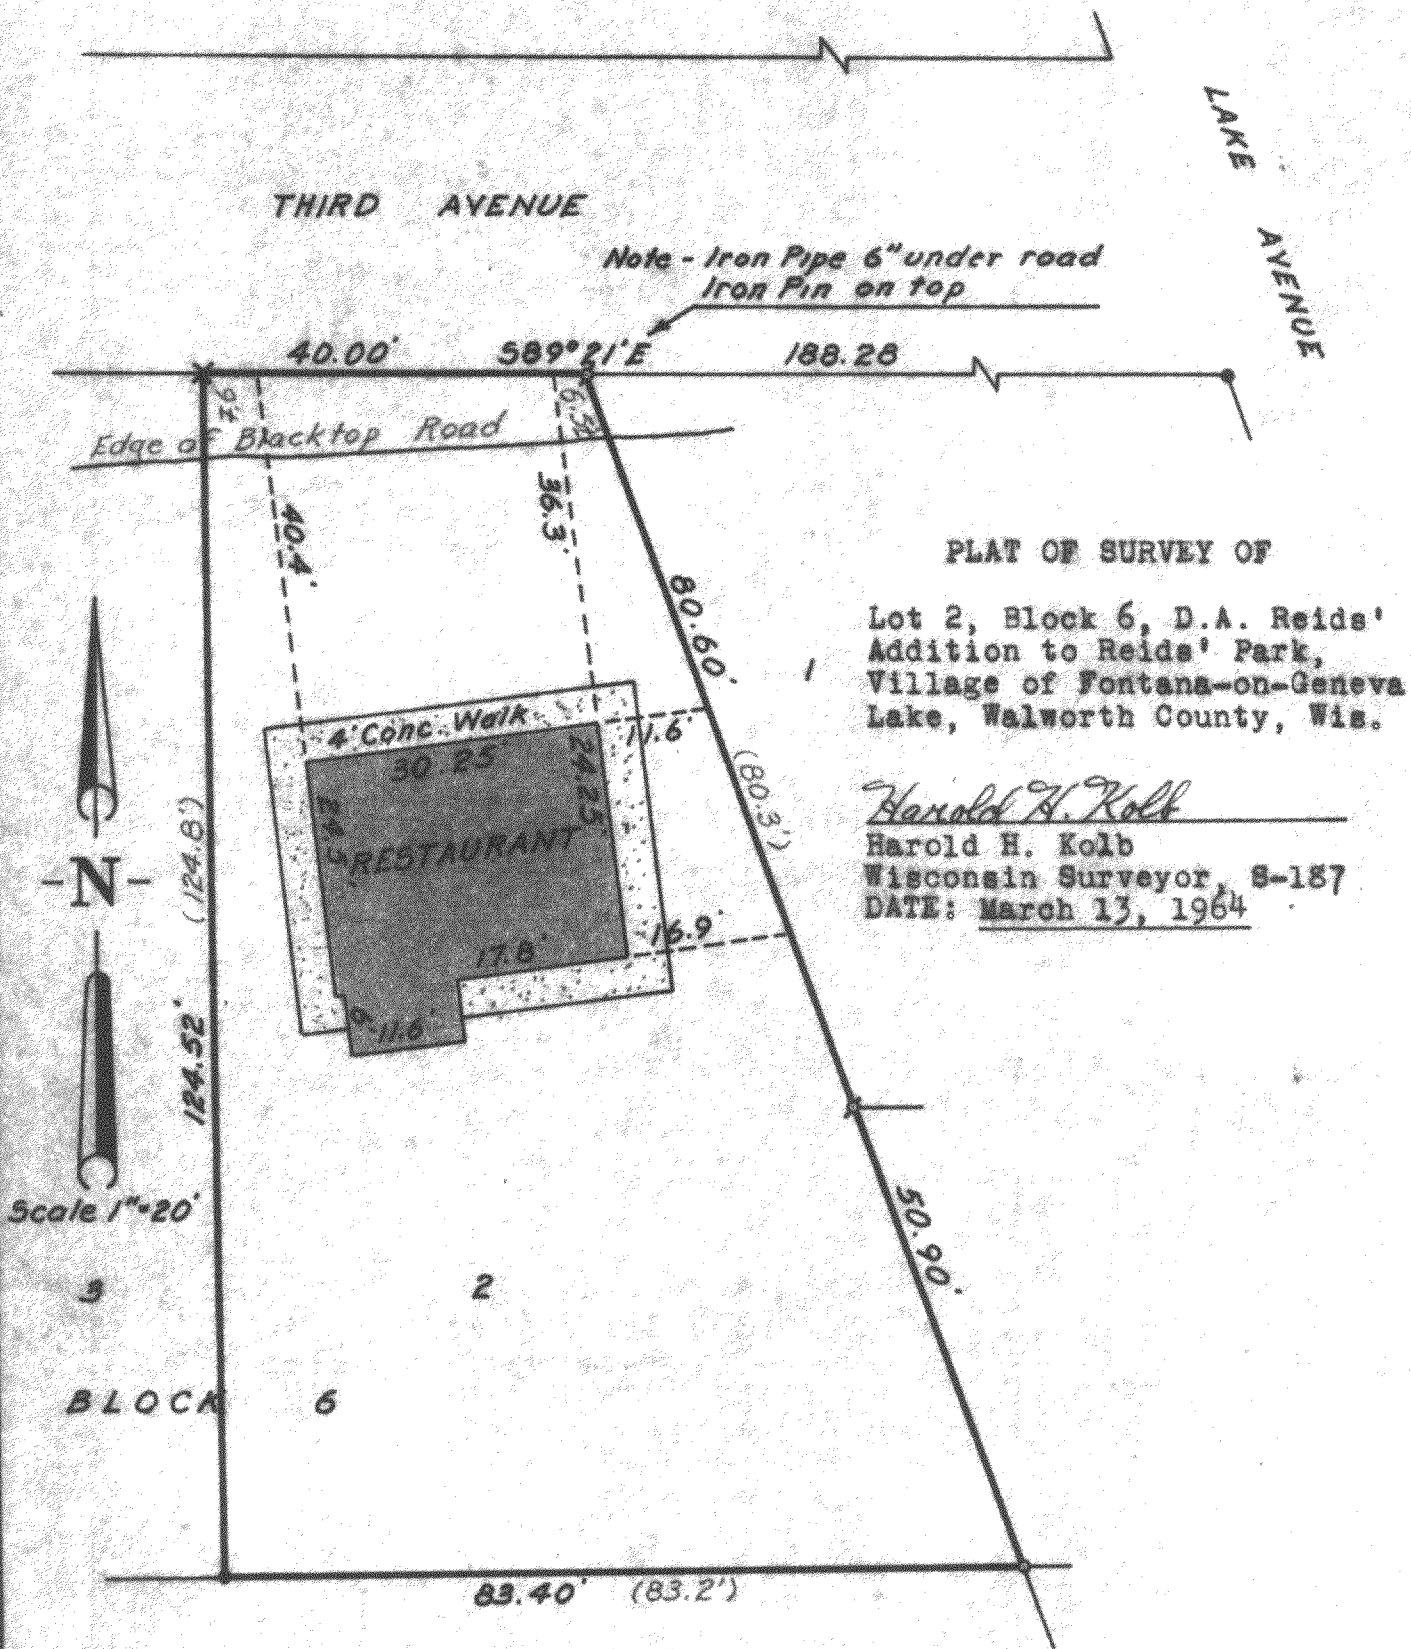

- (2') Platted Distance
 x Railroad Spike Placed
 • Concrete Monument Found
 s Iron Pipe Found
 o Iron Pipe Placed

5-211

F-26