


HAROLD H. KOLB  
 REGISTERED PROFESSIONAL LAND SURVEYOR  
 LAKE GENEVA, WISCONSIN

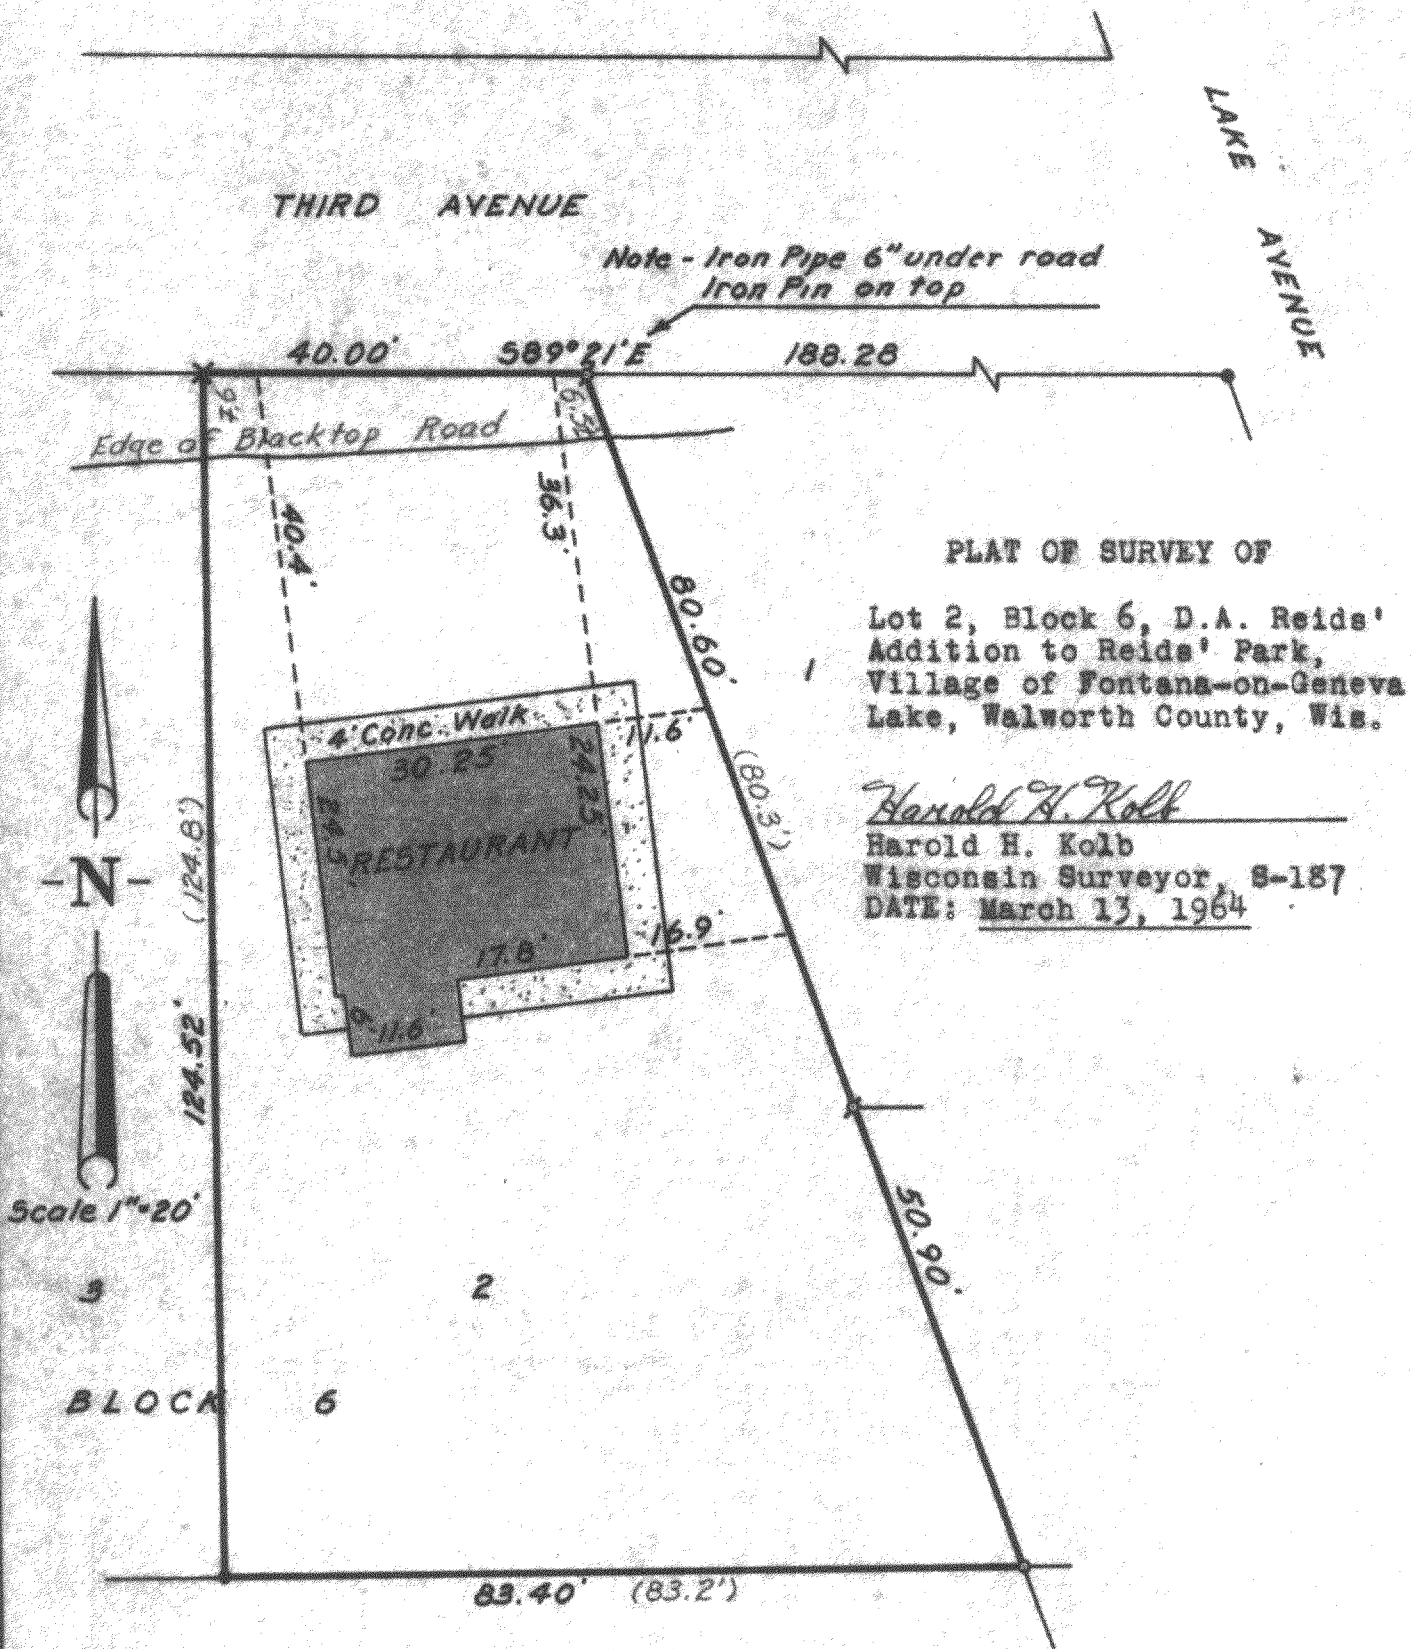

- (2') Platted Distance  
 x Railroad Spike Placed  
 • Concrete Monument Found  
 s Iron Pipe Found  
 o Iron Pipe Placed

5-211

F-26