


LOT 4 OF COUNTRY CLUB ESTATES ADDITION "K"
LOCATED IN THE VILLAGE OF FONTANA-ON-GENEVA LAKE
WALWORTH COUNTY, WISCONSIN

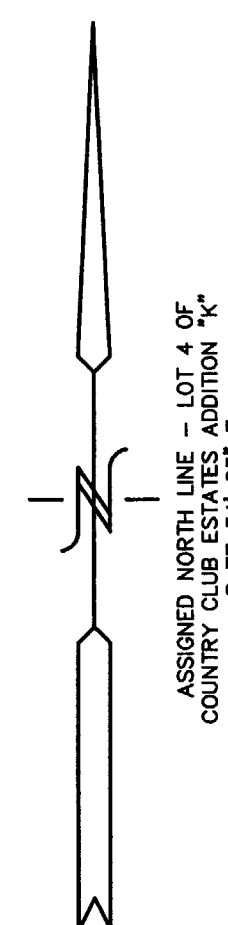

ASSIGNED NORTH LINE - LOT 4 OF
COUNTRY CLUB ESTATES ADDITION "K"

○ = FOUND IRON PIPE STAKE
● = FOUND IRON REBAR STAKE
⦿ = SET IRON REBAR STAKE
(xxx) = RECORDRD AS

LOT 3

LOT 4
29,043 S.F.

NOTE: *EASEMENT FROM ARTHUR B. JENSEN TO WISCONSIN SOUTHERN GAS COMPANY
RECORDED IN VOLUME 210 OF DEEDS AT PAGE 52, AS DOCUMENT NO. 278479*
DOES NOT REFERENCE ANY SPECIFIC LOCATION OR WIDTH.

COUNTRY CLUB ESTATE UNIT NO. "2"

DAVIS COURT
66' WIDE R.O.W.


MH ⊕ BENCH MARK
ASSIGNED RIM MH = 199.59'

LOT 5

NOTE: COPIES OF THIS MAP TO WHICH THE FOLLOWING CERTIFICATE WILL APPLY SHOW THE SURVEYOR'S ORIGINAL SEAL AND SIGNATURE IN RED INK. COPIES BY ANY OTHER MEANS MAY HAVE ALTERATIONS WHICH DO NOT REPRESENT THE SURVEYOR'S WORK PRODUCT.

I HEREBY CERTIFY THAT THE ABOVE DESCRIBED PROPERTY HAS BEEN SURVEYED UNDER MY DIRECTION AND THAT THE ABOVE MAP IS A TRUE REPRESENTATION THEREOF AND SHOWS THE SIZE AND LOCATION OF THE PROPERTY, ITS EXTERIOR BOUNDARIES, THE LOCATION OF ALL VISIBLE STRUCTURES, AND DIMENSIONS OF ALL PRINCIPAL BUILDINGS THEREON, BOUNDARY SURVEY EASEMENTS, EASEMENTS, ROADWAYS, AND VARIOUS ENCROACHMENTS, IF ANY. THIS SURVEY IS MADE FOR THE USE OF THE PRESENT OWNERS OF THE PROPERTY, AND ALSO THOSE WHO PURCHASE, MORTGAGE, OR GUARANTEE THE TITLE THERETO WITHIN ONE YEAR FROM THE DATE HEREOF.

DATED: JULY 25, 2003


PETER S. GORDON

— WORK ORDERED BY —
PAT MCINTOSH
C/O PEGGY BENTLEY — KEEFE REAL ESTATE
751 GENEVA PARKWAY
LAKE GENEVA, WI. 53147

FARRIS, HANSEN & ASSOCIATES, INC.
ENGINEERING - ARCHITECTURE - SURVEYING
7 RIDGWAY COURT P.O. BOX 437
ELKHORN, WISCONSIN 53121
OFFICE: (262) 723-2098 FAX: (262) 723-5886

REVISIONS

PROJECT NO.

6004

DATE _____

07/25/0

SHEET NO.

SCTK-4

005-2119