


Geneva
Lake

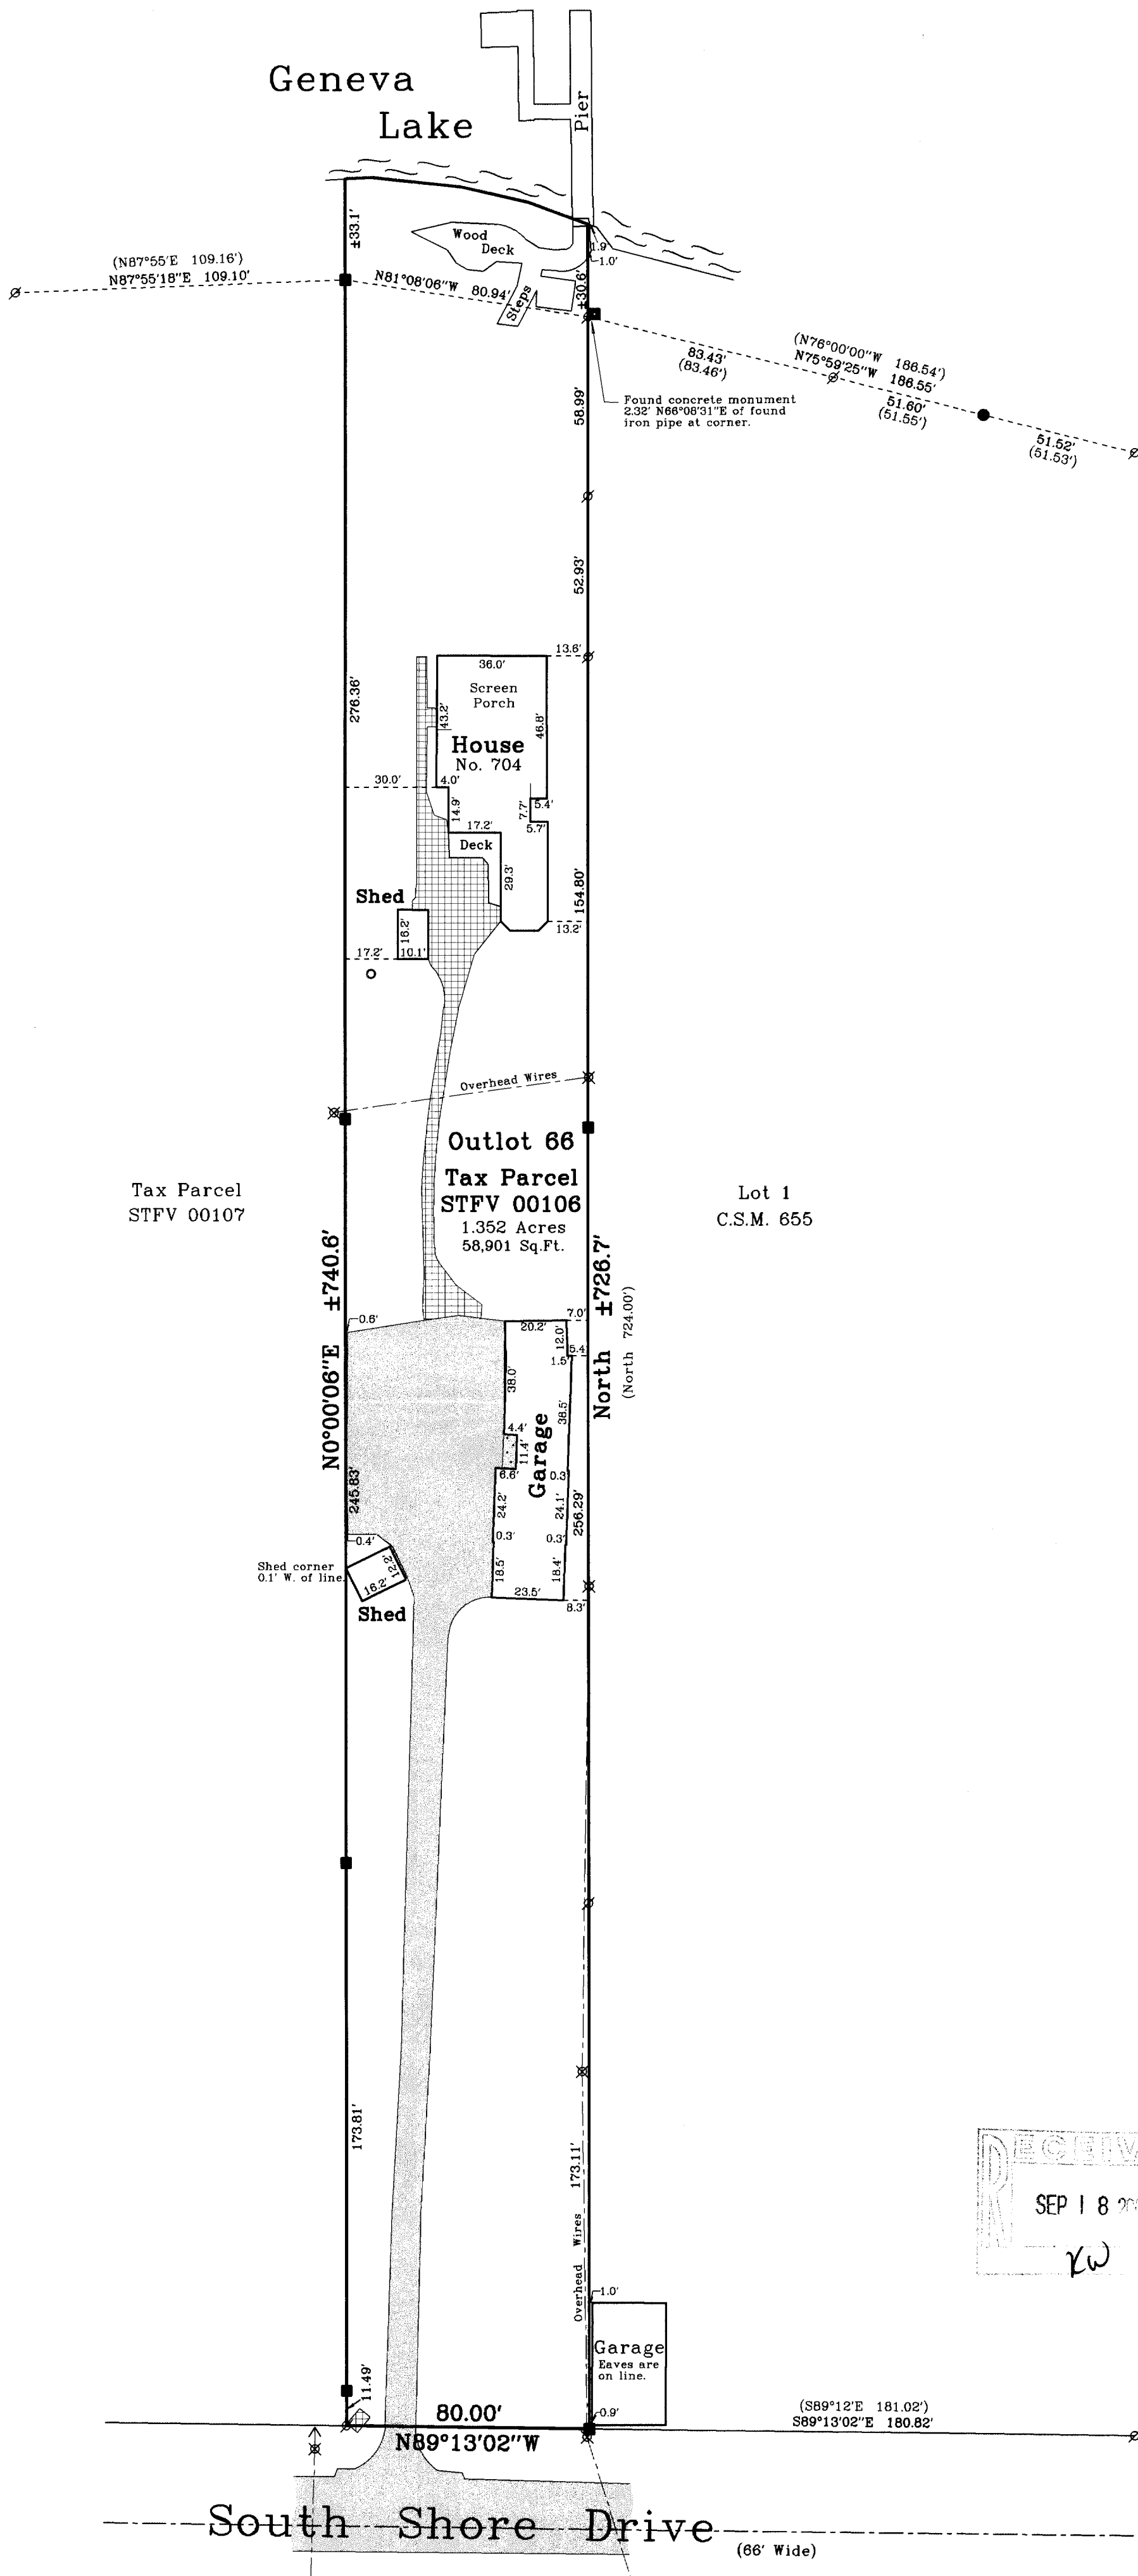

Plat of Survey

of


A parcel of land described in a Quit Claim Deed recorded in Vol. 643 on Page 6395 as Document No. 340693 as follows: The West 60 feet of the East 1 chain and 98-1/2 links of the West 1/2 of the NW fractional 1/4 of Section 13, T1N, R16E; also a strip of land 20 feet in width lying West of and adjoining said 1 chain and 98-1/2 links of the West 1/2 of the NW fractional 1/4 of Section 13 aforesaid; also known and described as Outlot 66 of the Assessor's plat of the Village of Fontana-on-Geneva Lake, as recorded in Volume 11 of Plats at page 16.

Surveyed for: **Ray Brosio**
704 South Lake Shore Drive
Fontana, Wisconsin. 53125


Tax Parcel
STFV 00107

Lot 1
C.S.M. 655


Outlot 66
Tax Parcel
STFV 00106
1.352 Acres
58,901 Sq.Ft.

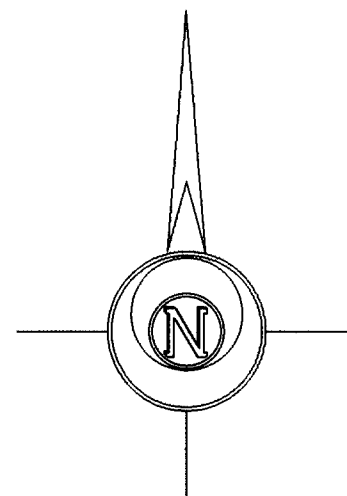

Bearings reference to Certified
Survey Map No. 655.

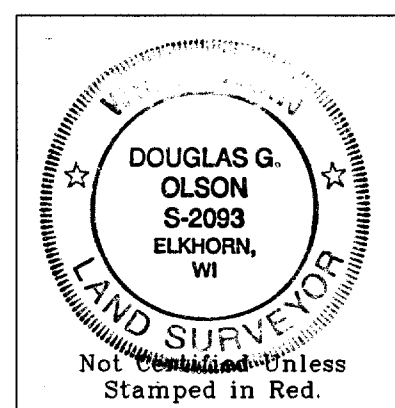

- Notes: 1) This survey plat is not certified unless signed and sealed in red ink.
- 2) This survey is subject to Wisconsin lien laws. This Plat of Survey is the notice of intent to file lien. Lien waiver required.

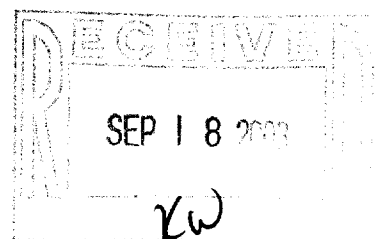

Copyright © 2003 by Jensen & Olson Land Surveying, LLC.

All rights reserved. No part of this survey plat may be reproduced or transmitted in any form by any means - graphic, electronic, or mechanical, including photocopying, tracing, or information storage and retrieval systems - without permission in writing from Douglas G. Olson, Jensen & Olson Land Surveying, LLC.

I, Douglas G. Olson, Wisconsin Registered Land Surveyor, do hereby certify that this survey was performed by me or under my direction in full compliance with the owner's/agent's instructions and Chapter A-E 7 of the Wisconsin Administrative Code "Minimum Standards for Property Surveys"; and that this map is an accurate representation thereof to the best of my knowledge and belief.

Douglas G. Olson
Wisconsin Registered Land Surveyor - 2093

Sheet 1 of 1 Sheets
Job Reference Number
2003.119

Legend
■ Found Concrete Monument
● Found Iron Pipe
○ Found Iron Rod
() Recorded Information
x Utility Pole
○ Catch Basin
Asphalt Surface
Concrete
Brick Pavers

Jensen & Olson Land Surveying, LLC

45 South Wisconsin Street P.O. Box 322
Elkhorn, Wisconsin. 53121
Telephone (262) 723-3434
Facsimile (262) 723-8044

Scale in Feet
1" = 40'
0' 20' 40' 80'

Survey Date: September 5, 2003
Revisions:

2003.119

STFV-106

005-2124