
ABELL SURVEYING & MAPPING

1140 SEQUOIA STREET • DELAVAN, WISCONSIN 53115 262-728-6737

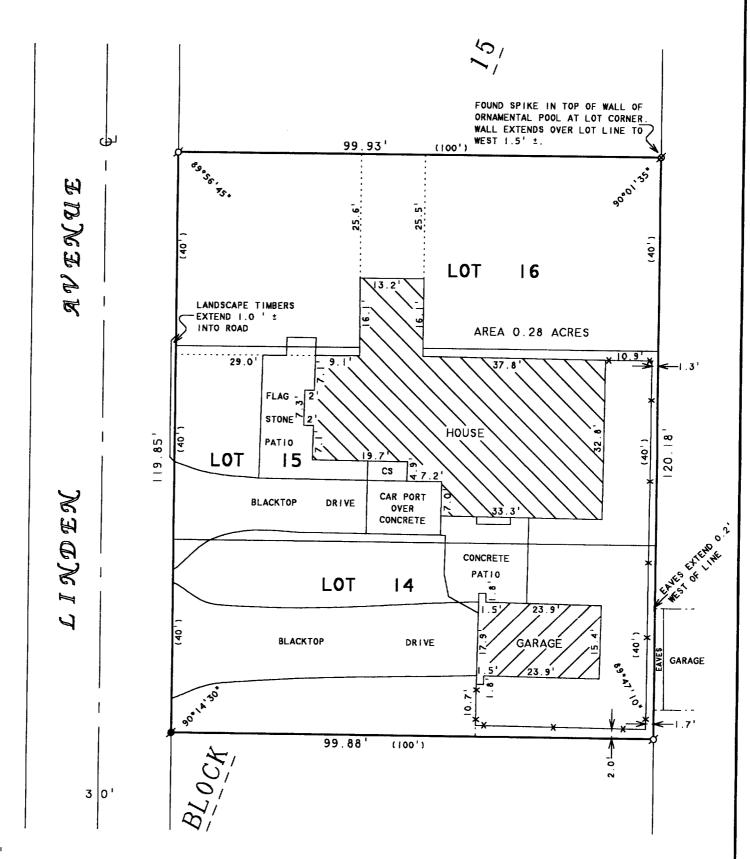

N

SCALE | " = 20"

LEGEND

Ø -IRON PIPE FOUND

Ø -IRON ROD FOUND

Ø -SPIKE FOUND

X -WOOD FENCE

CS -CONCRETE STOOP

[)-RECORDED AS

PLAT OF SURVEY OF

LOTS 14-16, BLOCK 15 OF GLENWOOD SPRINGS, LOCATED IN SECTION 14, TIN, RIGE, VILLAGE OF FONTANA-ON-GENEVA LAKE, WALWORTH COUNTY, WISCONSIN.

OCT - 3

ORDERED BY: ATTY. TIM SWATEK
ALLEN, HARRISON, WILLIAMS
McDONEL! & SWATEK. !!P

ALLEN. HARRISON, WILLIAMS
McDONELL & SWATEK, LLP
527 CENTER STREET
P.O. BOX 760
LAKE GENEVA W! 53147

I HEREBY CERTIFY THAT I HAVE SURVEYED THE ABOVE DESCRIBED PROPERTY AND THAT THE ABOVE MAP IS A TRUE REPRESENTATION THEREOF AND SHOWS THE SIZE AND LOCATION OF THE PROPERTY. ITS EXTERIOR BOUNDARIES. THE LOCATION OF ALL VISIBLE STRUCTURES AND DIMENSIONS OF ALL PRINCIPAL BUILDINGS THEREON. BOUNDARY FENCES. APPARENT EASEMENTS. ROADWAYS AND VISIBLE ENCROACHMENTS. IF ANY, TO THE BEST OF MY KNOWLEDGE AND BELIEF.

THIS SURVEY IS MADE FOR THE USE OF THE PRESENT OWNERS OF THE PROPERTY, AND ALSO THOSE WHO PURCHASE, MORTGAGE, OR GUARANTEE THE TITLE THERETO WITHIN ONE (I) YEAR FROM DATE HEREON.

DAVID F. ABELL WISCONSIN REGISTERED LAND SURVEYOR. S-1596

July 25, 2003

DATE JOB NUMBER - 88099A NOTE: THIS IS NOT A CERTIFIED COPY UNLESS SEALED.

565-105 565-106 565-107