
PREPARED FOR: KATIE CORDS

## PLAT OF SURVEY

- OF -

LOT 11, BLOCK "H", COUNTY CLUB ESTATES SUBDIVISION, UNIT NO. 3, LYING AND BEING ON THE VILLAGE OF FONTANA, COUNTY OF WALWORTH, AND STATE OF WISCONSIN.

J.K. SURVEYING INC. N3705 WILLOWBEND LANE LAKE GENEVA, WI, 53147 262-248-3697

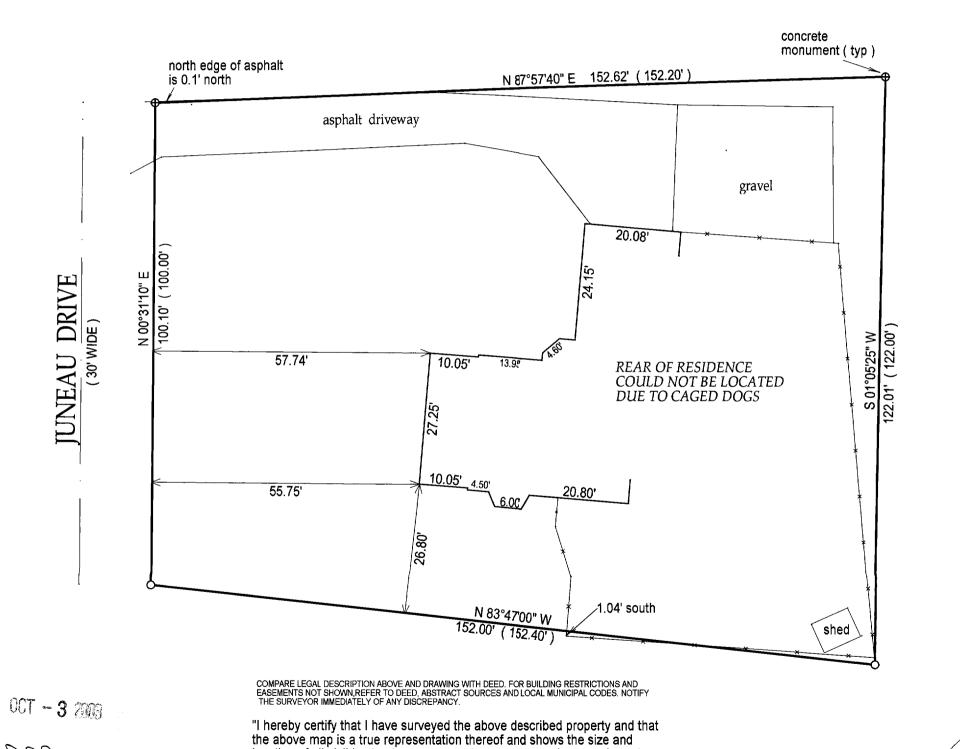

location of all visible structures, apparent easements and encroachments

This survey is made for the present owners of the property, and those who

DATED THIS 18 TH, DAY OF JUNE 20 03 .

purchase, mortgage, or guarantee the title thereto, within one year from

the date hereof.

JEFFERY L

KIMPS

2436

LAKE GENEVA,

WIS.

OSURVE

JEFFREY L KIMPS S-2436 Wisconsin Registered Land Surveyor ( original if signed in red )

( )= recorded as□ = found iron bar

= set iron pipe

= set iron bar

SCALE 1" = 20'

JOB # 03-354

= found iron pipe

503-125

D88