
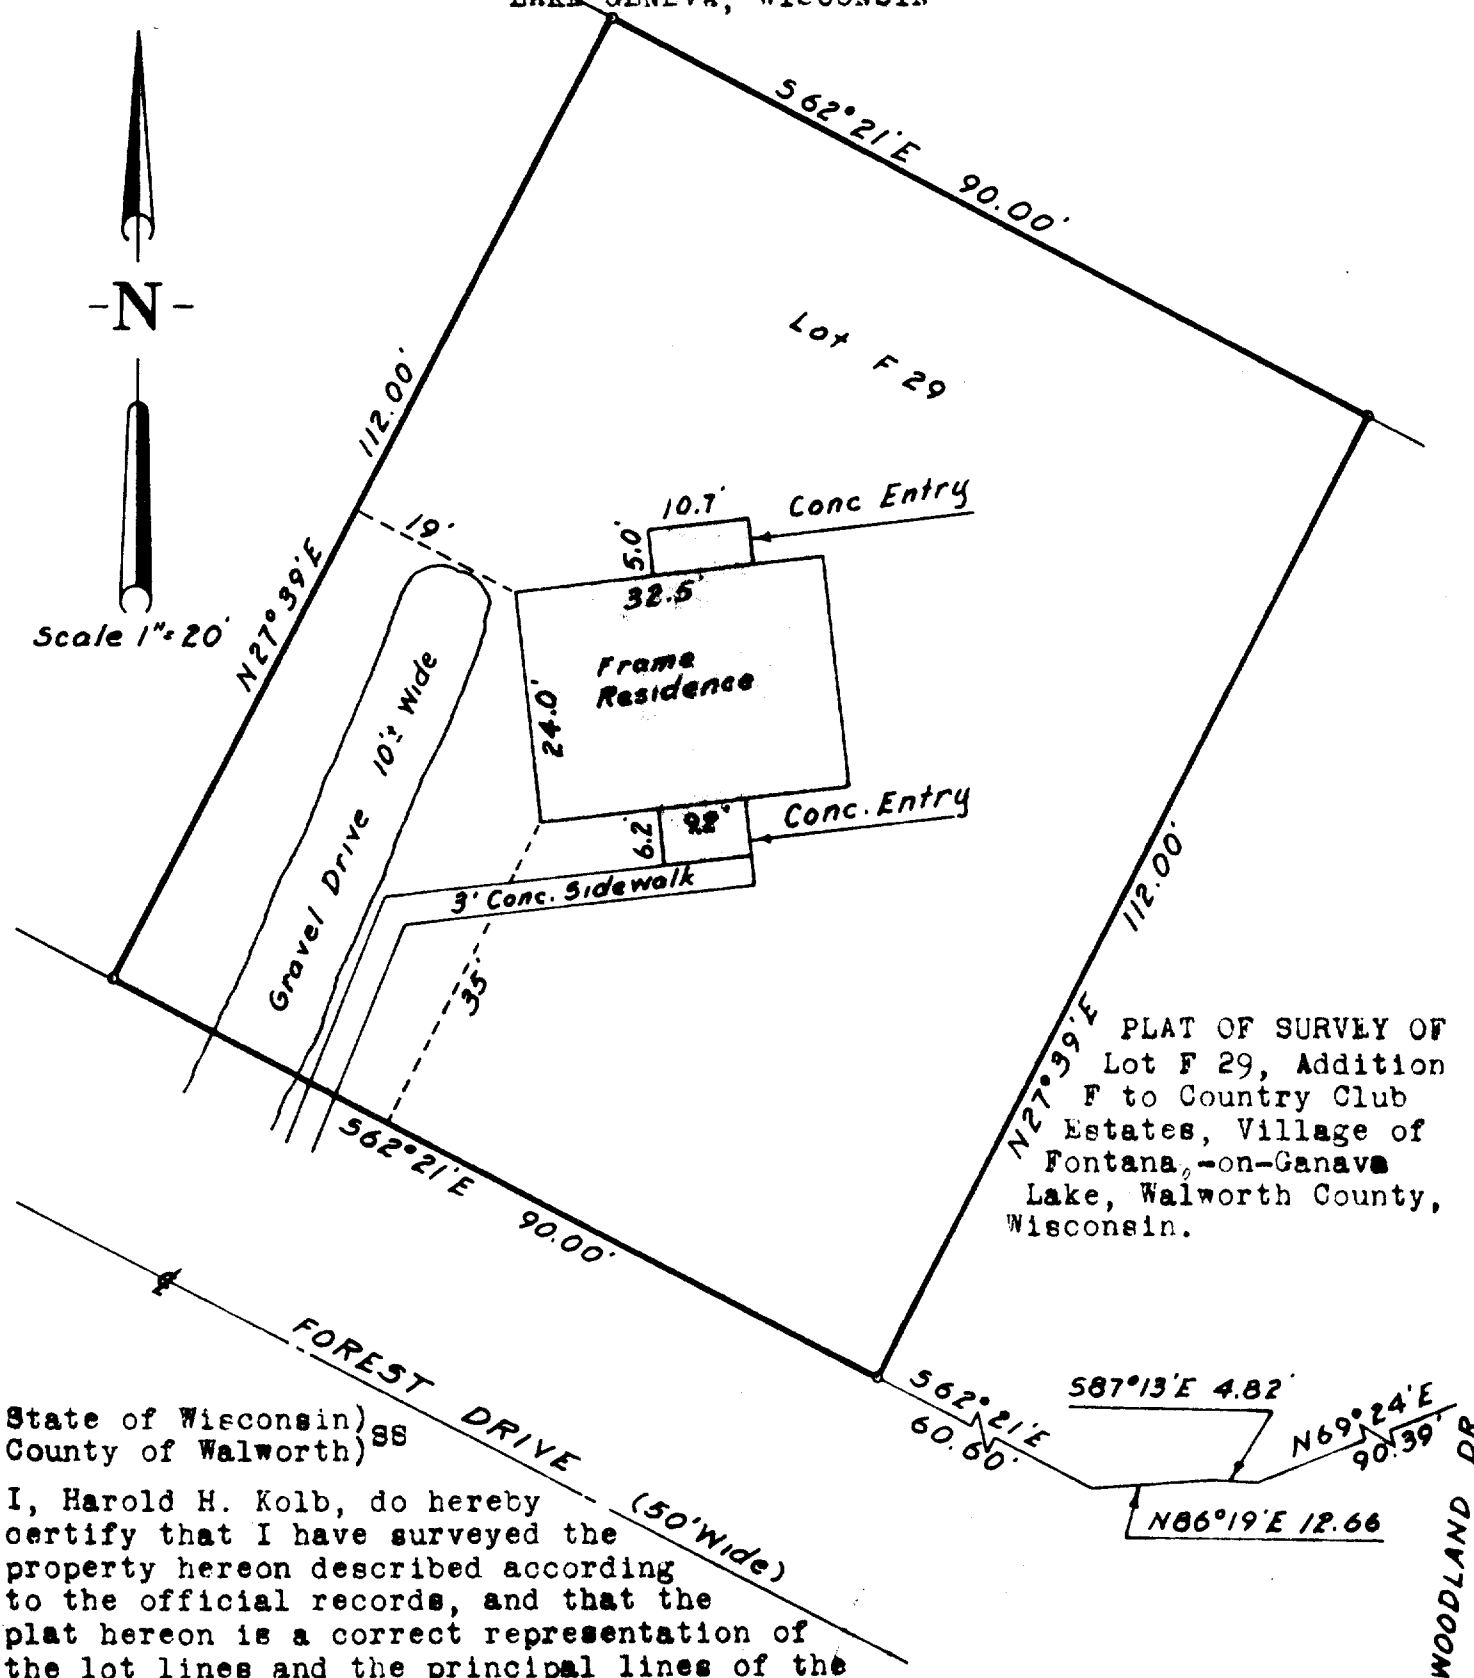


HA ROLD H. KOLB
REGISTERED PROFESSIONAL LAND SURVLYOR
LAKE GENEVA, WISCONSIN

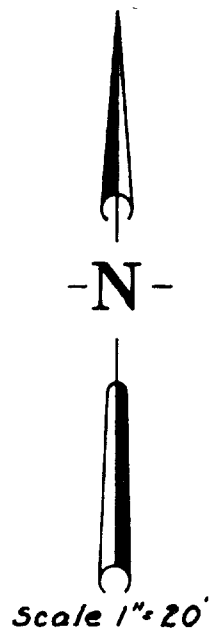

PLAT OF SURVEY OF
Lot F 29, Addition
F to Country Club
Estates, Village of
Fontana, -on-Ganava
Lake, Walworth County,
Wisconsin.

State of Wisconsin) ss
County of Walworth)

I, Harold H. Kolb, do hereby
certify that I have surveyed the
property hereon described according
to the official records, and that the
plat hereon is a correct representation of
the lot lines and the principal lines of the
buildings thereon.

Harold H. Kolb

Harold H. Kolb, Wisconsin Surveyor, S-187
DATE: October 3, 1963

5-214

o - Iron Pipe Found