

**ABERNATHY and ASSOCIATES**


Kenneth B. Abernathy Jr.

Wisconsin Registered Land Surveyor S-1594


W4058 BRAY RD.  
ELKHORN, WI. 53121  
PHONE: (262) 723-4260 (OFFICE)  
(262) 723-7209 (FAX)  
Email: abernathy@elknet.net

**PLAT OF SURVEY**

LOTS 1 AND 2 COUNTRY CLUB ESTATES  
ADD. A LOCATED IN THE VILLAGE  
OF FONTANA-ON-GENEVA LAKE,  
WALWORTH COUNTY, WISCONSIN.

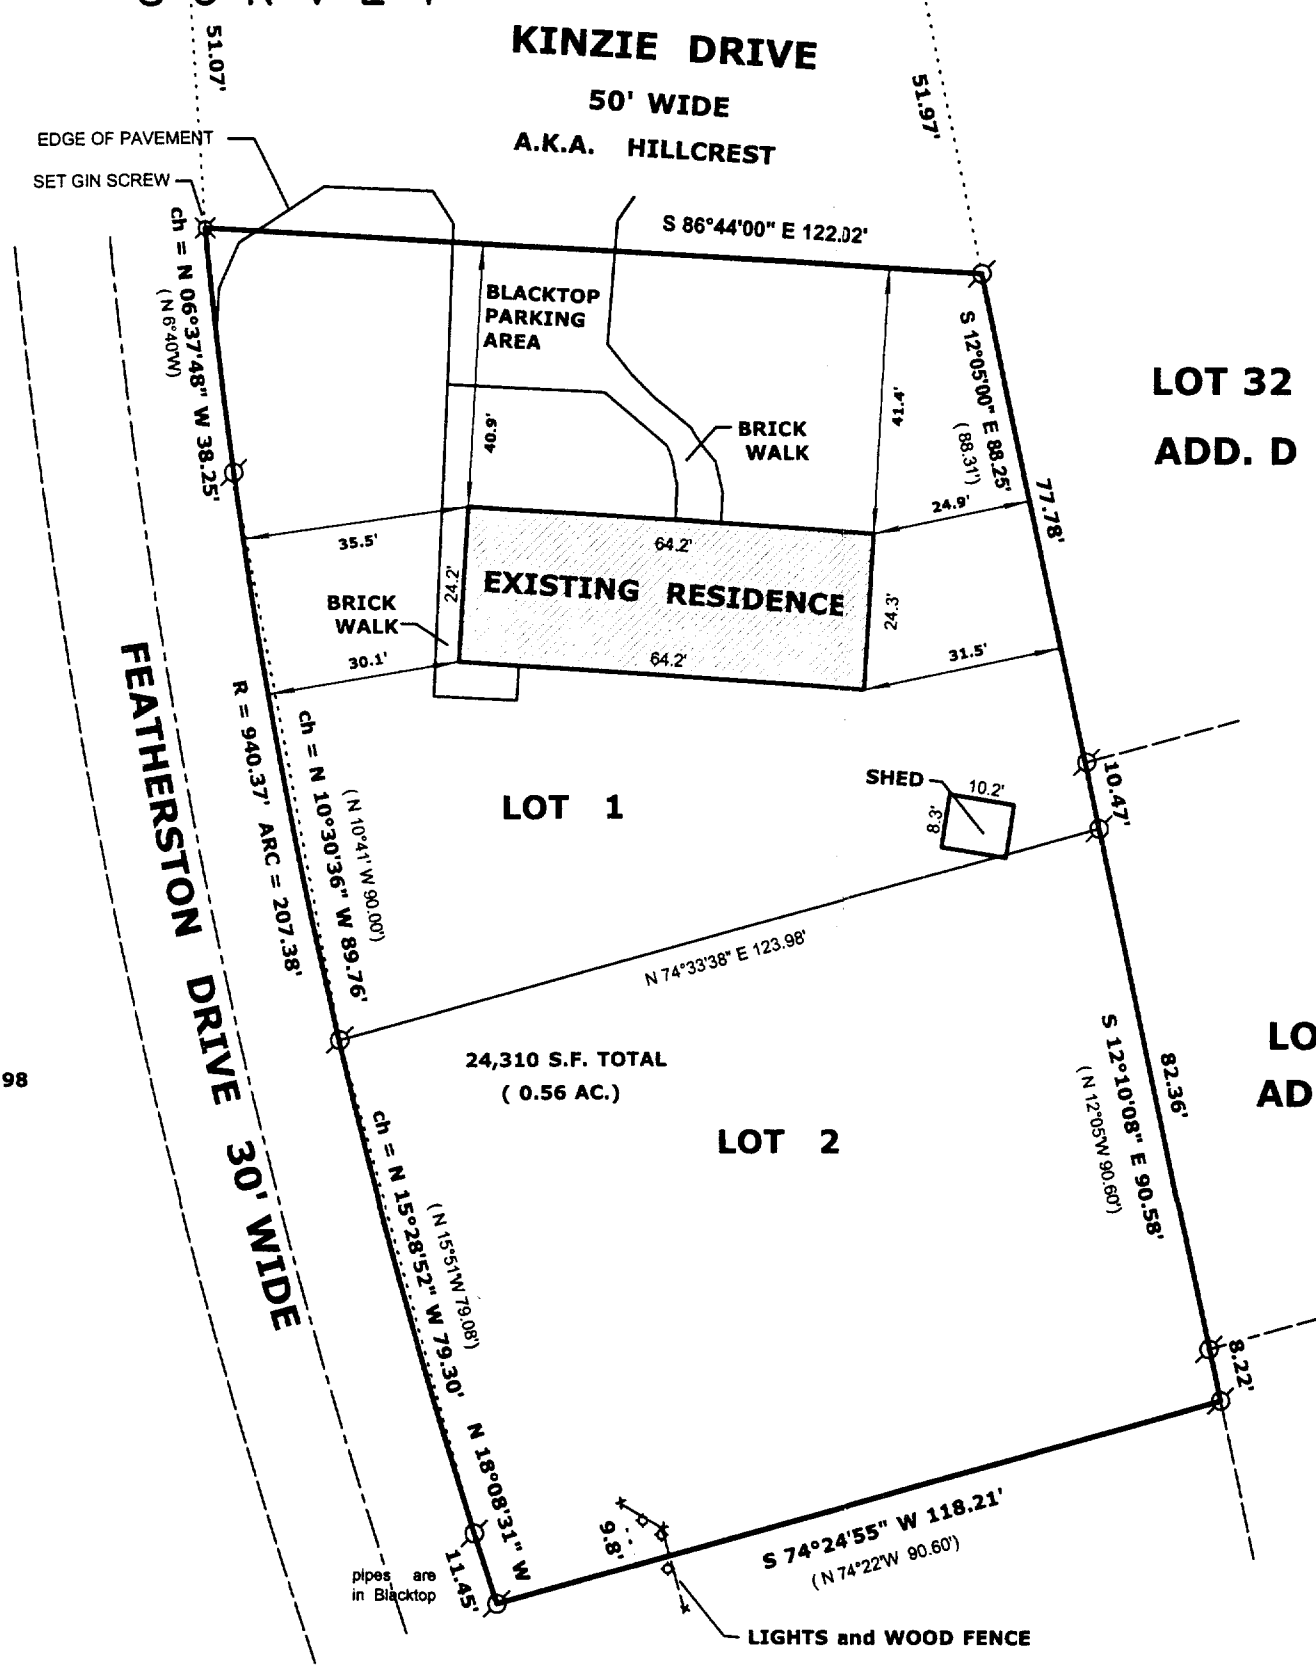


- Legend**
- ⊙ FOUND IRON PIPE
  - FOUND IRON ROD
  - ⊠ FOUND BRASS CAPPED MONUMENT
  - FOUND CONCRETE MONUMENT
  - + CHISEL CUT IN CONCRETE
  - SET IRON ROD, 24" LONG, WEIGHING 1.5 LBS./LINEAL FT., 3/4" DIA.
  - SET IRON ROD, 30" LONG, WEIGHING 4.5 LBS./LINEAL FT., 1-11/16" DIA.
  - ( x x ) RECORDED AS DIMENSION
  - x-x-x- EXISTING FENCE

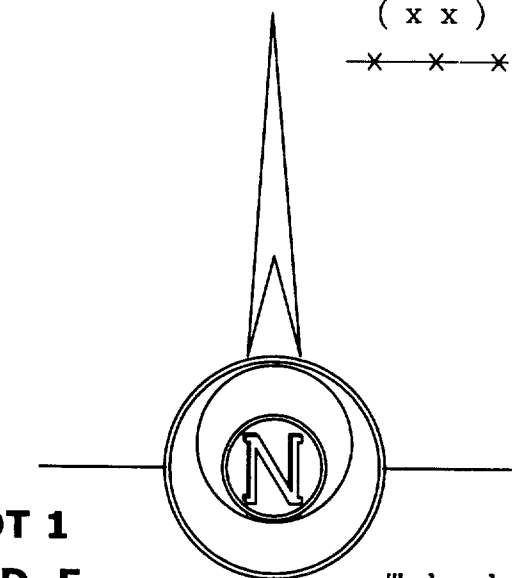

SCALE: 1" = 30 FEET

"I hereby certify that the above described property has been surveyed by me or under my direction and that the above map is a true representation thereof and shows the size and location of the property, its exterior boundaries, the location of all visible structures and dimensions of all principal buildings thereon, boundary fences, apparent easements, roadways and visible encroachments, if any."  
"This survey is made for the use of the present owners of the property, and also those who purchase, mortgage, or guarantee the title thereto within one year from the date hereof."

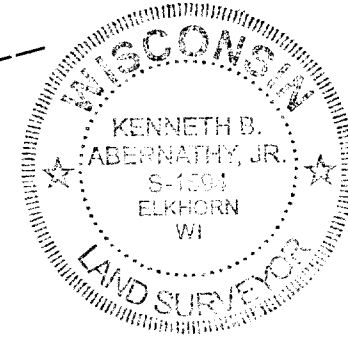

*Kenneth B. Abernathy, Jr.*

**KENNETH B. ABERNATHY, JR.**  
WISCONSIN REGISTERED LAND SURVEYOR,  
S-1594

Date: OCT. 20, 2003 Job No. 03.1006

OWNER: ORVILLE F. GENZ TRUST DATED JUNE 3rd, 1998  
403 HILLCREST,  
FONTANA, WI. 53125

523  
DRR

SCTA-1  
SCTA-2

005-2154