

# FARRIS, HANSEN & ASSOCIATES, INC.

ENGINEERING — ARCHITECTURE — SURVEYING

7 RIDGWAY COURT — P.O. BOX 437 — ELKHORN, WISCONSIN 53121

PHONE: (262) 723-2098 FAX: (262) 723-5886

## PLAT OF SURVEY

LOT 97 OF COUNTRY CLUB ESTATES UNIT 2



LOCATED IN SECTIONS 14 & 23, TOWN 1 NORTH,  
RANGE 16 EAST, VILLAGE OF FONTAN-ON-GENEVA LAKE,  
WALWORTH COUNTY, WISCONSIN

— WORK ORDERED BY —  
ANDY PEARCE — PEARCE & SON, INC.  
W7037 BRICK CHURCH ROAD  
WALWORTH, WI 53184

## MAYFLOWER DRIVE

50' WIDE R.O.W.

ASSIGNED SOUTH LINE OF  
MAYFLOWER DRIVE  
N 89°10'16" E

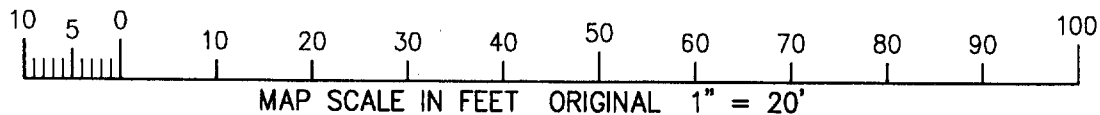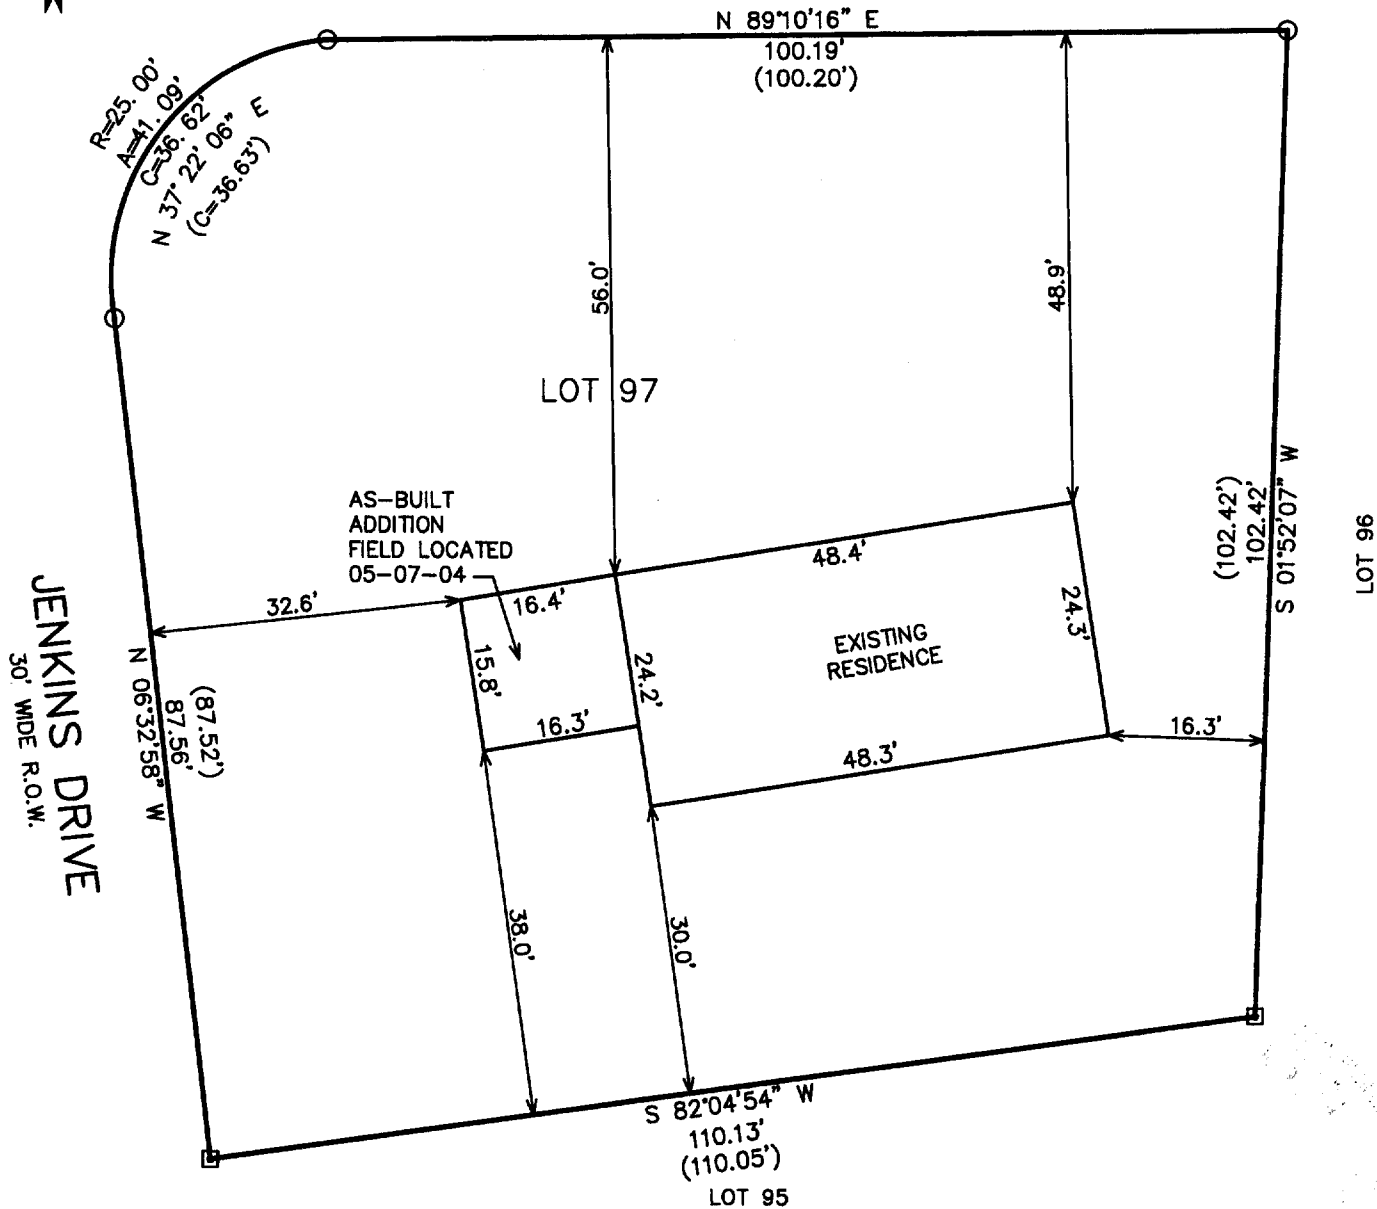

NOTE: COPIES OF THIS MAP TO WHICH THE FOLLOWING CERTIFICATE WILL APPLY SHOW THE SURVEYOR'S ORIGINAL SEAL AND SIGNATURE IN RED INK. COPIES BY ANY OTHER MEANS MAY HAVE ALTERATIONS WHICH DO NOT REPRESENT THE SURVEYOR'S WORK PRODUCT.

I HEREBY CERTIFY THAT THE ABOVE DESCRIBED PROPERTY HAS BEEN SURVEYED UNDER MY DIRECTION AND THAT THE ABOVE MAP IS A TRUE REPRESENTATION THEREOF AND SHOWS THE SIZE AND LOCATION OF THE PROPERTY AND ITS EXTERIOR BOUNDARIES. THIS SURVEY IS MADE FOR THE USE OF THE PRESENT OWNERS OF THE PROPERTY, AND ALSO THOSE WHO PURCHASE, MORTGAGE, OR GUARANTEE THE TITLE THERETO WITHIN ONE YEAR FROM THE DATE HEREOF.

DATED: MAY 10, 2004

*Peter S. Gordon*  
PETER S. GORDON R.L.S. 2101

### LEGEND

- = FOUND IRON PIPE STAKE
- = FOUND CONCRETE MONUMENT
- (XXX) = RECORDED AS

PROJECT NO. 6558  
DATED: 05-10-2004  
SHEET 1 OF 1 SHEETS

SC02 00091  
SC02 00091A

3016

KW

005-2176